
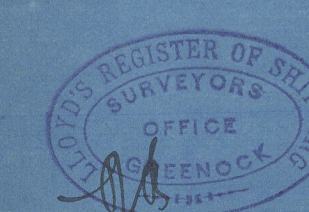


SECTION OF BOTTOM GUARD
SCALE 3" = 1' FOOT

26/10/17
(717) 27-12-17
(723) 6/2/18.
(726) 25/4/18.
(728) 15/12/18
(729) 17-7-19.

OVERALL LENGTH 35'-7"

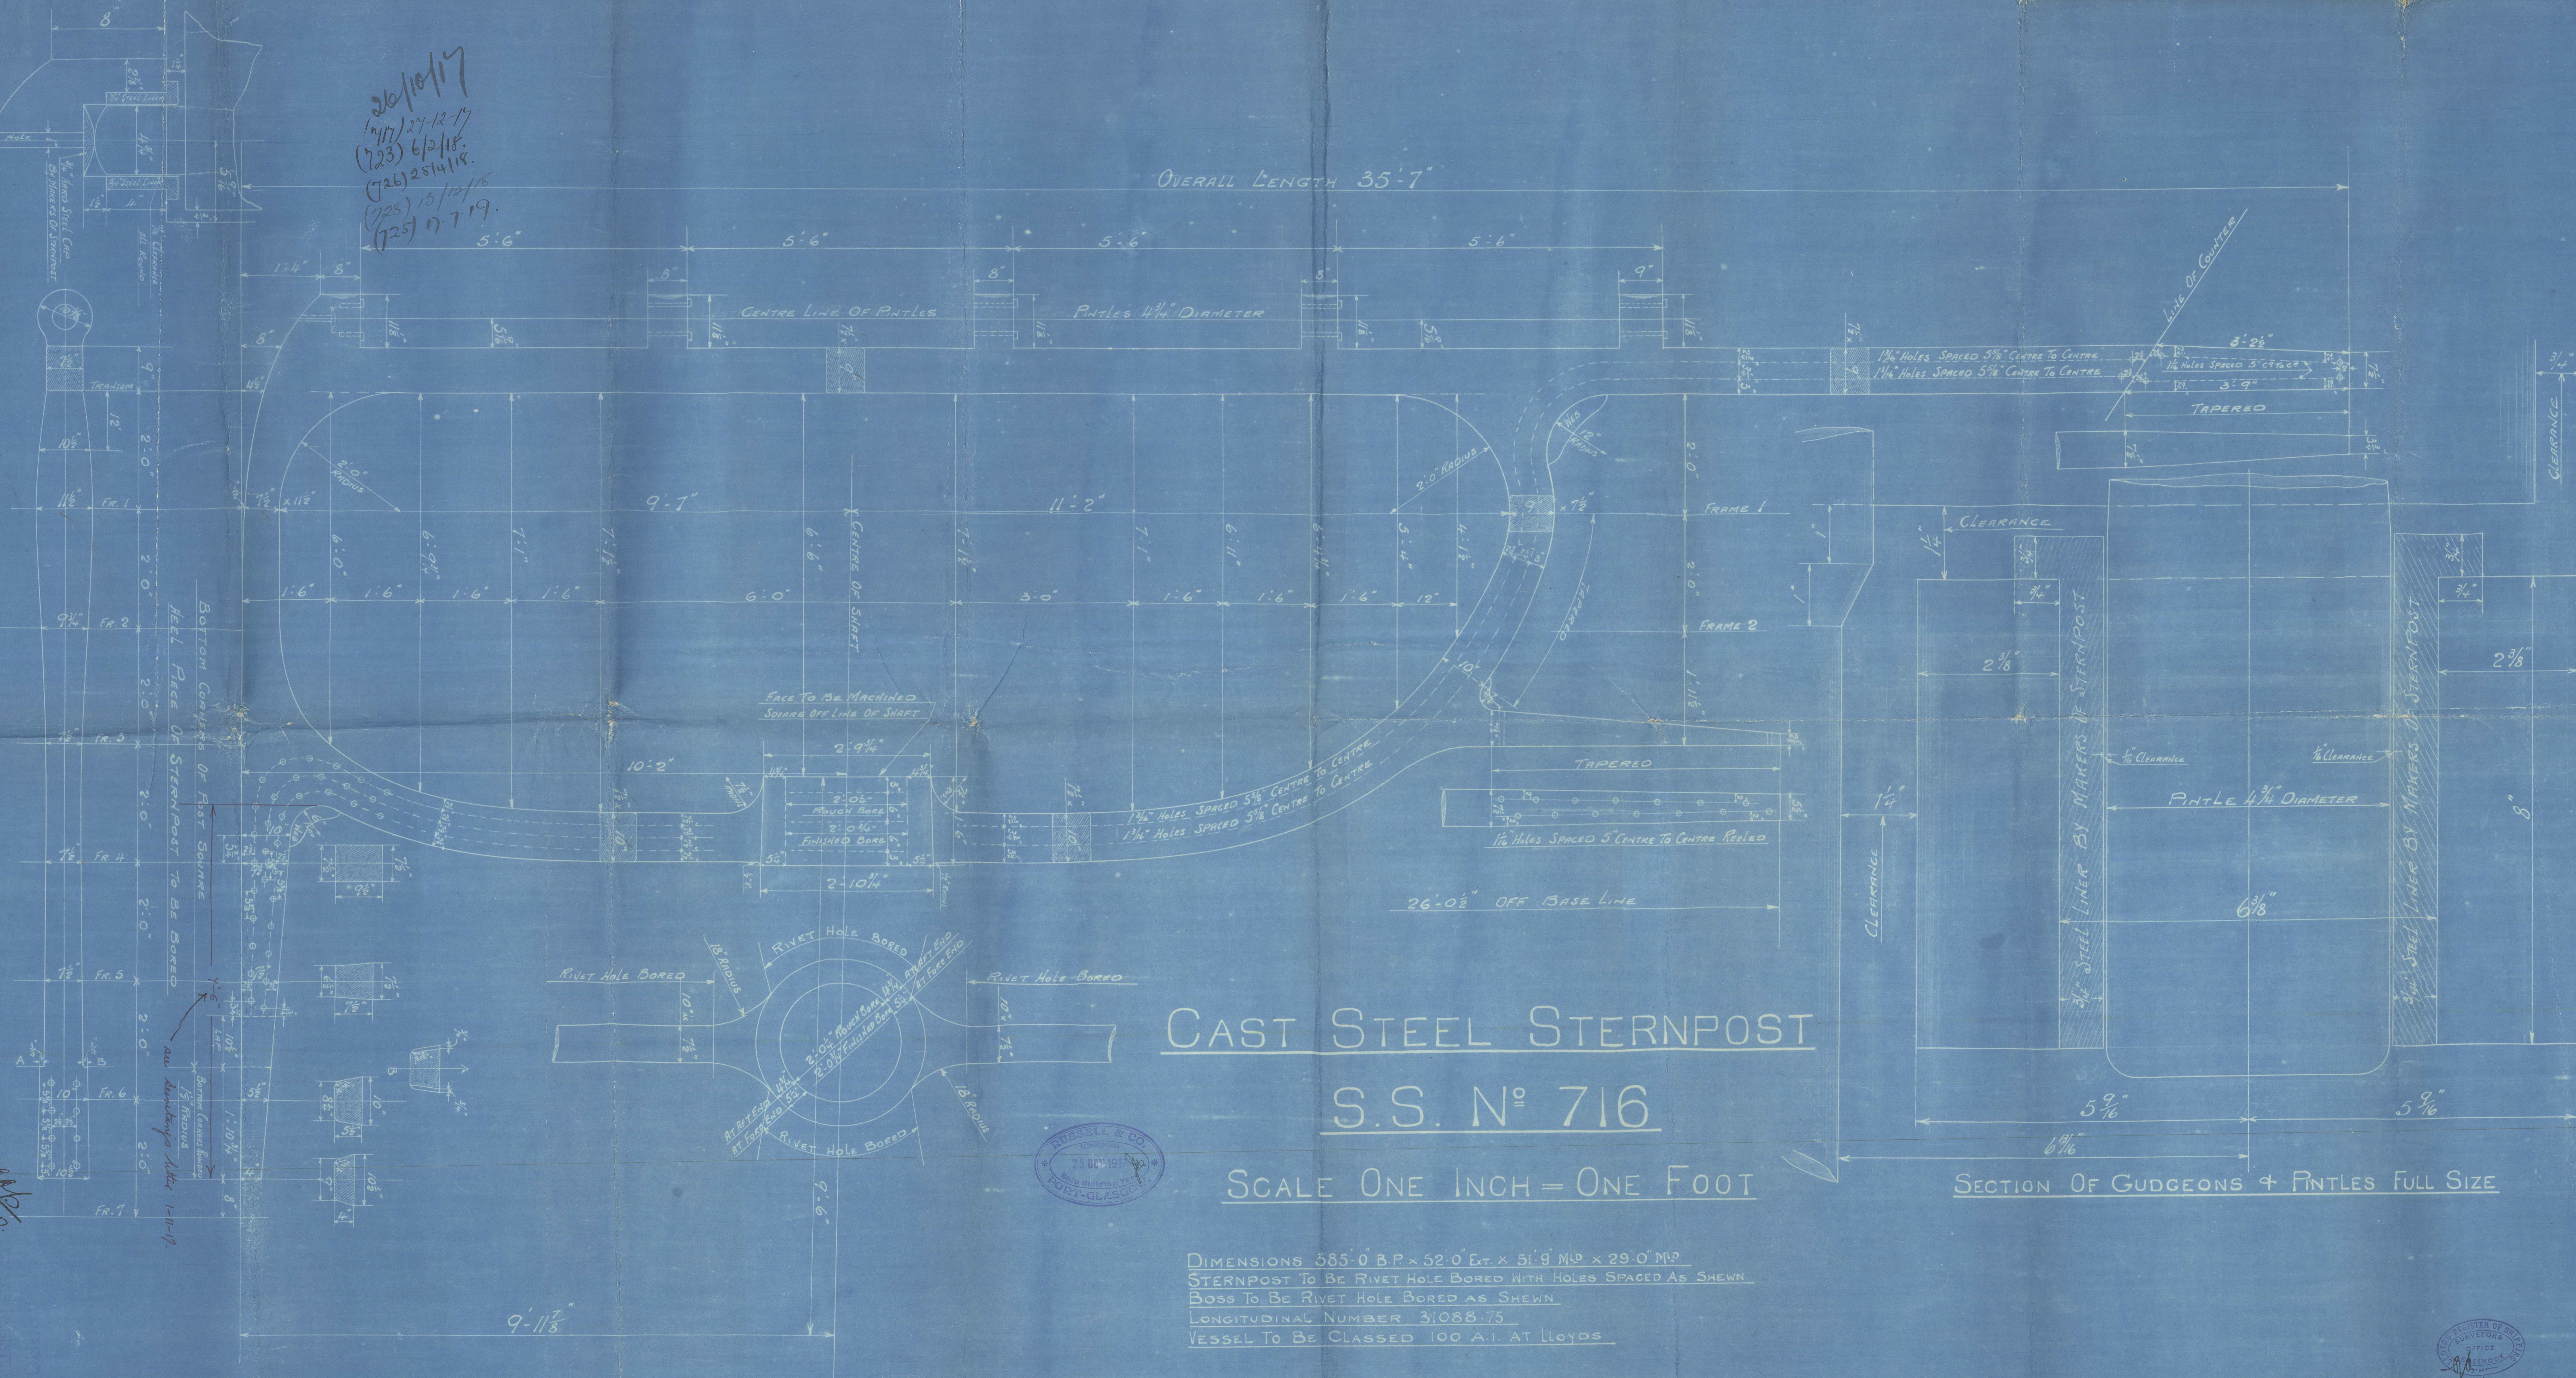

725. 1/2 "Maudie"

GREENOOK Report No. 17706

728 1/2 "Clan Macindoe"

GREENOOK Report No. 17765

737 3/5 "Clan Fraser"

York Rpt No 17838

734. 1/2 "Dunstafnage"

GREENOOK Report No. 18023

735. 1/2 "Trafalgar"

GREENOOK Report No. 18163




© 2020

Lloyd's Register
Foundation

007698-007706-0153


last but stern name

Russell, Co 88 1716

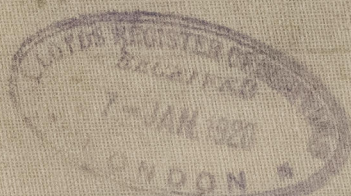


S/F

717
4723
+ 726

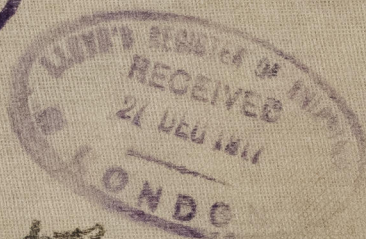

716 ^{meadows} _W Crosshill

brk plc apt

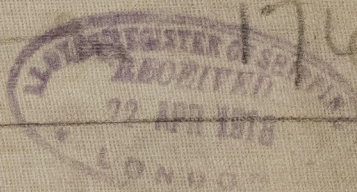

727
728
729
730
731
732
733
734
735

717 Salty more

brk plc apt



723 Saint

brk plc apt


Austral

17493

Bede

726 Kastalia

brk plc apt

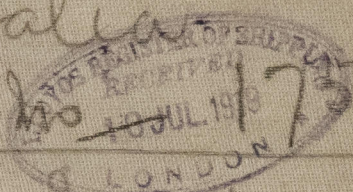

7349

727 Blan

brk plc apt



17588

Lloyd's Register Foundation