


HOLES IN STERN FRAME  $1\frac{3}{16}$ " SPACED  $5\frac{5}{8}$ " C<sup>RS</sup> FOR  $1\frac{1}{8}$ " RIVETS.

NOTE:- ALL GUDGEONS TO  
THIS SKETCH.

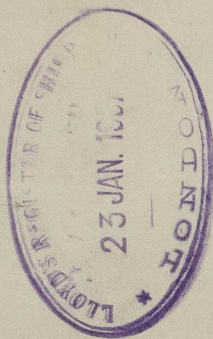



Messrs John Blum & Co

7th 193

Cart Steel ~~Reinforcing~~ *Stem frame*

S.S. "HOLYWOOD"

Sld. F. & Nos 28122

007707-007713-0154



© 2020

Lloyd's Register  
Foundation