
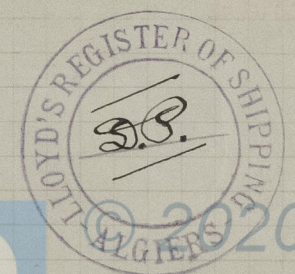
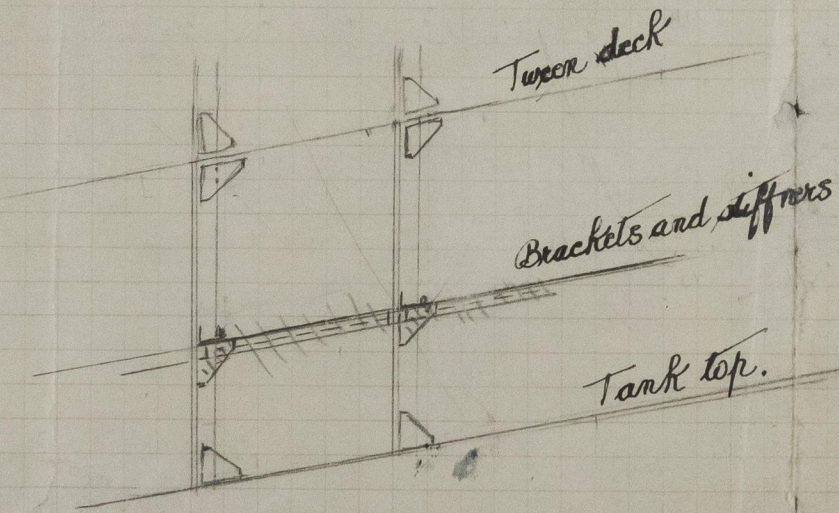


S/S. "Nicole Schiaffino"

Cut the forward bulkheads in vegetable Oil Tanks in No 2 Hold and Tween Deck.
 Cut the fore and aft bulkheads in vegetable Oil Tanks in 2 Hold Tween Deck and Cross Bunker.
 Cut the four stays Hull to bulkhead in the vegetable oil tanks.
 Cut all the brackets and angles to bulkhead unless the top and bottom.
 In alleged red ink what has been done (already approved at Marseilles) is marked.

S.B.

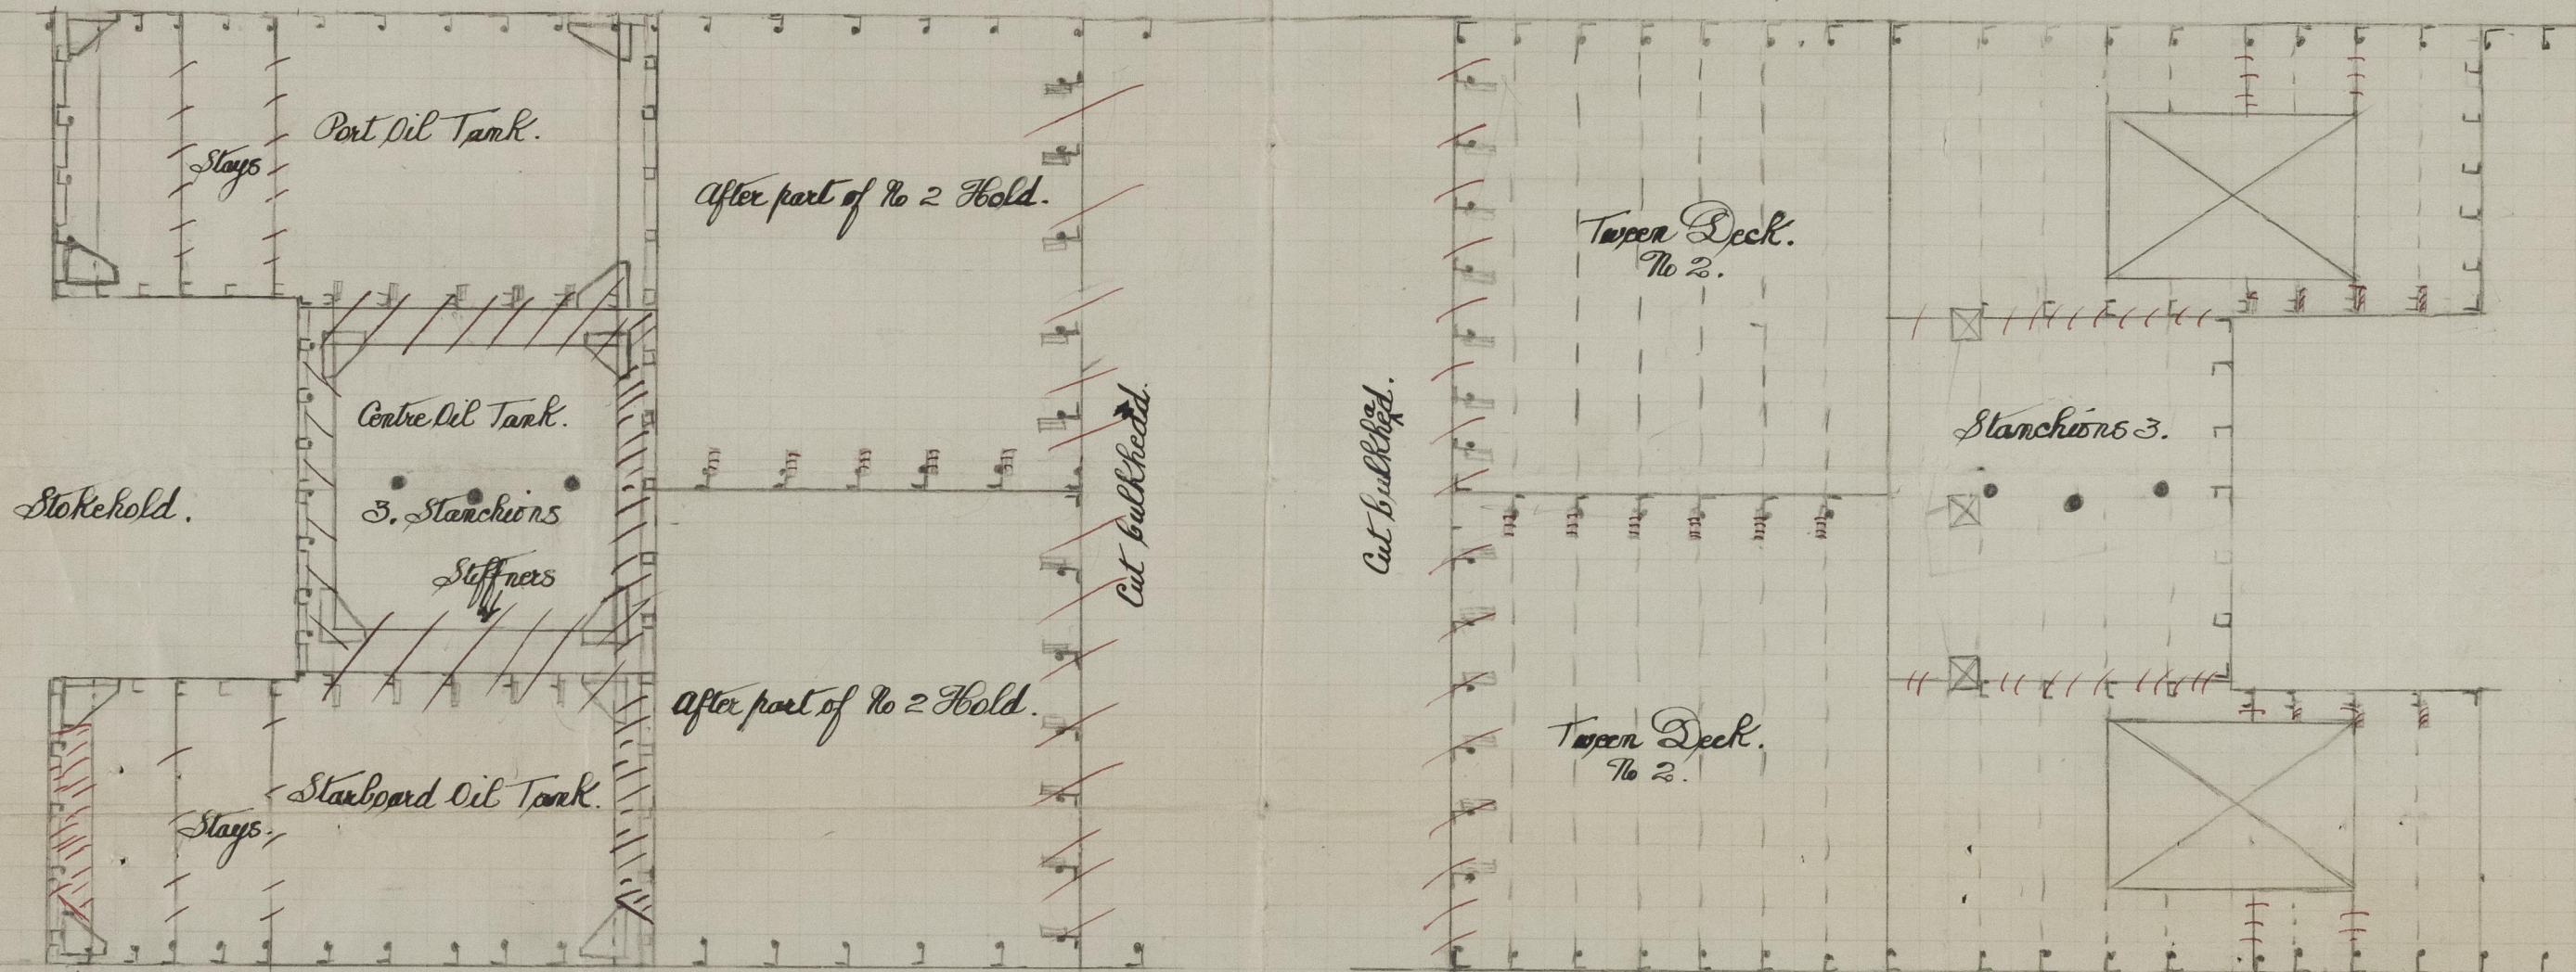

Lloyd's Register Foundation

File with Alge
No. 1515

