

Not 20/10/32
accus 26052

Lloyd's Register of Shipping.

SURVEYS FOR FREEBOARD.—STEAM SHIPS.

REMARKS RELATING TO ALL STEAM SHIPS EITHER FLUSH DECKED, OR WITH
OF GALLANT FORECASTLES, SHORT POOPS AND BRIDGE HOUSES DISCONNECTED, OR
WITH TOP GALLANT FORECASTLES HAVING LONG POOPS, OR RAISED QUARTER DECKS
CONNECTED WITH BRIDGE HOUSES, OR OTHERWISE.

NEWCASTLE-ON-TYNE
Port of Survey
Date of Survey 23rd Sept 1920
Name of Surveyor *G. Brown*

MURTON
PALMERS
Ship's Name
ex "SILENE"
Number in Register Book 72270

Port of Registry and Nationality.
ROUEN
(French)

Official Number.
148699

Gross Tonnage.
42

Date of Build.
1920

Particulars of Classification.
+ 100A1 contemplated

| | | | | |
|---|-------------------------|---|--|---------------------------------------|
| Registered dimensions from Ship's Register. | LENGTH. <i>386.1</i> | BREADTH. <i>52.6</i> | DEPTH. <i>26.3</i> | UNDER DECK TONNAGE. <i>4079.46</i> |
| Length on LOADLINE. | <i>385.6</i> | Frame Depth Rule <i>9</i> <i>3x2 = .5</i> | Ceiling Sheer <i>laid</i> <i>-19</i> <i>spar ceiling fitted</i> <i>and tanks</i> | Peak Tanks } <i>incl'd</i> |
| CORRECTED DIMENSIONS. | <i>385.6</i> | <i>52.1</i> | <i>26.11</i> | <i>4079.46</i> |

Moulded Depth as measured..... *28'-6"*
Addition for Keel below base line for draught record..... *2 1/2* inches.

NOTE.— If the depth is measured when vessel is afloat, the details of measurement should be reported.

CORRECTION FOR LENGTH.

| | |
|---------------------------------------|----------------------------|
| Length of Ship on Loadline..... | <i>385.6</i> |
| Length in Table | <i>342.0</i> |
| Difference | <i>43.6</i> |
| Correction for 10ft., Table A. | <i>1.5</i> |
| × Difference divided by 10 | <i>6.54</i> (if required.) |
| If 1/10ths length covered divide by 2 | <i>3.27 + 3/4</i> |

Co-efficient of fineness..... *.78*
Any modification necessary [Para. 4 (a) to (e)]* } *COR = .02*
Co-efficient as corrected *.76*

CORRECTION FOR IRON DECK.
Proportion covered, if less than 1/10ths length covered *.604*
Thickness of usual wood deck, less stringer *3 1/2 - 2"*

Sheer { Stem..... *8'-0"* } *11'-0" ÷ 2 = 5'-6"* Mean
at { Sternpost ... *3'-0"* }
Sheer at 1/2 of the length from { Stem *3'-2 1/2"* } *3'-11" ÷ 2 = 1'-11 1/2"* Mean
Sternpost *8 1/2"*
Gradual mean Sheer *Plotted 41.55*
Standard mean Sheer [Table, Para. 18] *48.56* Correction
Difference..... *7.01 ÷ 4 = 1.75*
§ If limited as Para. 18 (f) *+ 1 3/4*
see particulars of sheer on back of report

CORRECTION FOR ROUND OF BEAM.
Breadth at Gunwale amidships..... *52.3*
Round of Beam *13 1/4*
Normal round..... *13.07*
Difference *.18 ÷ 2 = .09*
Proportion of Deck uncovered (Para. 19)

NOTE.— The round of beam should be reported on the full breadth of vessel at the gunwale.

Rise in Sheer { At front of bridge house..... }
from amidships { }
[Para. 18 (e)] { At after end of forecastle }
Fall in Sheer { }
Para. 18 (d) { }
Length uncovered Correction

Freeboard, Table A *6'-11"*
Correction for Sheer *+ 1 3/4*
Correction for Length *7'-0 3/4*
Allowance for Deck Erections *+ 3 1/4*
Correction for Round of Beam..... *7'-4"*
Correction for fall in Sheer (if any)..... *7'-7 1/4*
Correction for Iron Deck (if required) *1'-3 3/4*
Additions for non-compliance with provisions of Para. 11 (d) and (e) † *6'-0 1/4"*
Other Corrections (if any)

ALLOWANCE FOR DECK ERECTIONS:—
Freeboard, Table C..... *3'-9 1/2"*
Correction for Length, if required (Para. 12, 13, and 14)
Freeboard by Table A, corrected for sheer, and for length, if required (Para. 12, 13, and 14) } *7'-0 3/4"*
Difference *3'-3 3/4"*
Percentage as below..... *40.4%*
15.86

Correction for R. Q. Dk. if engine and boiler openings not covered by bridge house (Para. 11) }
Allowance for Deck Erections *1'-3 3/4"*

| | Length. | Length allowed. | Height. |
|--|-------------------|-------------------|----------------------|
| Forecastle..... | <i>42'-1 1/2"</i> | <i>42'-1 1/2"</i> | <i>7'-8" - 7'-3"</i> |
| Bridge House..... | <i>21'-3"</i> | <i>21'-3"</i> | <i>8'-0"</i> |
| † Raised Qr. Dk..... | <i>21'-3"</i> | <i>21'-3"</i> | <i>8'-0"</i> |
| Poop..... | <i>35'-9"</i> | <i>35'-9"</i> | <i>8'-0"</i> |
| Total | | <i>233</i> | <i>= .604</i> |
| Length of Ship | | <i>385.6</i> | |
| Corresponding percentage (Para. 11, 12, 13, or 14) | | <i>40.4</i> | |

Winter Freeboard *5'-10 1/4"*
Summer Freeboard *5'-5 1/2"*
Indian Summer Freeboard *5'-0 1/4"*
N. A. Winter Freeboard
Correction necessary because clearside amidships, measured in accordance with the Statute is not taken at the intersection of the wood or iron deck with side. } *1 3/4"*
Winter Freeboard from deck line *6'-0"*
Summer " " " *5'-7"*
Indian Summer " " " *5'-2"*
N. A. Winter " " "
..... *5'-7"*
..... *6"*
..... *5"*

FREEBOARD recommended amidships from centre of Disc to top of Statutory Deck Line, Wood (Iron) Deck:—
Fresh Water Line above centre of Disc
Indian Summer Line " " "
Winter Line below " " "
Winter North Atlantic Line " " "

MARKING FORM
RECEIVED 5-OCT 1925

† If the frames, skin planking, or ceiling are of unusual thickness the breadth of vessel to inside of ceiling should be reported if possible.
‡ In vessels obtaining an allowance for deck erections under Para. 11 where the sheer drops abaft amidships the height of the R. Q. D. is to be taken from the level of the top of the amidship beam.
§ In flush-decked vessels the total standard mean sheer means the sheer measured at the stem and stern-post. In vessels having poops and forecastles, it means the sheer measured at points distant one-eighth of the vessel's length from stem and stern-post.

State dimensions of freeing port area on back of this form.
The Surveyor should state whether the fall in sheer as reported is measured relatively to the straight line of keel or to the mean line of the vessel's draught at time of survey, and also the usual load draft forward and aft should be reported.

007114-007121-0073

Do all the Frames extend to the top height in the Poop? *yes* Raised Quarter Deck? *yes* Bridge House? *yes* Forecastle? *yes*
 To what height do the Reverse Frames extend? *B.A. frames*
 Has the Poop or Raised Quarter Deck an efficient Iron Bulkhead at the fore end? *yes*
 Give particulars of the means for closing the openings in Bulkhead *2 winged steel doors*
 Is the Poop or Raised Quarter Deck connected with the Bridge House? *no* Has the Bridge House an efficient Bulkhead at the fore end?
 Give particulars of the means for closing the openings in Bulkhead *2 winged steel doors on each of 3 bridge fronts*
 What is the thickness of the Bridge Front plating? *F .40 M .40 A .40* and Coaming plate? *F .44 M .44 A .44*
 Give scantlings and spacing of the Stiffeners *Fore 7x3x40 BA, 2'0" spacing, Middle 8x3 1/2 x 70 BA spaced 2'6" aft 6x3x36 angles 2'0" spacing*
 Are bracket plates fitted at each end of the Stiffeners? *yes* Are hor'l. brackets fitted connecting Bridge Bulk'd. with Bulwarks? *yes*
 Has the Bridge House an efficient Iron Bulkhead at the after end? *yes to all three bridge*
 How are the openings closed? *winged steel doors*
 Is the Forecastle at least as high as the main or top-gallant rail? *yes* Has the Forecastle an efficient Iron or Wood Bulk'd. at after end? *yes*
 Are the Engine and Boiler openings covered by a Bridge, Poop, Raised Quarter Deck, or enclosed by a Strong Iron or Steel Deckhouse? *covered by middle bridge.*
 If the openings are not so protected are the exposed parts of the Casings efficiently constructed?
 Give thickness of plating; scantlings and spacing of Stiffeners
 What is the height of the exposed Casings? Are suitable means provided for closing all openings in them in bad weather?
 Are the Weather Deck Hatchways efficiently constructed and at least equal to the requirements of Section 28 of the Rules for 1904-5? Give particulars below:— *yes.*

| Position and Size. | N°1 Fore 25'6" x 20'3" | | N°2 25'6" x 20'3" | | N°3 Bridge Deck 20' | | N°4 25'6" x 20'3" | | N°5 25'6" x 20'3" | |
|-------------------------------|-----------------------------|------------|-------------------|--------|---------------------|-----------|-------------------|--------|-------------------|---------------------|
| Item. | Ship. | Rule. | Ship. | Rule. | Ship. | Rule. | Ship. | Rule. | Ship. | Rule. |
| COAMING. | Height above top of DECK | 2'6" | 2'6" | 2'6" | 2'6" | 2'6" | 2'6" | 2'6" | 2'6" | 2'6" |
| | Thickness | Sides..... | .50 | .50 | .50 | .50 | .44 | .44 | .50 | .50 |
| | | Ends..... | .44 | .44 | .44 | .44 | .44 | .44 | .44 | .44 |
| SHIFTING BEAMS OR WEB PLATES. | Number..... | 4 | 4 | 4 | 4 | 1 | 1 | 4 | 4 | 4 |
| | Section and Scantlings..... | 7" 18"x36 | | as N°1 | | 7" 18"x32 | | as N°1 | | as N°1 |
| | Material..... | 1L 4x3x44 | | | | 1L 3x3x40 | | | | |
| * FORE AND AFTERS. | Number..... | | | | | | | | | |
| | Section and Scantlings..... | | | none | | none | | none | | none |
| | Material..... | | | | | | | | | |
| HATCHES | Thickness..... | 2 1/2 | | 2 1/2 | | 2 1/2 | | 2 1/2 | | 2 1/2 |
| Remarks..... | | | | | | | | | | all laid fore & aft |

* The depth of Fore and Afters should be stated from the underside of the hatches in all cases.

(If the sill of the lowest side scuttle will be less than 6 inches above the Indian Summer Load Line if assigned under the tables, state vertical distance from top of deck at side amidships to lower edge of lowest side scuttle.)

The following information is to be given in all Cases of vessels dealt with under Paras. 11, 12 (under 15 feet Moulded depth) and under Shelter Deck Rules.

What is the thickness of the Bridge Sheerstrake? *32"* Strake between Main and Bridge Sheerstrakes? *8'0"*

Delete the words *The Crew are, are not, berthed in the bridge house:*
 that do not apply *The arrangements to enable them to get backwards and forwards from their quarters are, are not satisfactory.*

Length of Bulwarks in well

Area of Freeing Ports required by Para. 11 (e) each side of vessel = *32" x 132 = 4224* Sq. ft.

Ft. Tenths. Ft. Tenths. No. } Freeing Ports (each side of vessel) = *11.83 x 94.4 = 1116* Sq. ft.


0 x 159.2 = 0
385.6 } Total deficiency or excess = *13.85 x 3 = 41.55 = mean sheer actual.* Sq. ft.

FOR SHEER

96 | 1 | 96
 54 | 4 | 216
 24 | 2 | 48
 6 | 4 | 24
 0 | 1 | 0
 12 | 384
 32"

AFT SHEER

36 | 1 | 36
 20 | 4 | 80
 9 | 2 | 18
 2 | 4 | 8
 0 | 1 | 0
 12 | 142
 11.83"

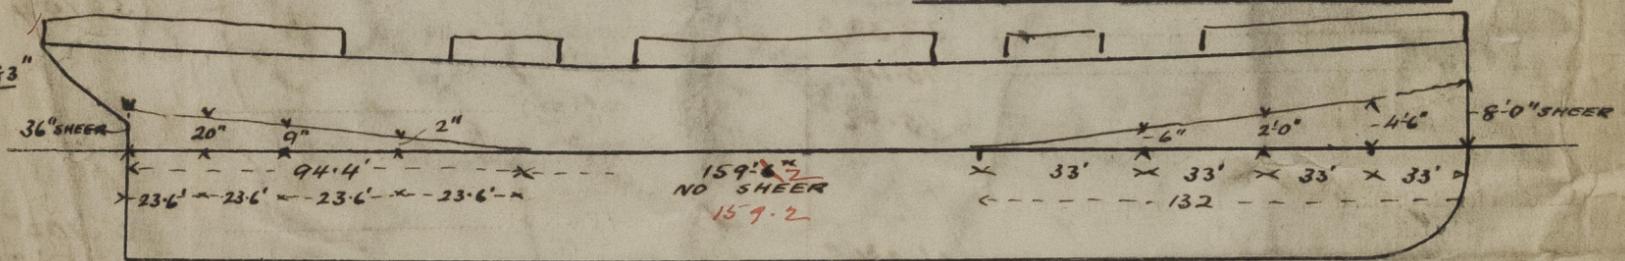

Show hereon line of Floors or Tank Top with position of any Breaks in same; also height of Peak Tank tops, &c., &c.

State any special features in the construction of the Vessel *Copies of all approved plans are already in London Office. The vessel is a repeat of "BACCHUS" by same builders NWE 73407*

Owners
 " Address

Fee £ 7 . 7 : 0 Received by me