


Secretary's letter "F" dated 15.10.37. 29368
Index No.

Lloyd's Register of Shipping.

Ship's Name Nicola Schiappino
(ex: "Muirton")

Official No. ✓

Memorandum of alterations reported since ship was surveyed for assignment of Load Lines
in January, 1933.

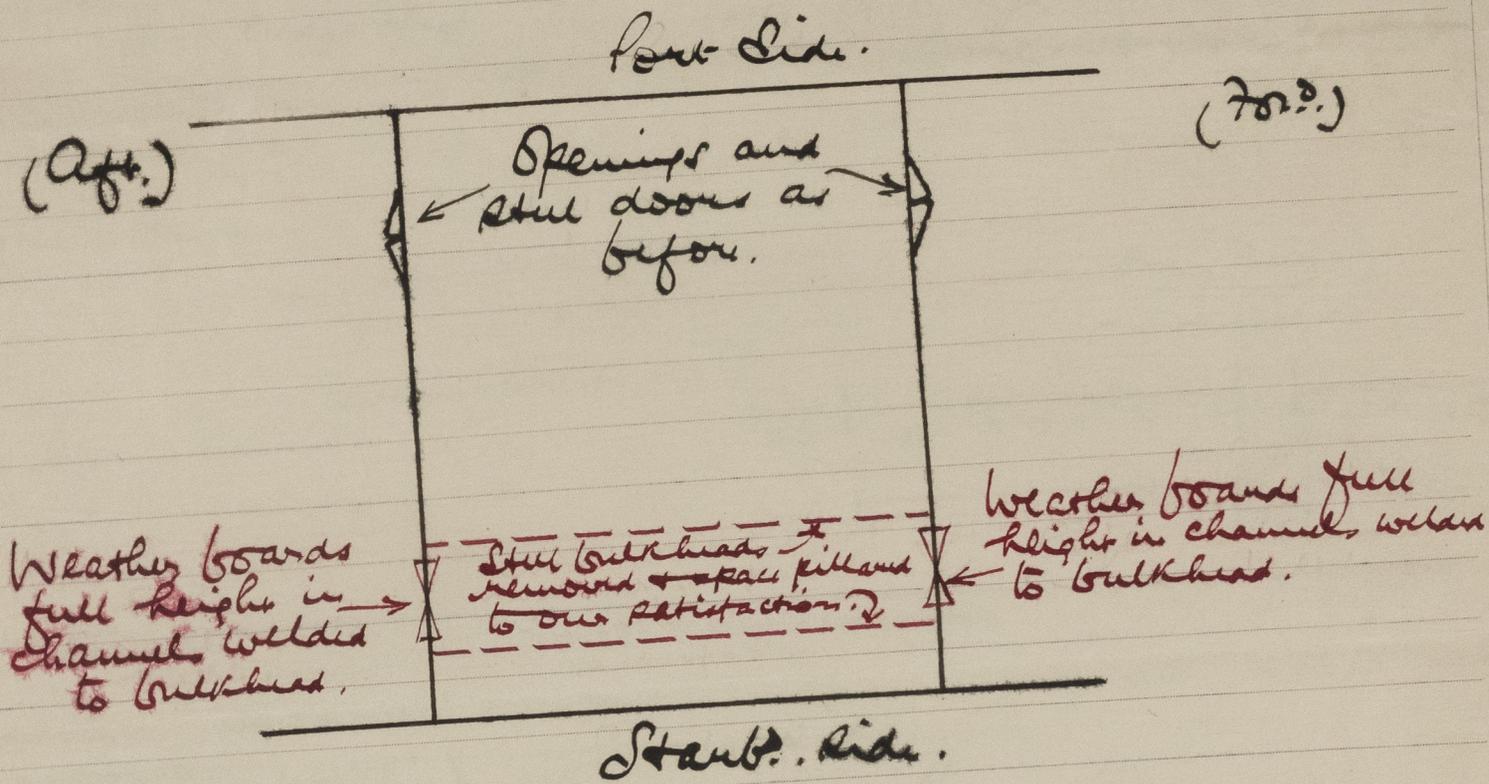

Bridge houses in forward and after wells.

(Please refer to Genl. Rep. No. 8089.
ex: "Muirton".
Alterations since effected are indicated in red.)

J. W. ...
16.5.38.
Marseille.

2200-1711 CO-111100