


~~RUSSISCH~~ STERNPOST.

FINISHED MEASURE, MATERIAL TO BE ADDED FOR BORING
WHEN PLACED IN SHIP

Approved as being similar
^{No 915}
Nes. ~~Am 60 d 60~~ ^{60 d 60} ~~Temper~~ st.

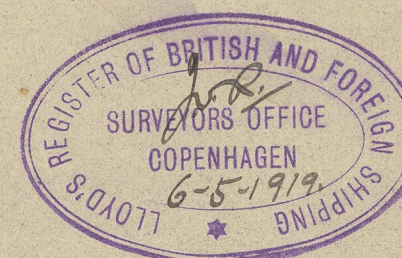

Agderstien & Kor

GRUPPE 17

$3/2 \cdot 3 = 1$ 377


007731-007738-0027

31
VARDAAS

Kalundborg Skibverft Skt. S.

Newbuildings No 10 & 21

East Steel Pierport.

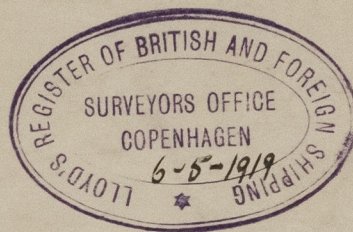

Approved at
Copenhagen.

Similar to No 9.

Length of arm = No 9

(not = 1000/101)

Kalundborg Newbuilding No 10.
{ J. J. Moland & Brandel.
now "VARDAAS" Copenhagen Report No. 6074

Kalundborg Skibverft Skt. S. No. 21
S.S. PRINS KNUD
Copenhagen Report No. 6431 A.

& Böttger

Lloyd's Register
Foundation