

Lloyd's Register of Shipping.

Ship's Name


S/S "BIRGITTA"

Official No.


7982

Memorandum of alterations reported since ship was surveyed for assignment of Load Lines
in


ACTUAL DECKHOUSES

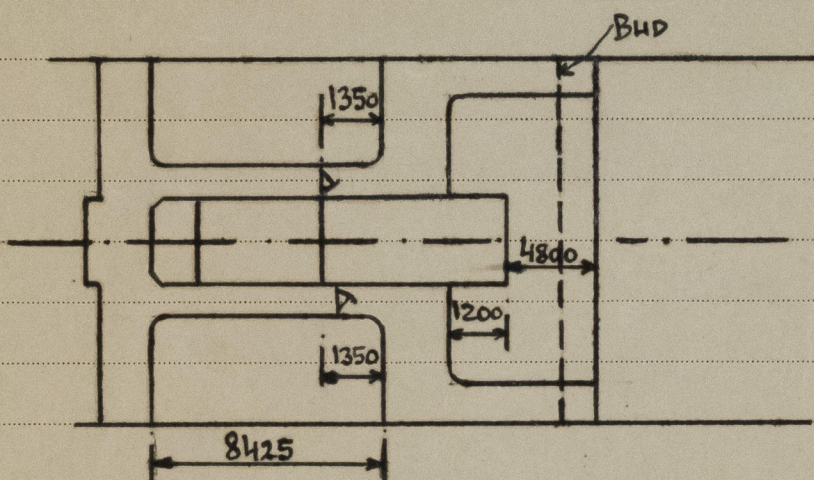

BRIDGE DECK

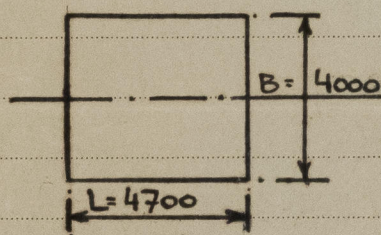

CAPTAIN'S HOUSE

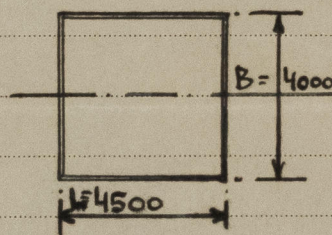

WHEELHOUSE

Bedford Lynne

Noted
A.H.
S.V. 46



© 2020

Lloyd's Register
Foundation

007731-007738-0046