


30.5.11  
16.6.11

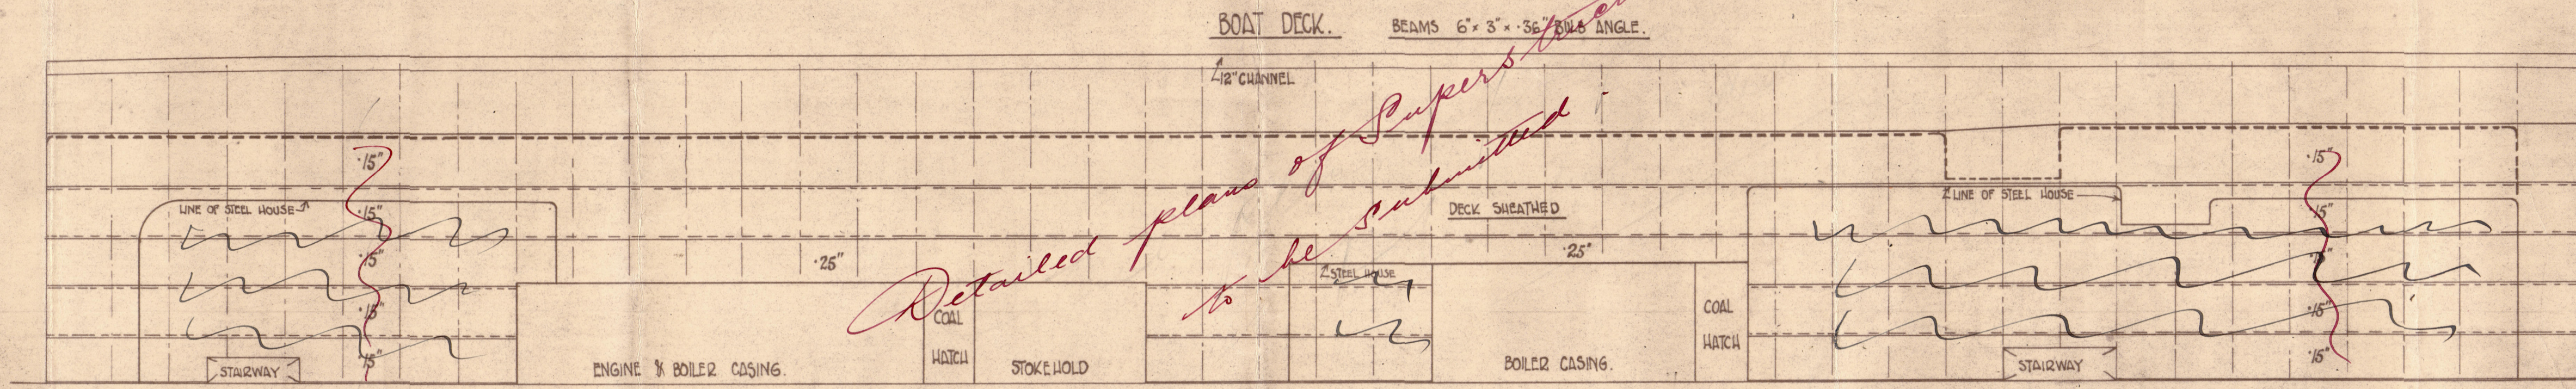

STEEL DECKS.


Nº 494.

MOULDED DIMENSIONS:- 425'-0" x 53'-0" x 32'-0"

SCALE  $\frac{1}{8}'' = 1 \text{ FOOT}$


TO CLASS 100A.I. LLOYDS.

NOTE:- 3 ROWS PILLARS FOR<sup>9</sup> OF 34<sup>0</sup> 121.  
2 " " AFT " " 121.

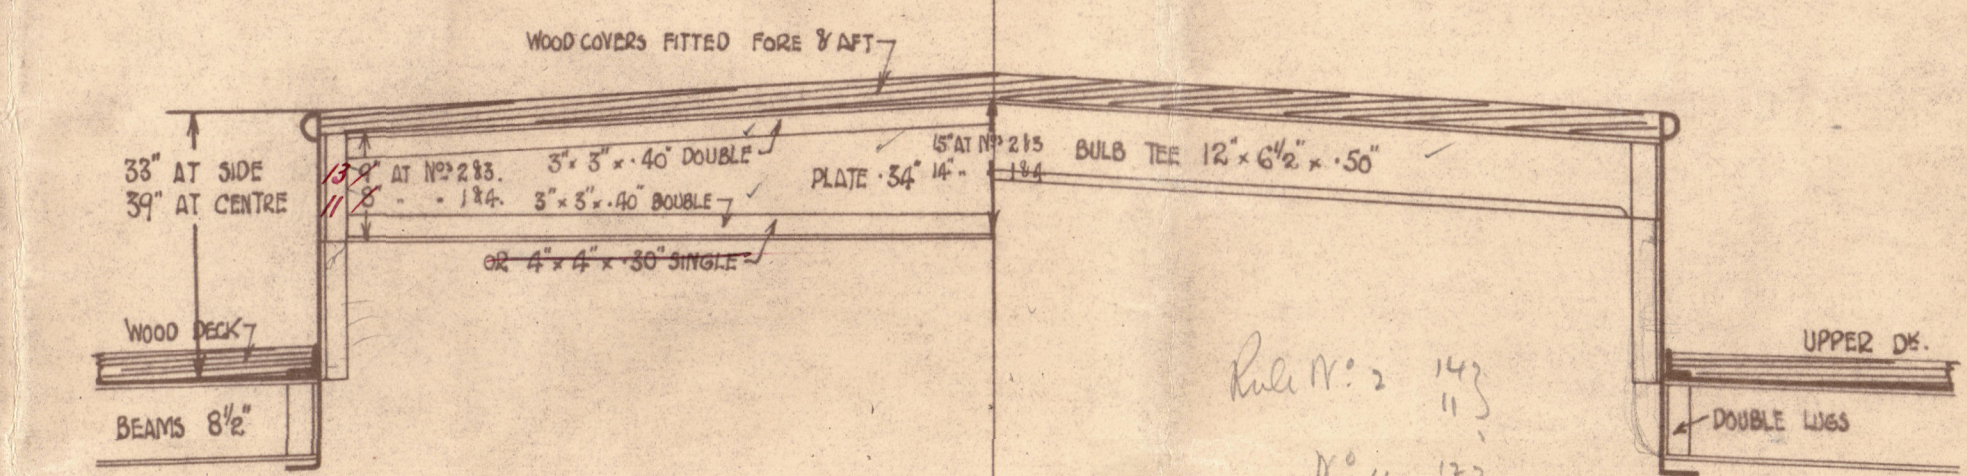


DETAILS OF HATCHES ON UPPER DECK.


POOP DECK

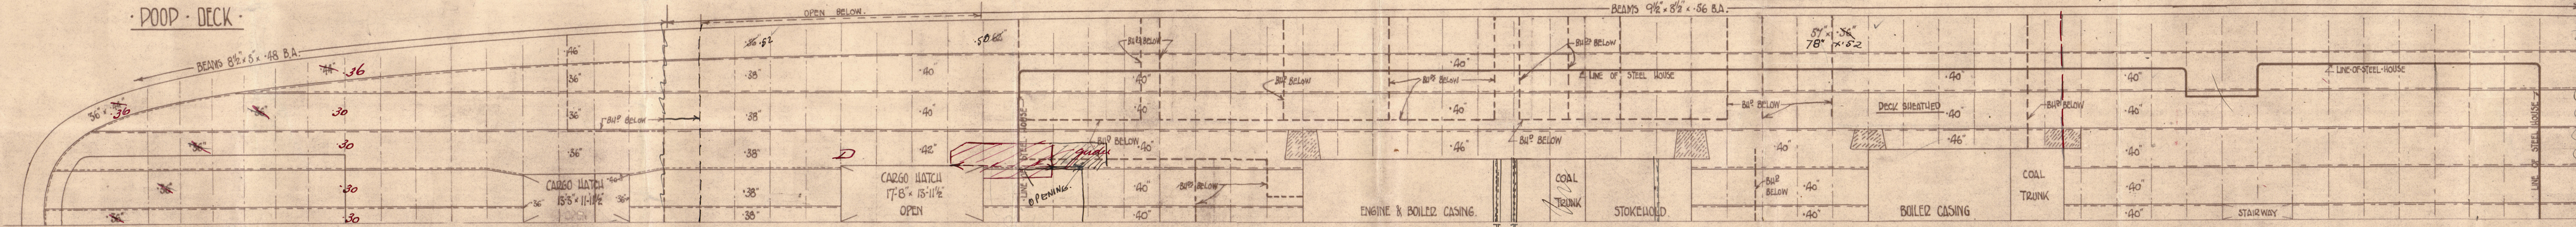


• UPPER • DECK •

 

• MAIN • DECK •

 

· LOWER · DECK ·

 

FORECASTLE-DECK

• UPPER • DECK •

· MAIN · DECK ·

• LOWER • DECK

C.B.  
30.5.11.





EMPIRE PENRYN


Barclay Curle & Co.

Deck Plans

No. 494 TS/S

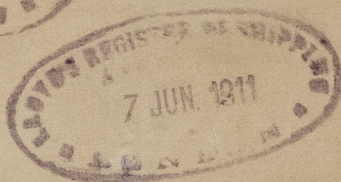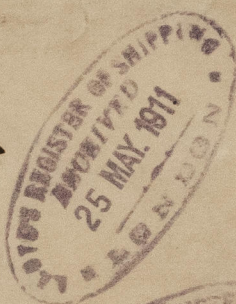

GLASGOW REPORT No. 31421

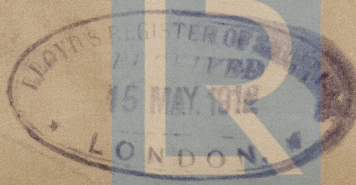

© 2020

Lloyd's Register  
Foundation

007729.007745.0003



007739-007745-003



© 2020

Lloyd's Register  
Foundation