


30.5.11
16.6.11
6.7.11
23.8.11
6.11.11

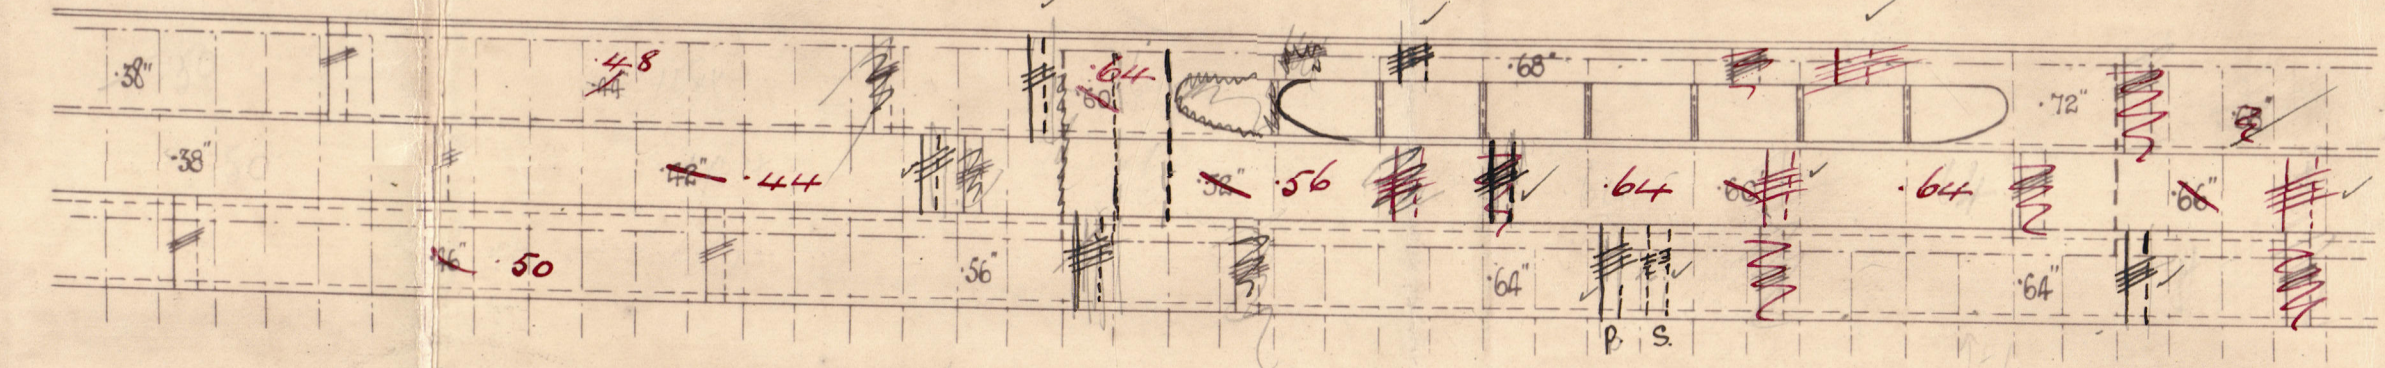


STRENGTHENING AT AFT END OF BRIDGE.

PROFILE

No. 494.

MOULDED DIMENSIONS:- 425'-0" x 53'-0" x 32'-0".
SCALE 1/8" = 1'00".

 


Supported to Surveyor's satisfaction.

Reinforcing arrangements in Machinery space to Surveyor's satisfaction.

Strengthening at Bridge Port to be submitted.

Supported to Surveyor's satisfaction.

Plan showing arrangement of Braced Framing to be submitted.

 

EMARE PENRYN





© 2020

Lloyd's Register

Foundation

GLASGOW REPORT No. 31421

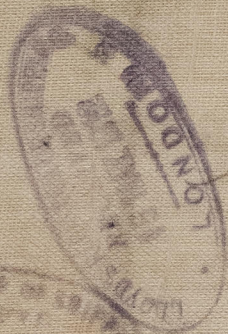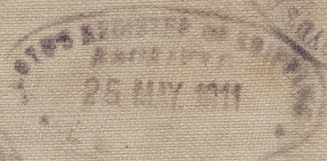

Barclay Curle & Co.
Profile
No 494^{TS}



© 2020

Lloyd's Register
Foundation