

Nº 282. "KAIAN MARU"


STERN FRAME.

SCALE $\frac{1}{2}$ INCH TO ONE FOOT.

MATERIAL :- CAST STEEL.

WEIGHT OF STERN FRAME ABOUT 9.62 TONS.
WITH LIGNUMVITAE.

DETAILS:- 3 INCH TO A FOOT.

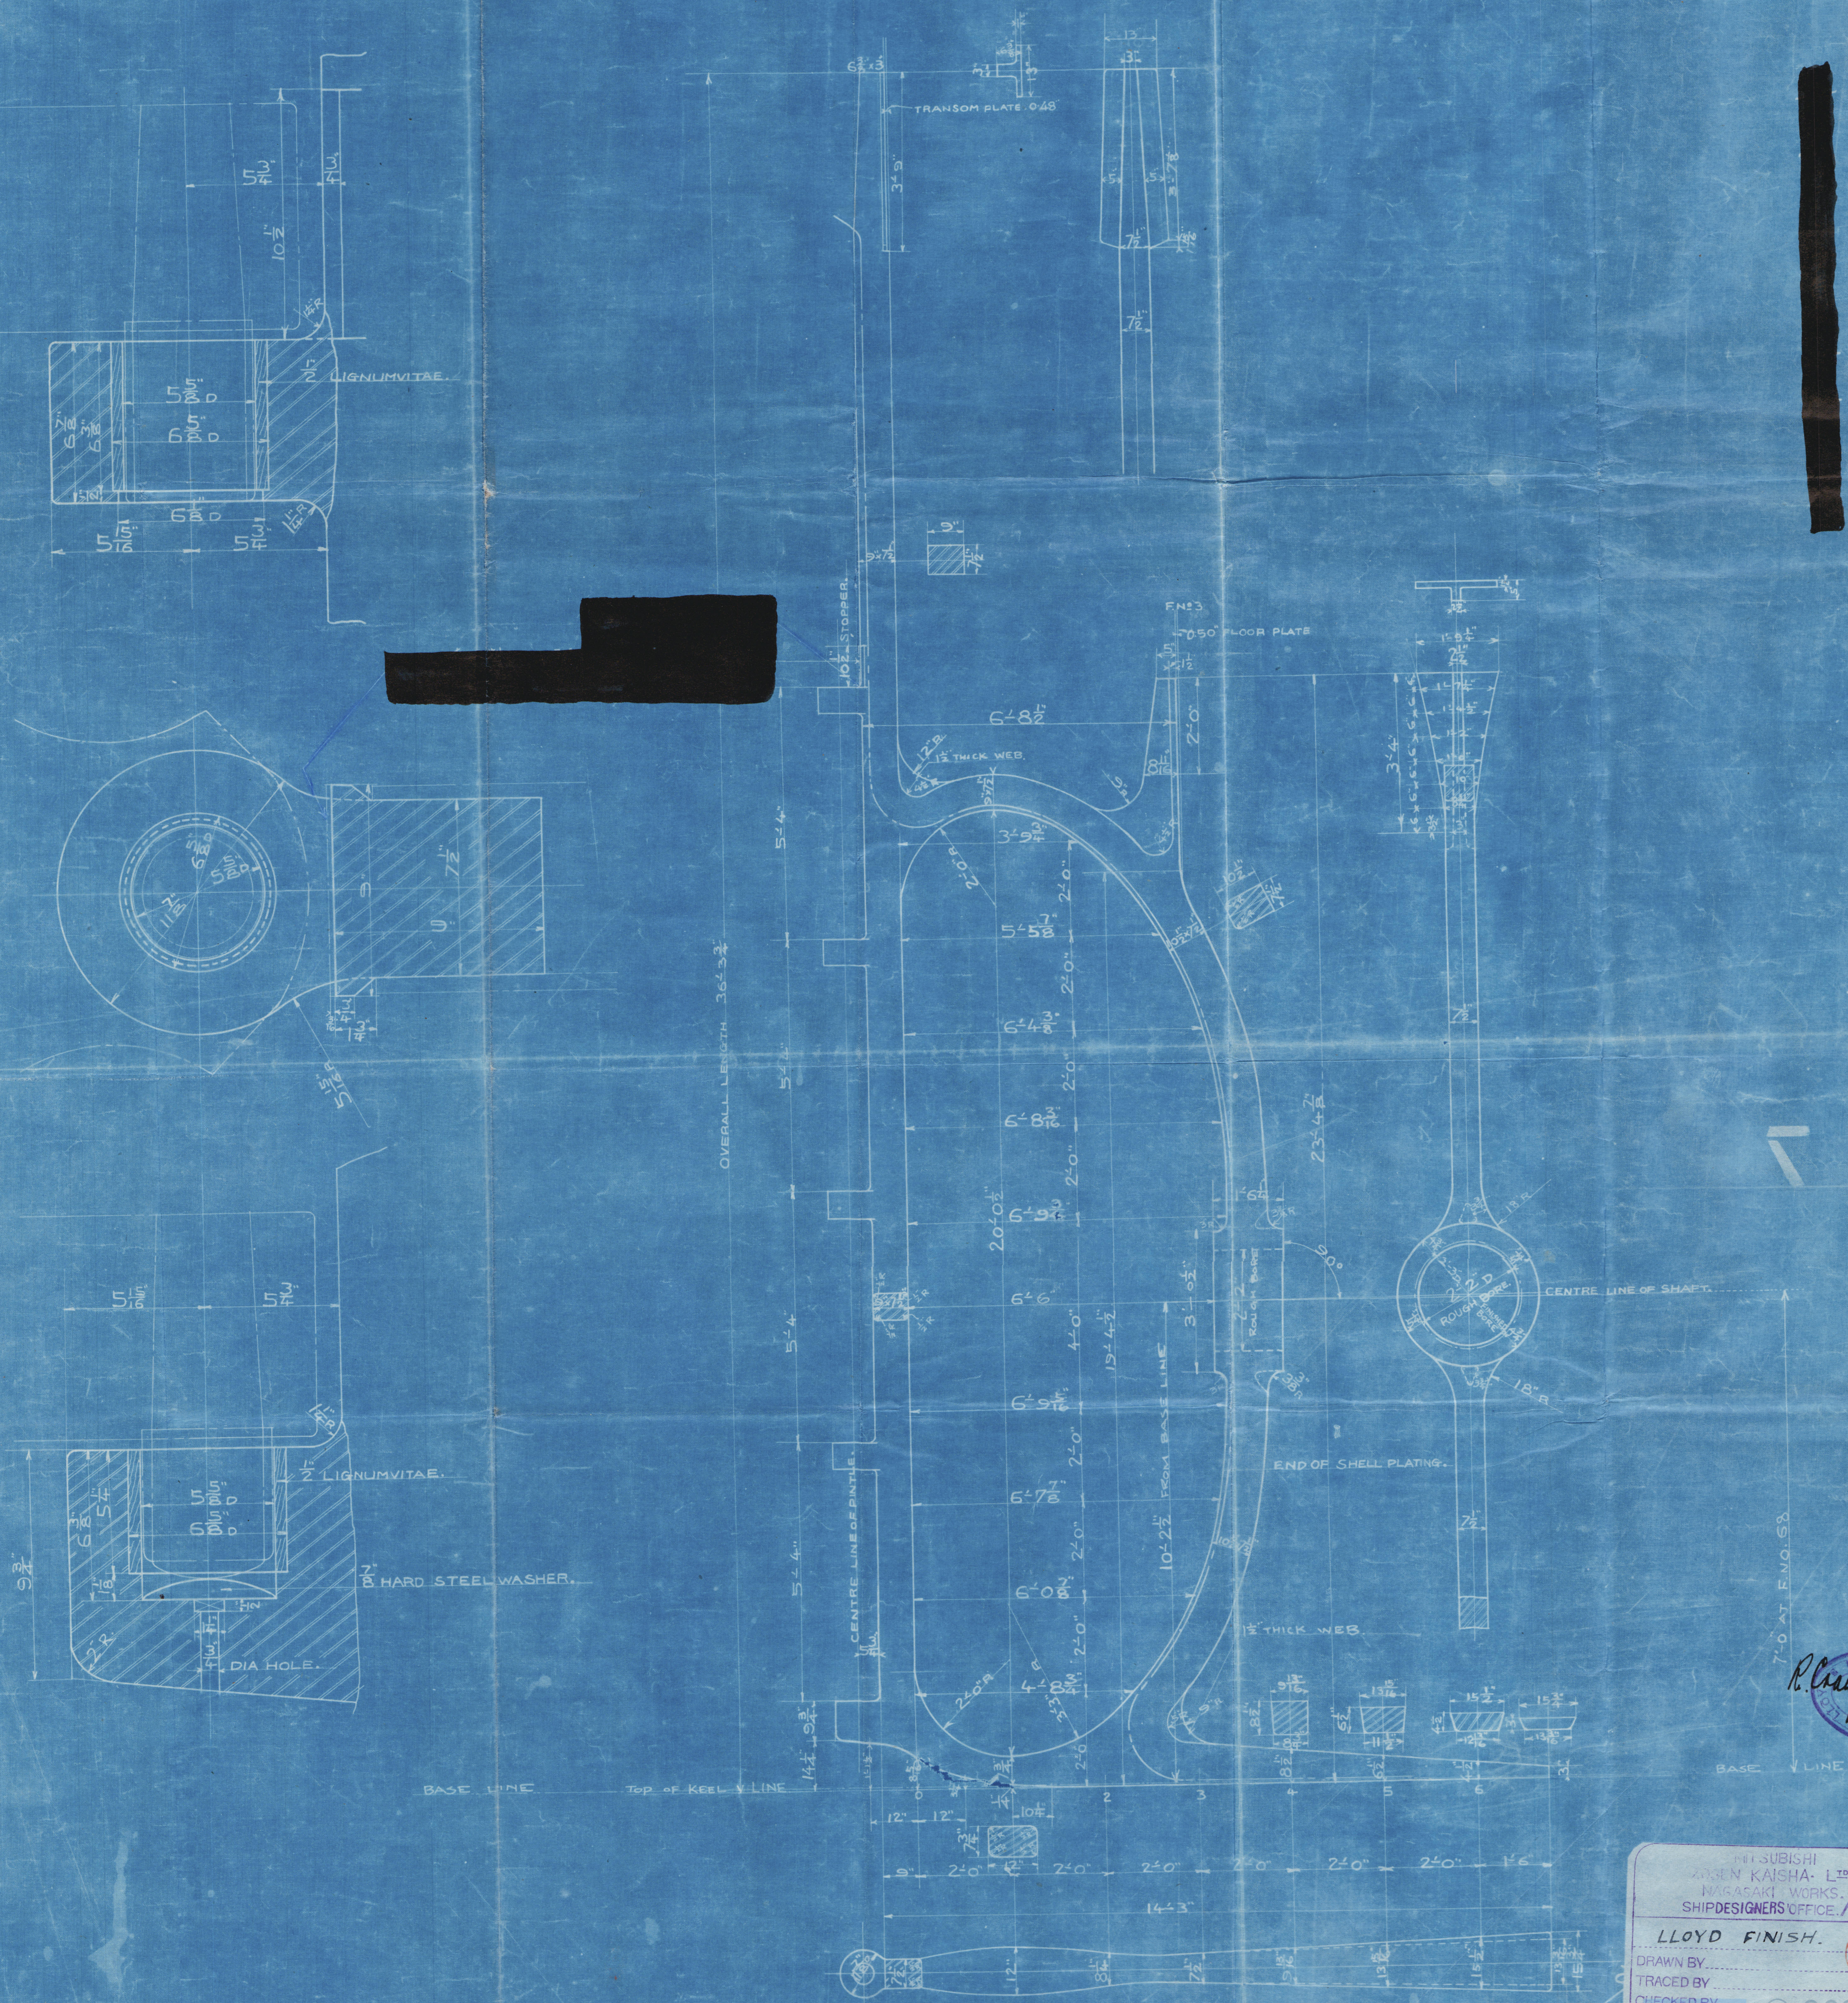

R. Crawford.
1/14/19

MITSUBISHI
KAISHA, L^{TD}
NAGASAKI WORKS.
SHIPDESIGNERS OFFICE, A.

LLOYD FINISH.

DRAWN BY.....
TRACED BY.....
CHECKED BY.....
APPROVED BY.....
DESIGNERS OFFICE NO. 1188
DATE MAR 21 1919

Foundation

002739-002743-0122

"Taneyama Maru"
S. S. "Kaian Maru"^{EX}

Stern Frame

Accompanying, Nagasaki

Report No. 1226



© 2020

007739-007743-0122

Lloyd's Register
Foundation