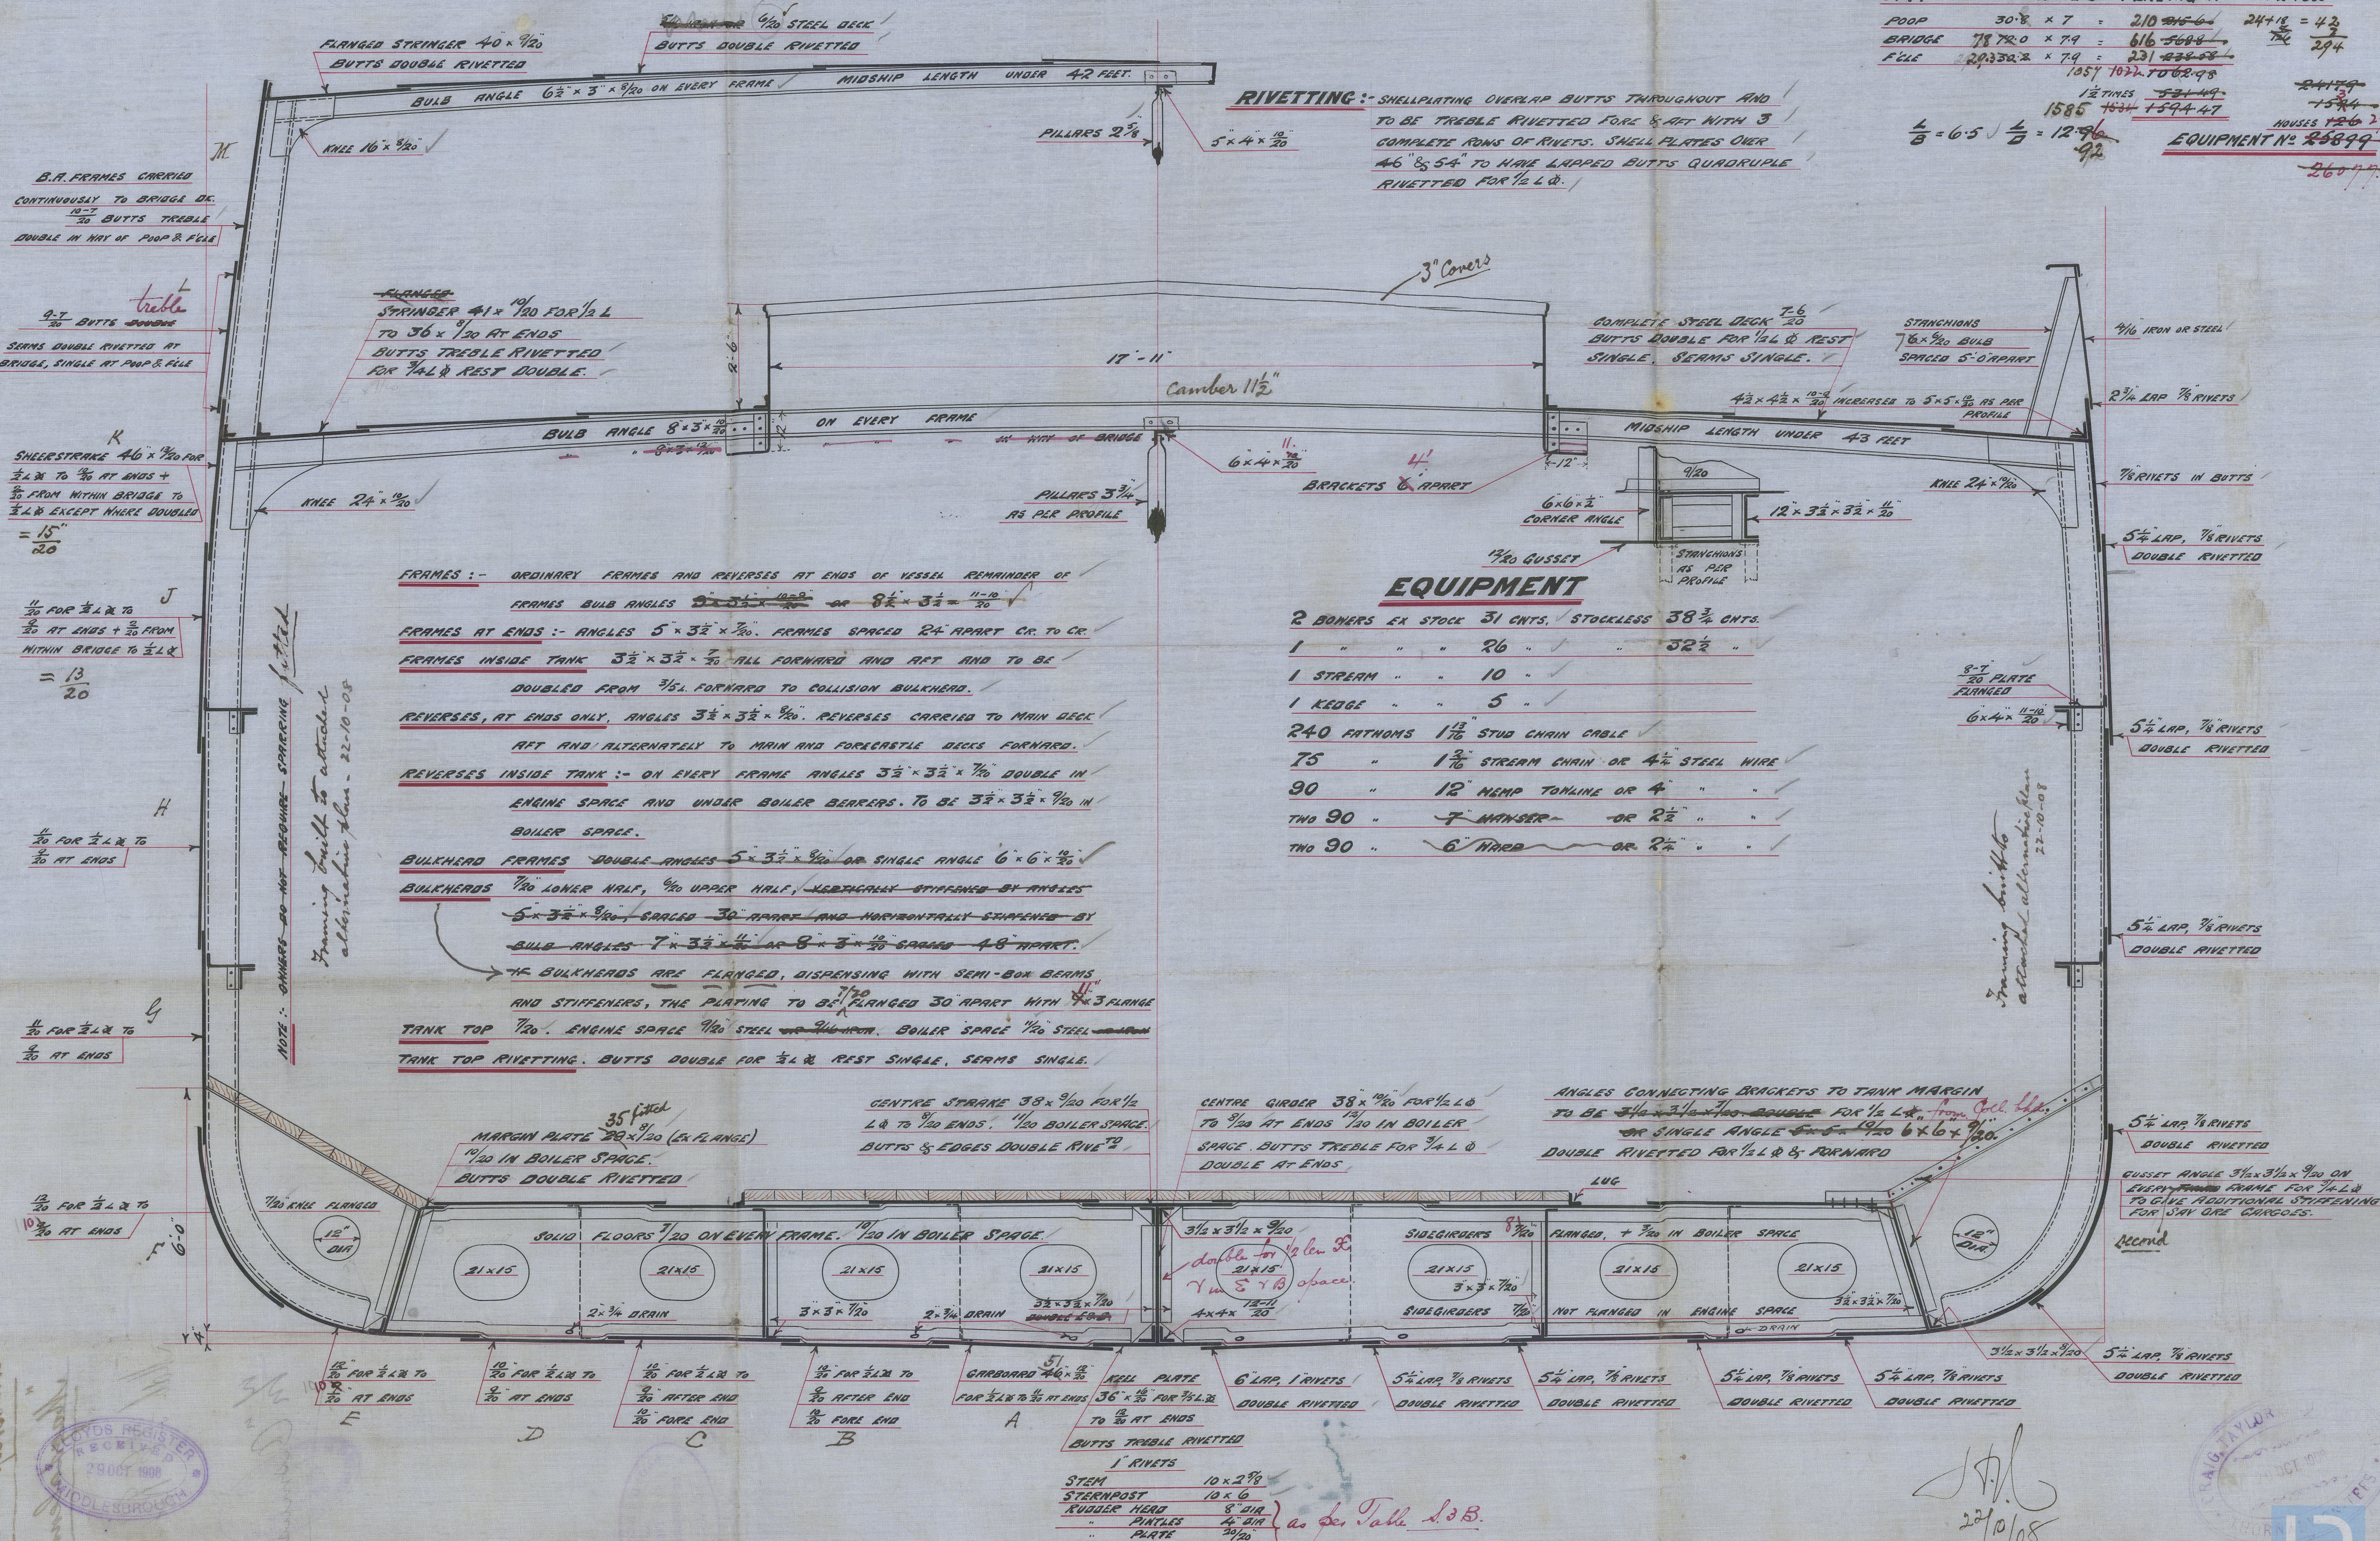


LENGTH B.P.	287'-0"
BREADTH M.L.D.	43'-9"
DEPTH M.L.D.	21'-1 1/2"

S.S. No 132
MIDSHIP SECTION
SCALE $\frac{1}{2}$ IN = 1 FT.
CLASS 100 R.I. LLOYDS.
STEEL

"Magdalena"

$\frac{1}{2}$ BERN 21.87
 $\frac{1}{2}$ BIRTH 40.87
 DEPTH 22.88
 FRAME NO 84.74
 PLATING NO 229/24000
 200P 30.8 x 7 = 210
 BRIDGE 78.780 x 7.9 = 616
 229.30 x 7.9 = 1829.7
 $\frac{1}{5} = 6.5$ $\frac{1}{5} = 12.9$
 EQUIPMENT NO 229


$$\begin{array}{r} 24213 \\ 1585 \\ 294 \\ \hline 26092 = 9 \end{array}$$

© 2020
Lloyd's Register
Foundation

Graig Taylor & Co.
No 132.

Midship Section

"Magdalena"

Mdb. J. E. Rpt. No. 5778.

W. n
M. Osmussen



© 2020

Lloyd's Register
Foundation

007746-007753-010722