


Showing escape hatch
as fitted on after well
deck, to hold.
Condition found good.
Can be opened from
outside.



Showing escape
hatch as fitted
on forward well
deck, to hold.
Condition found
good.
Can be opened
from outside.

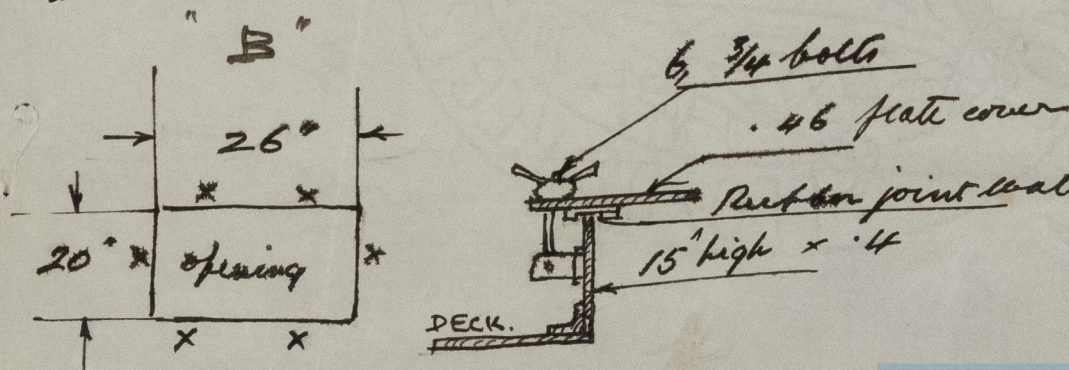

© 2020

14/6/33

Lloyd's Register
Foundation