

— N^o 439.—
PROFILE & DECK PLAN.

STEEL TWIN SCREW TUG.

- DIMENSIONS. -


LENGTH. B. P. ----- 94'-0"

BREADTH. M^{LD} ----- 23'-0"


DEPTH. M^{LD} ----- 10'-6".

SCALE $\frac{1}{4}" = 1 \text{ FOOT.}$

PILLARS THROUGHOUT TO SURVEYORS SATISFACTION.

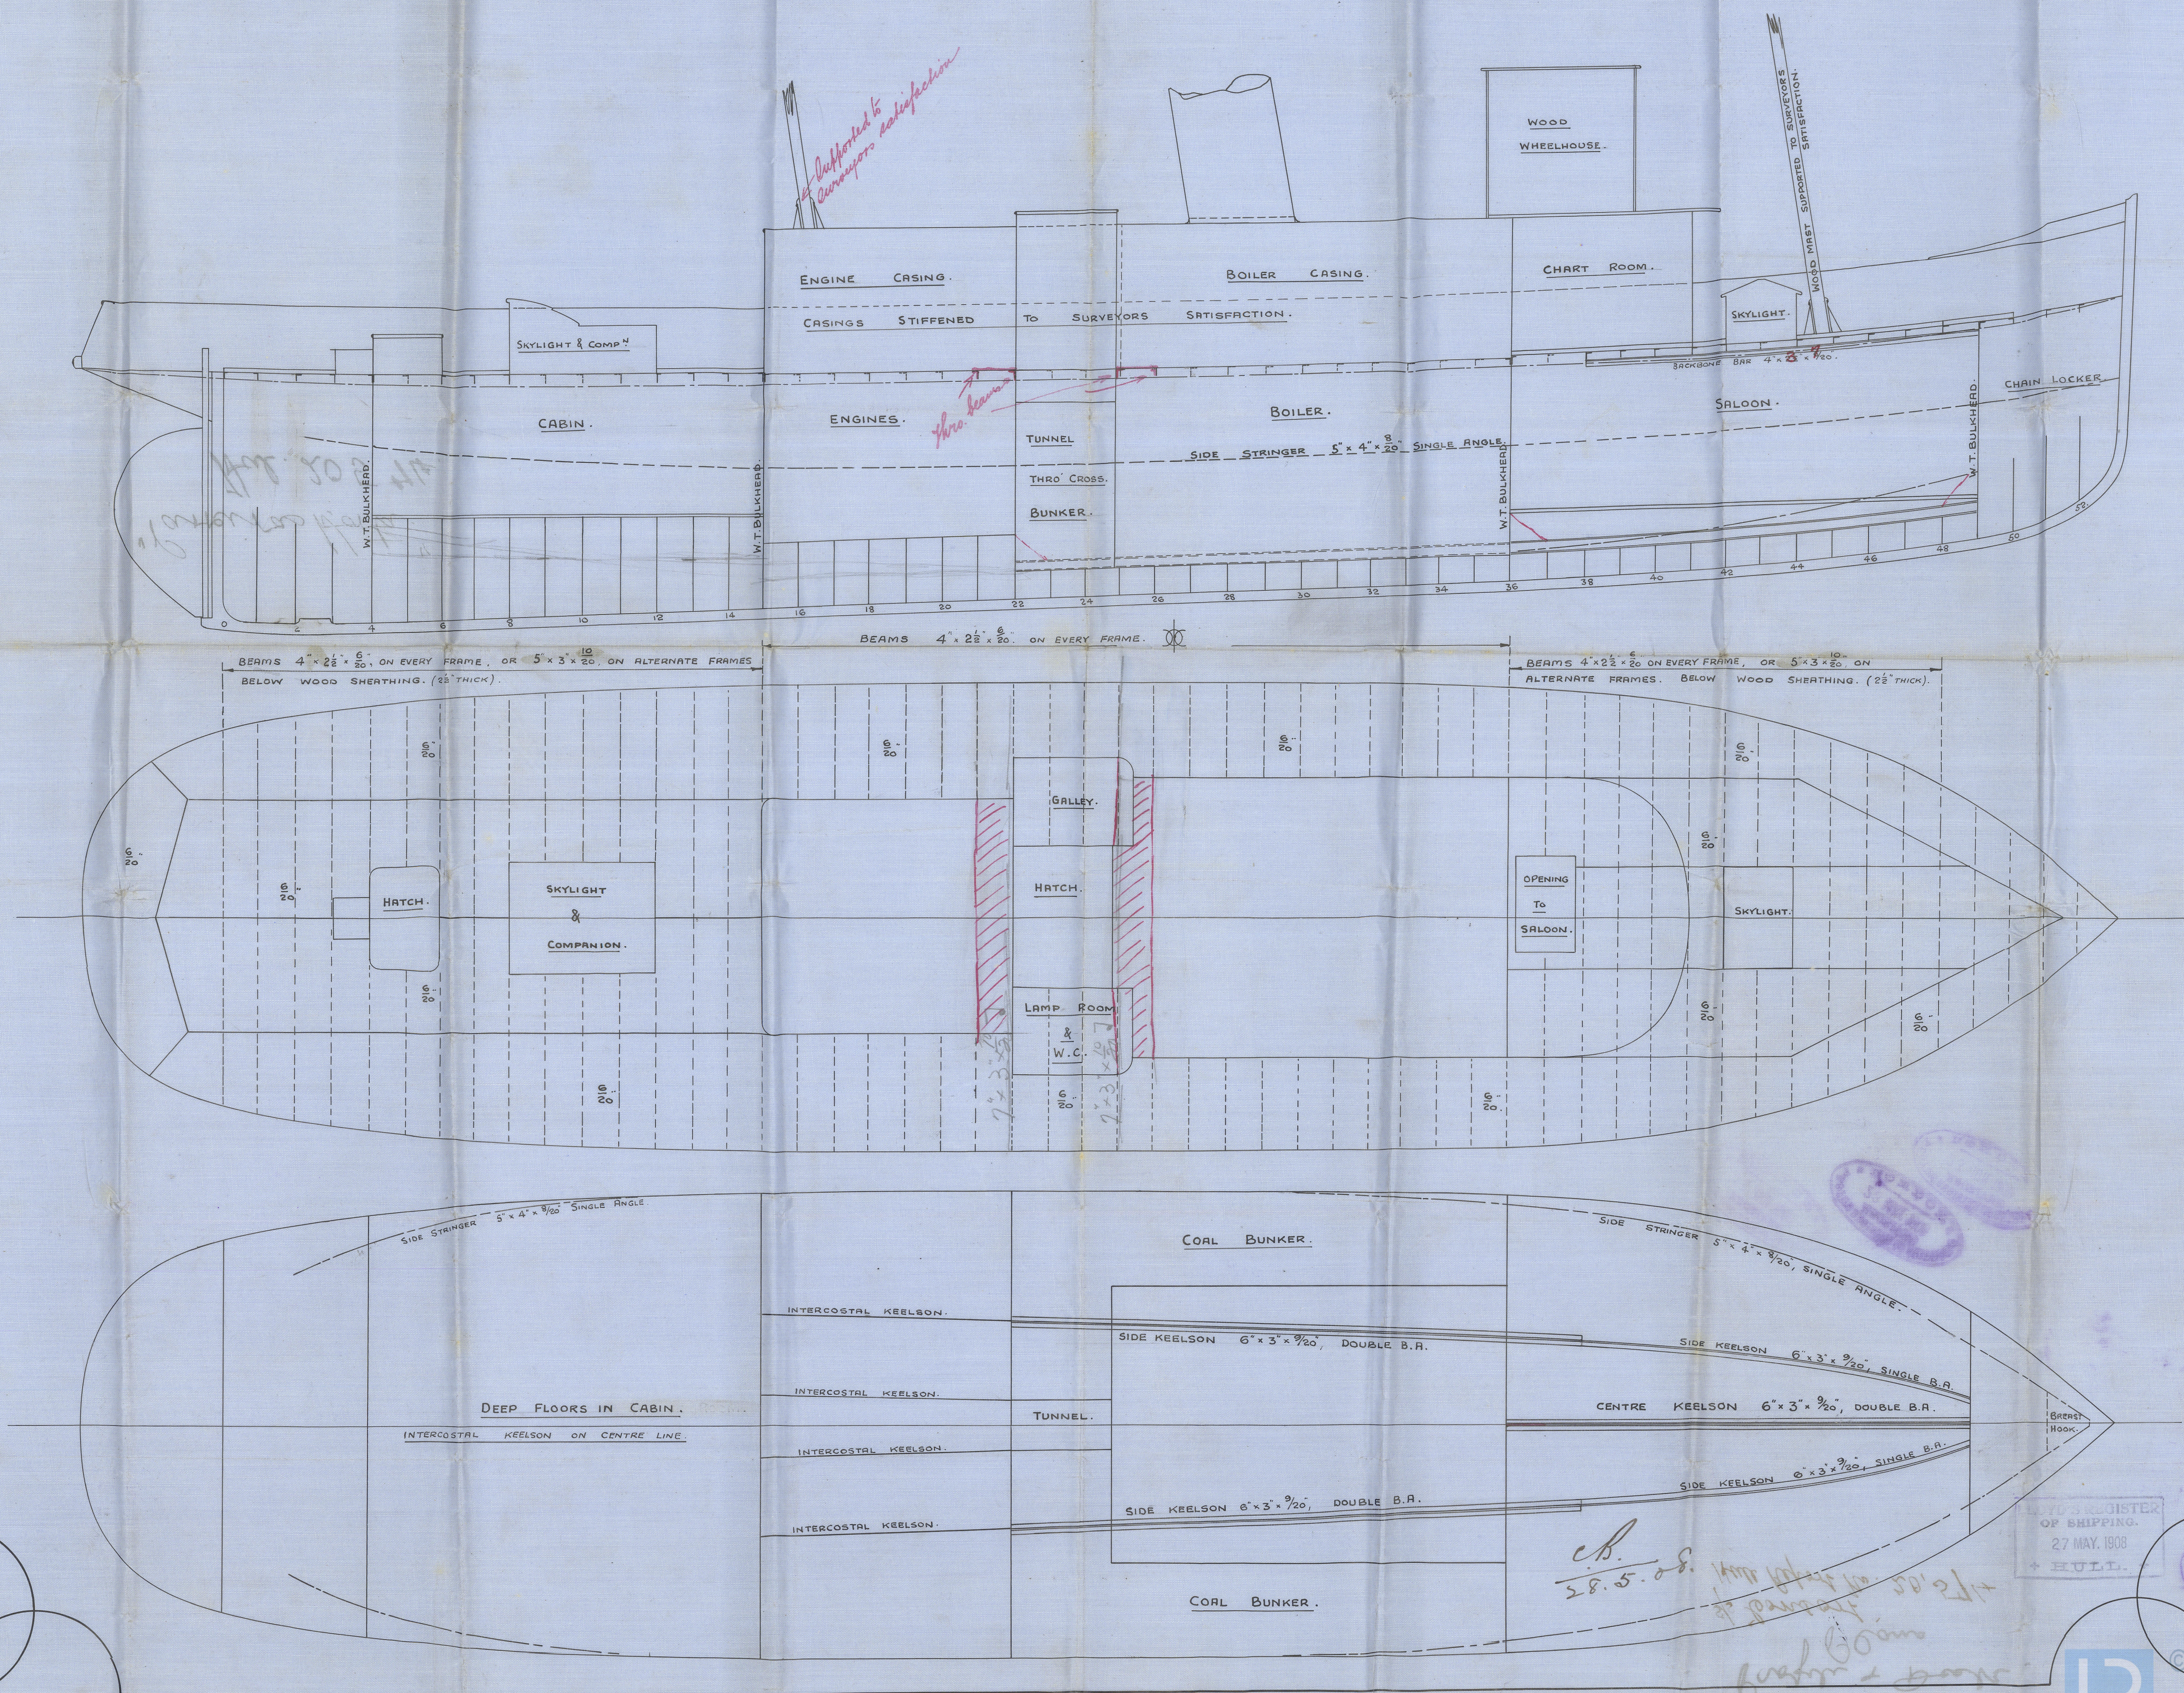

27 MAY. 1908
* HILL, L.

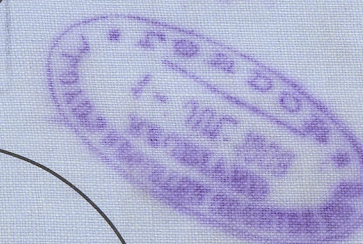

Cochran & Son


No. 439

Profile & Deck
Plans

s/s Consort

Hull Report No. 20,574

2.85
2.21
2.5

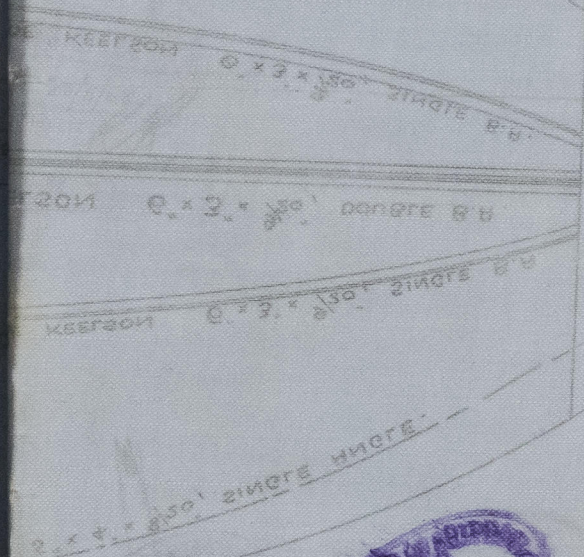

© 2021

Lloyd's Register
Foundation

"Pereira Horta."

Jul. 20 5 '74.



© 2021

Lloyd's Register
Foundation

007754-007761-0077