

439. MIDSHIP SECTION

STEEL TWIN SCREW TUG

DIM: 94'-0" x 23'-0" x 10'-6" M-L

SCALE 1/2" = ONE FOOT

TO CLASS ∇ 100 A.I. AT LLOYDS FOR TOWING PURPOSES.

28.5.08.
15.6.08.
27.08

NUMERALS

1/2 BREADTH 11'-5"
1/2 GIRTH 18'-4"
DEPTH 10'-9"

41.18 1ST NUMBER.

LENGTH PER RULE 93.1

3833.85 2ND NUMBER.


PROPORTIONS

LENGTH TO BREADTH 14.04

LENGTH TO DEPTH 8.4

EQUIPMENT

- 1st BOWER ANCHOR 4 1/4 EX STOCK.
- 2nd " " 4 " "
- 3rd " " 2 1/2 " "
- 60 FATHOMS 1 1/8" STAINLESS CABLE.
- 60 " 5/8" HAWSER.
- 60 " 3/4" WARP.

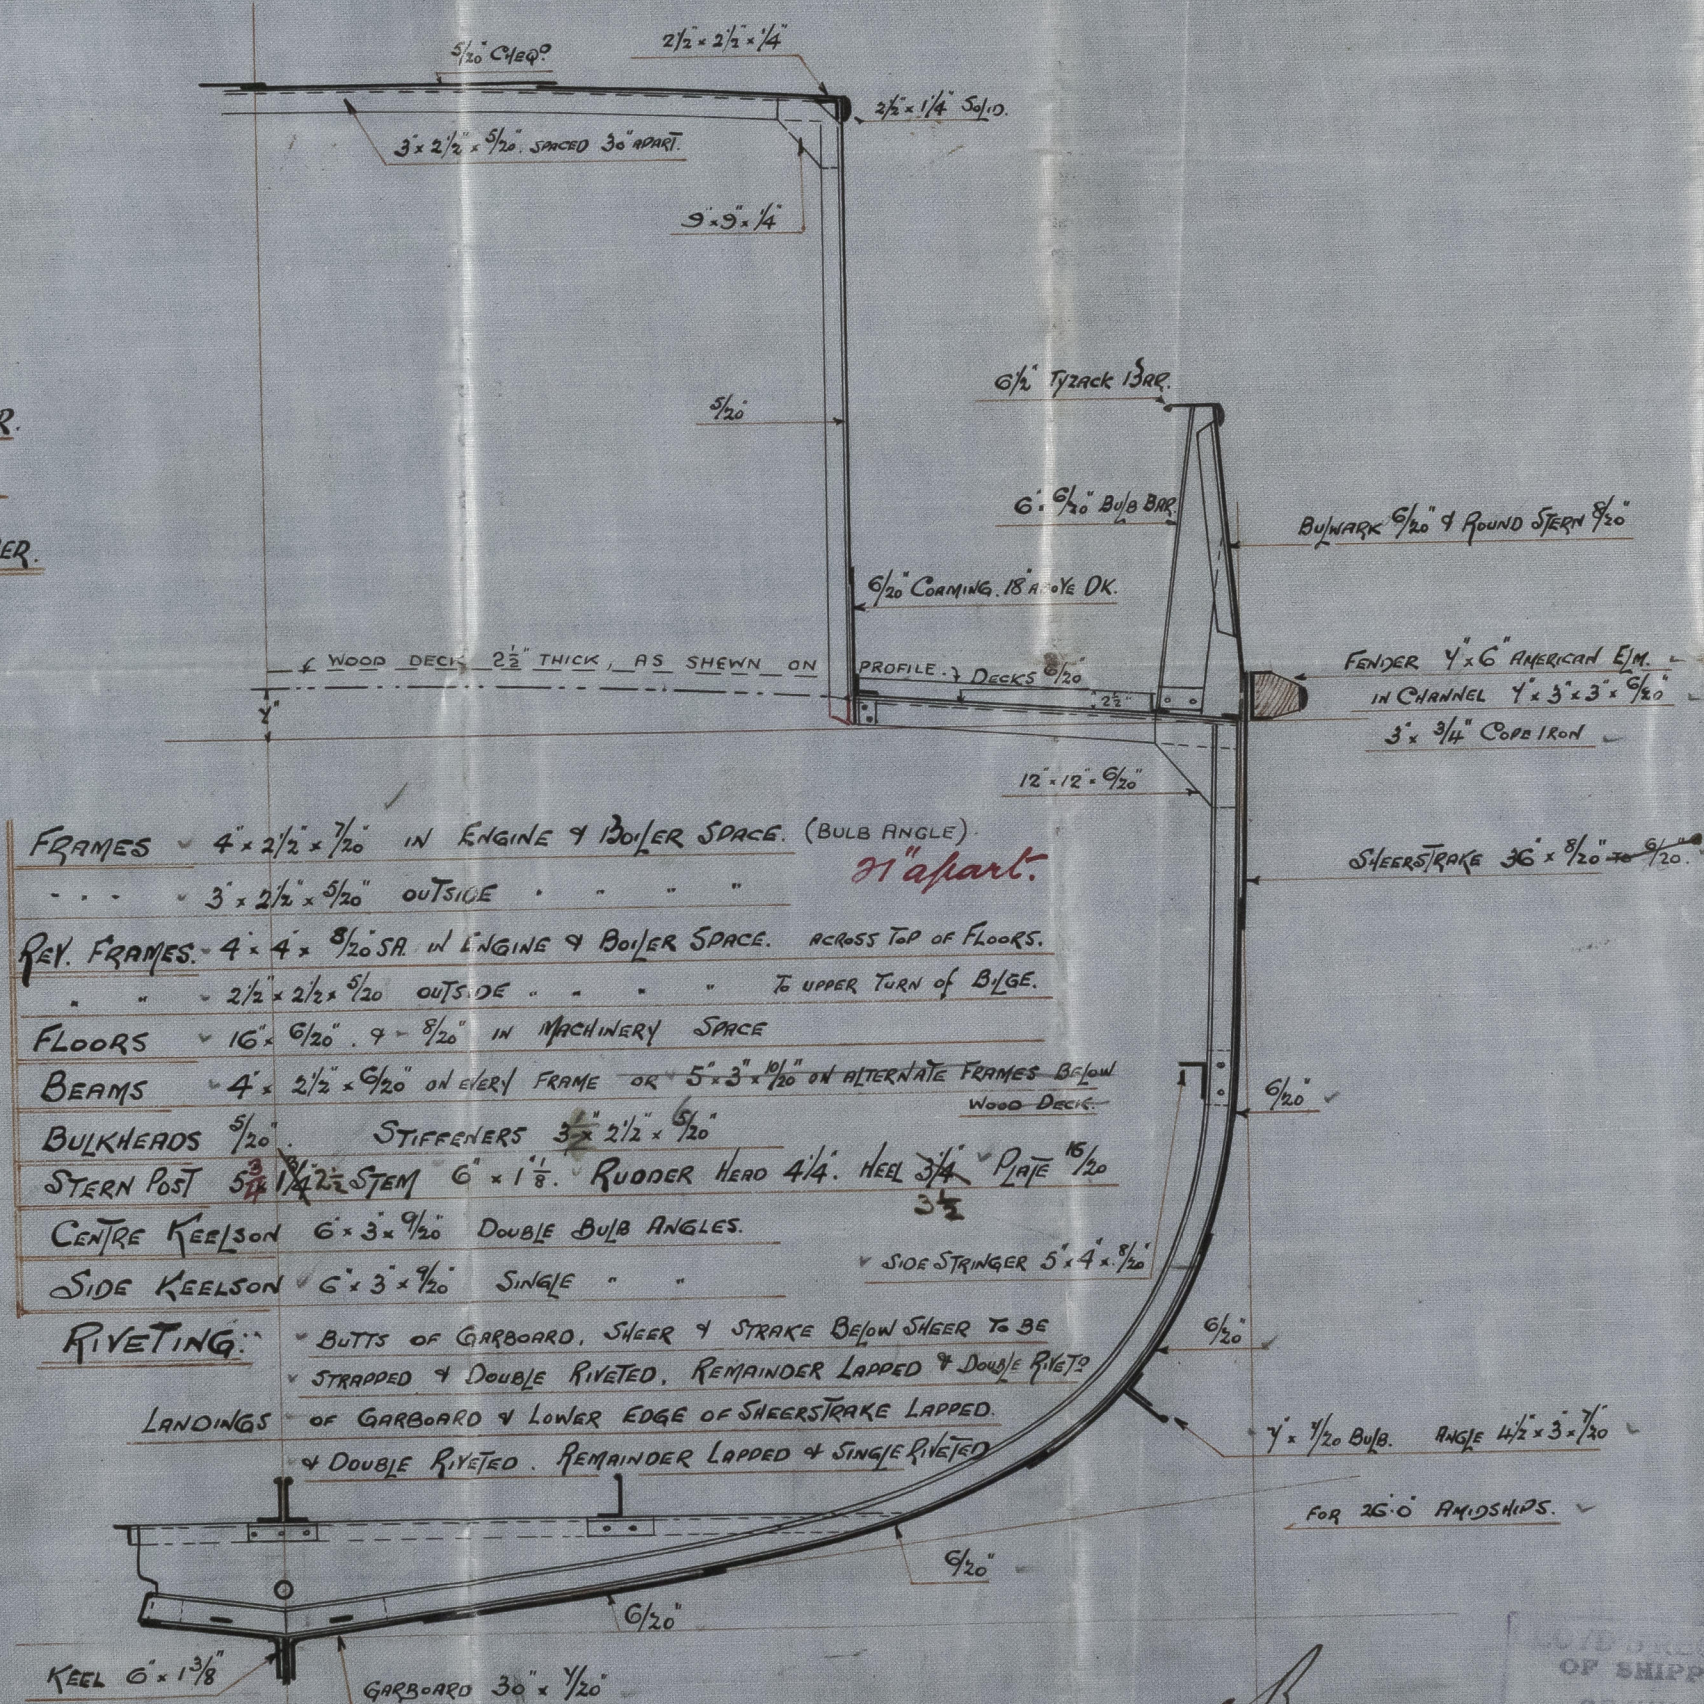

28.5.08.


LLOYD'S REGISTER
OF SHIPPING.
27 MAY, 1908
HULL.

Cochrane & Sons
No. 439.

Midship Section.
s/s Consort

Hull Report No. 20.574

by Pameiras Hortis

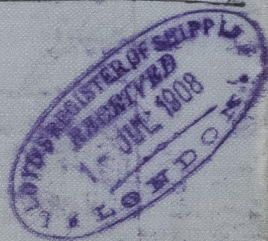

SECTION


Tue

3.0.10.6

FOR TOWING PURPOSES

25.11.10

2.11.10

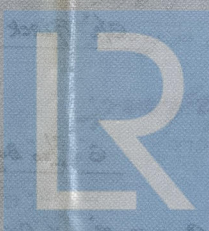

© 2021

Lloyd's Register
Foundation

007754-007761-00773