
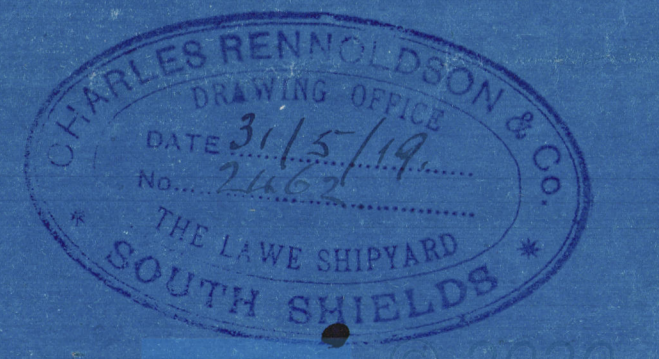
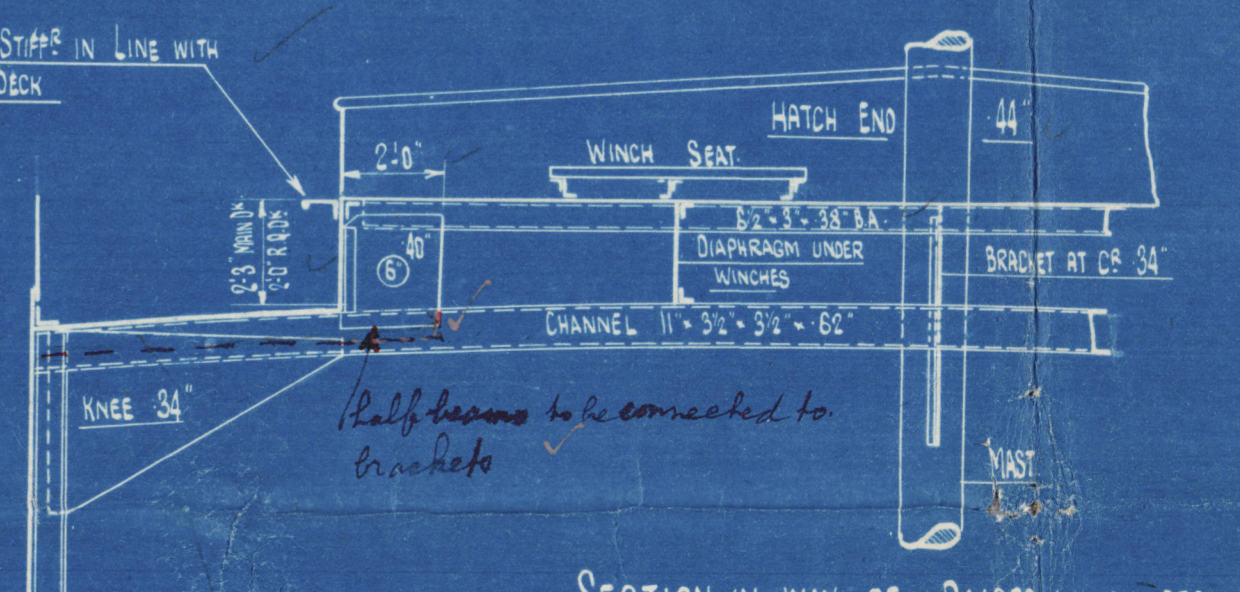


16.6.19

5'S INSTON"
PROFILE AND DECKS
No 185 SHIP, DIMENS 270'-0" x 38'-0" x 18'-10" MLD
TO CLASS LLOYDS 100 A1
SCALE 1/8" = 1'-0"

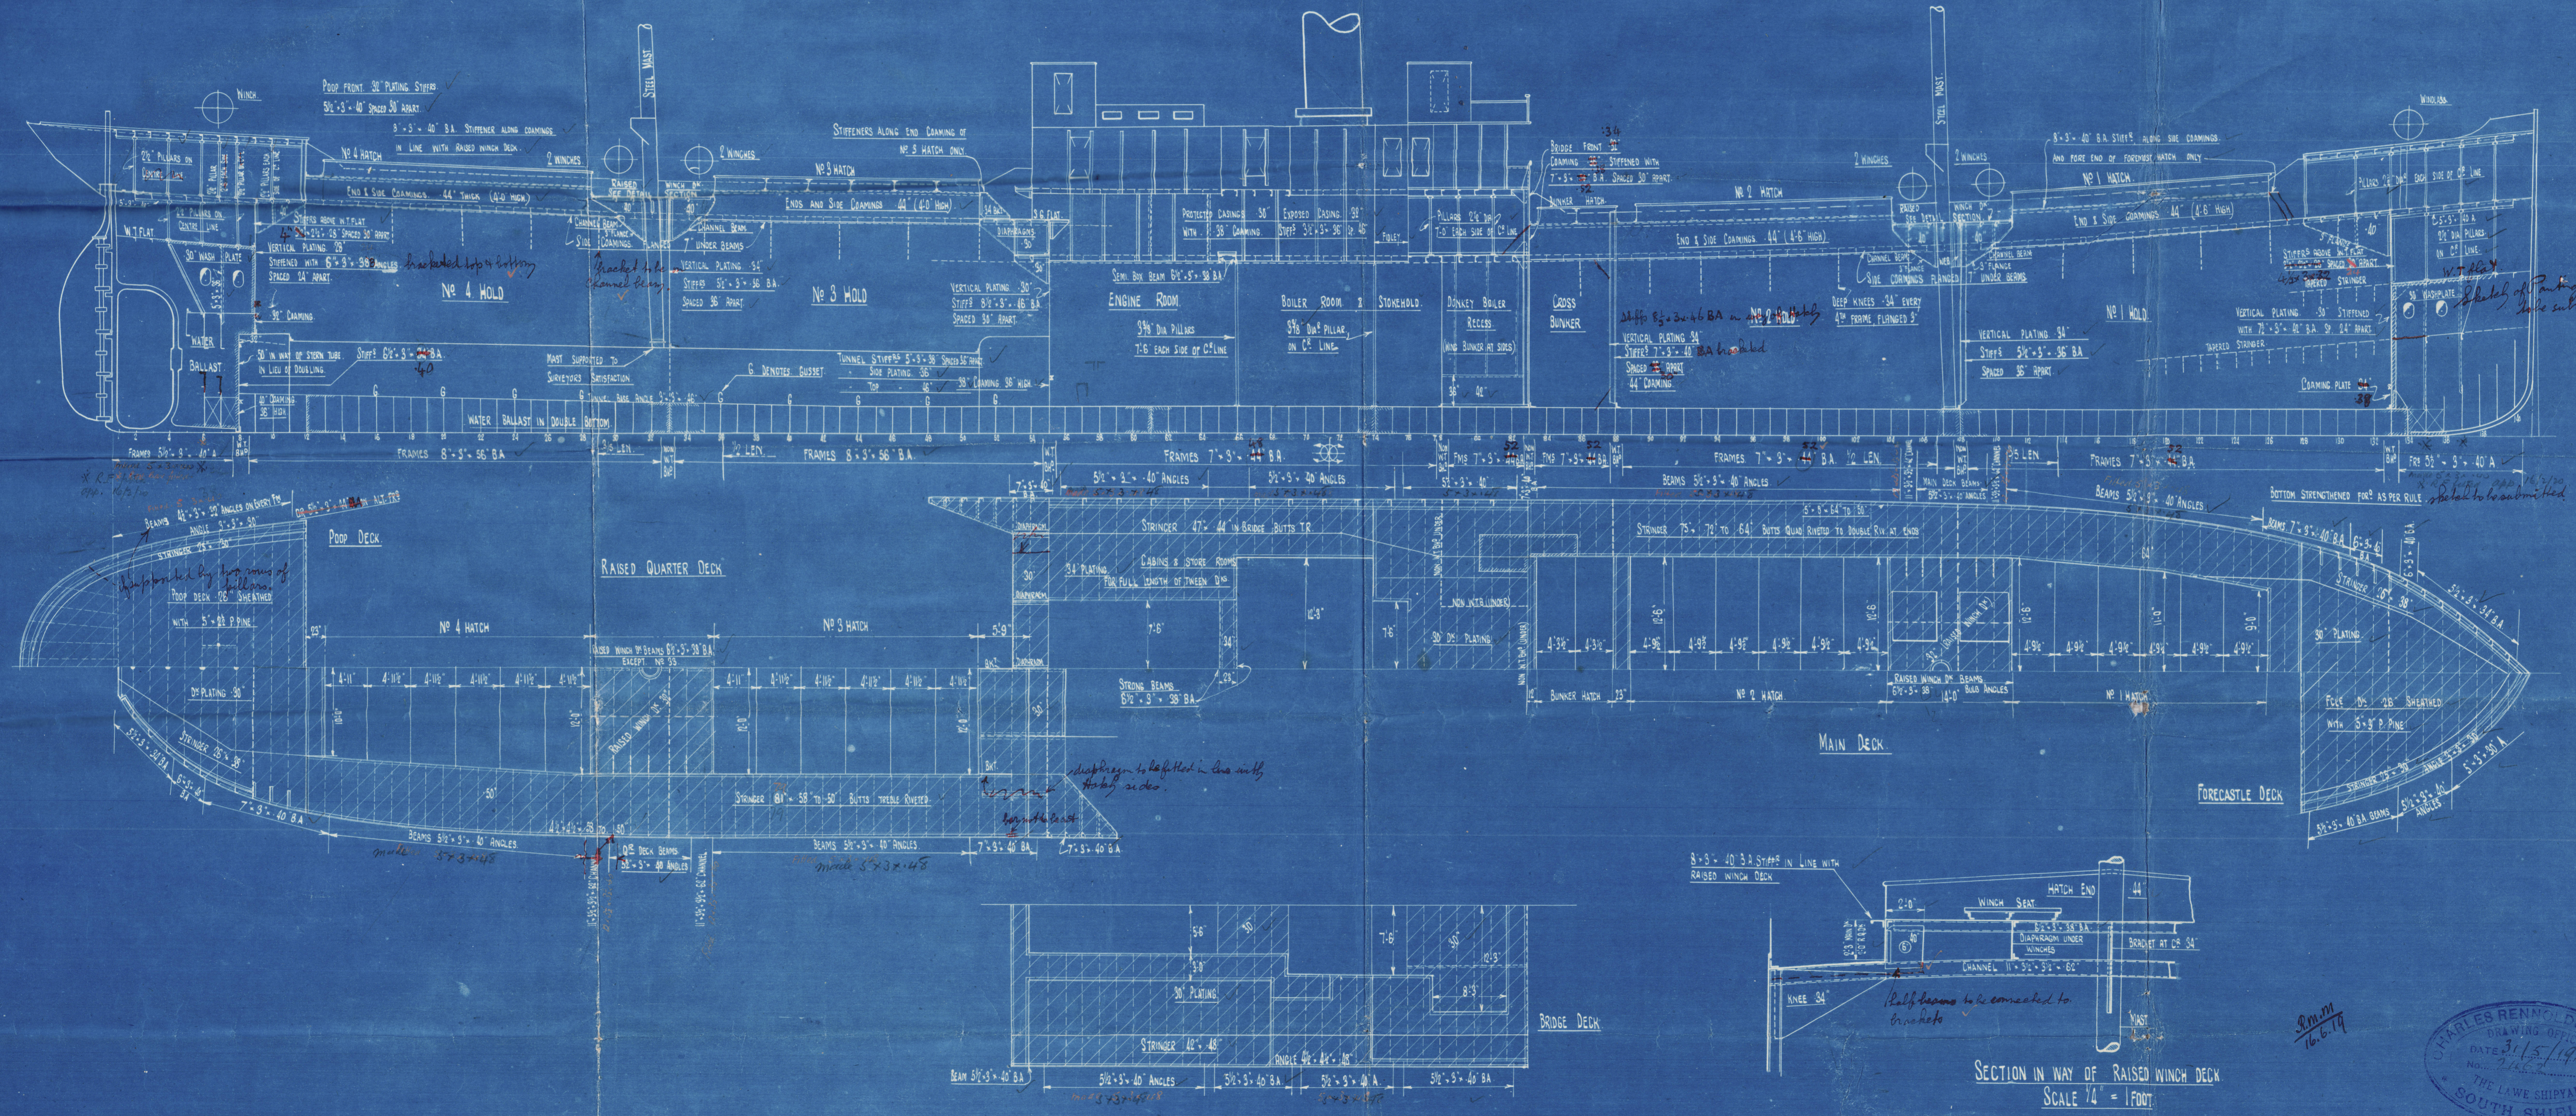

C Remoldson Co

185-

Profile and Deck Plans

J. P. INSTON
NEWCASTLE ON TYNE,


Report No.

44084

hise

007762-007769-0003

© 2020

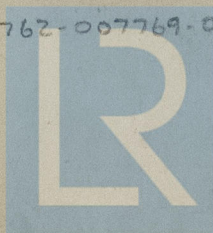

Lloyd's Register
Foundation