


4.8.03

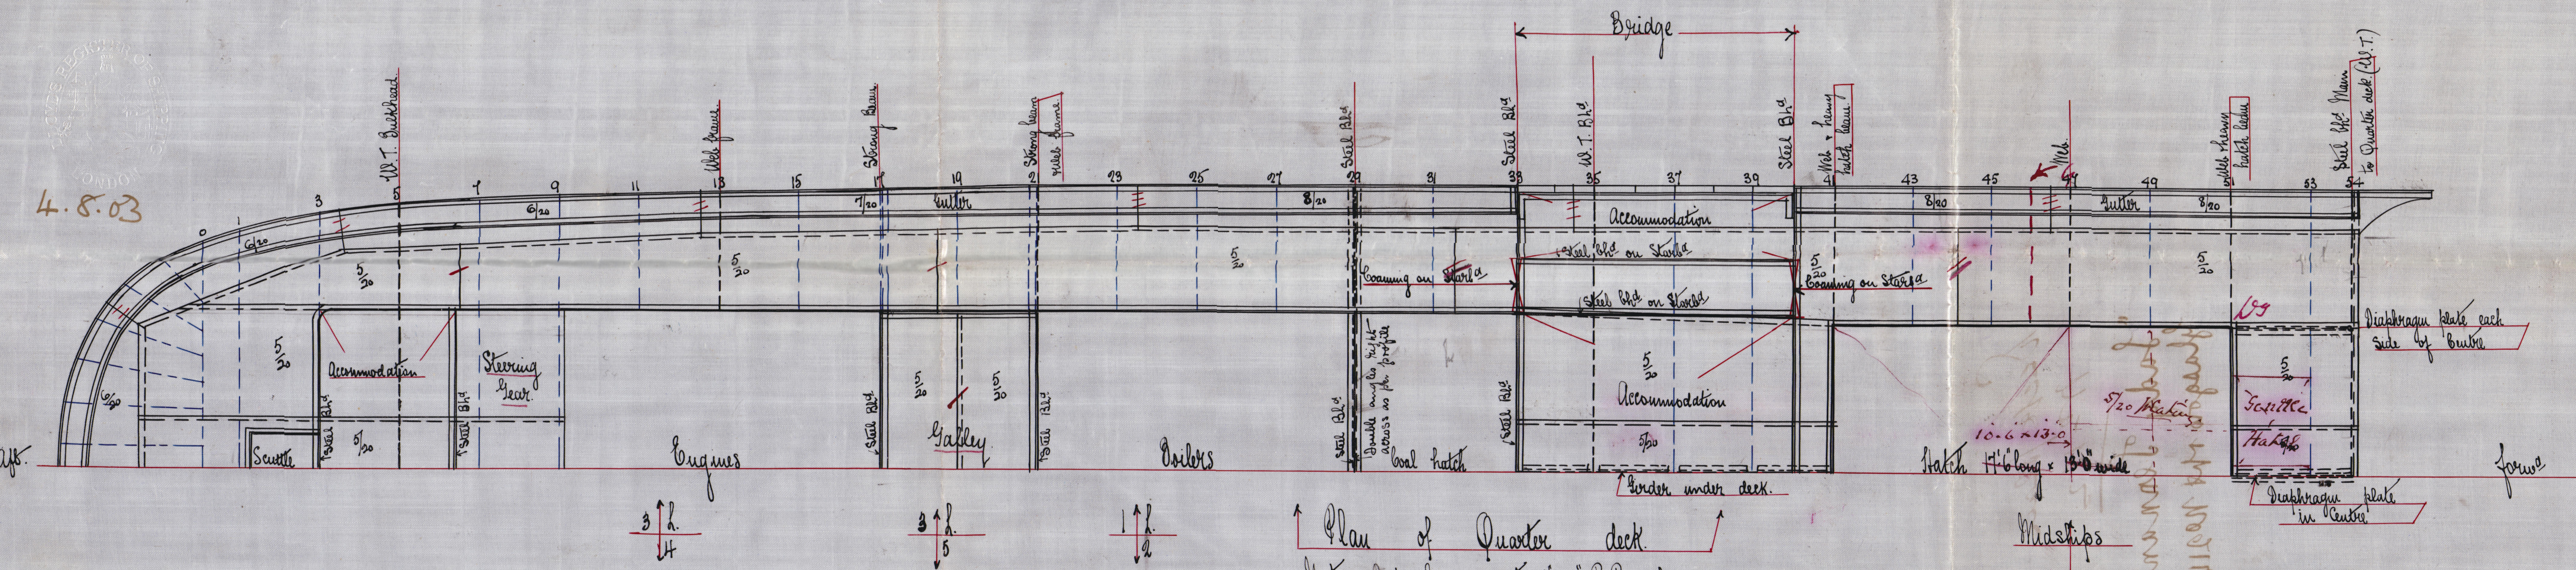

Quarter deck Notes.

Stringer plate 24" x 5/16" to 20" x 5/16" Bulbs overlapped and bubble riveted for 1/2 l. remainder double.
Deck plating 5/16" Bulbs overlapped & single riveted.
Landings all single riveted.


Note

Bulbs marked thus:
 // Bubble riveted
 // double "
 / Single "

Main deck Notes.

Stringer plate 24" x 5/16" to 20" x 5/16" Bulbs overlapped and bubble riveted for 1/2 l. remainder double.
Deck plating 5/16" Bulbs all single riveted.
Landings all single riveted.

Plan of Main deck
Deck laid with 5" x 3" P.P.

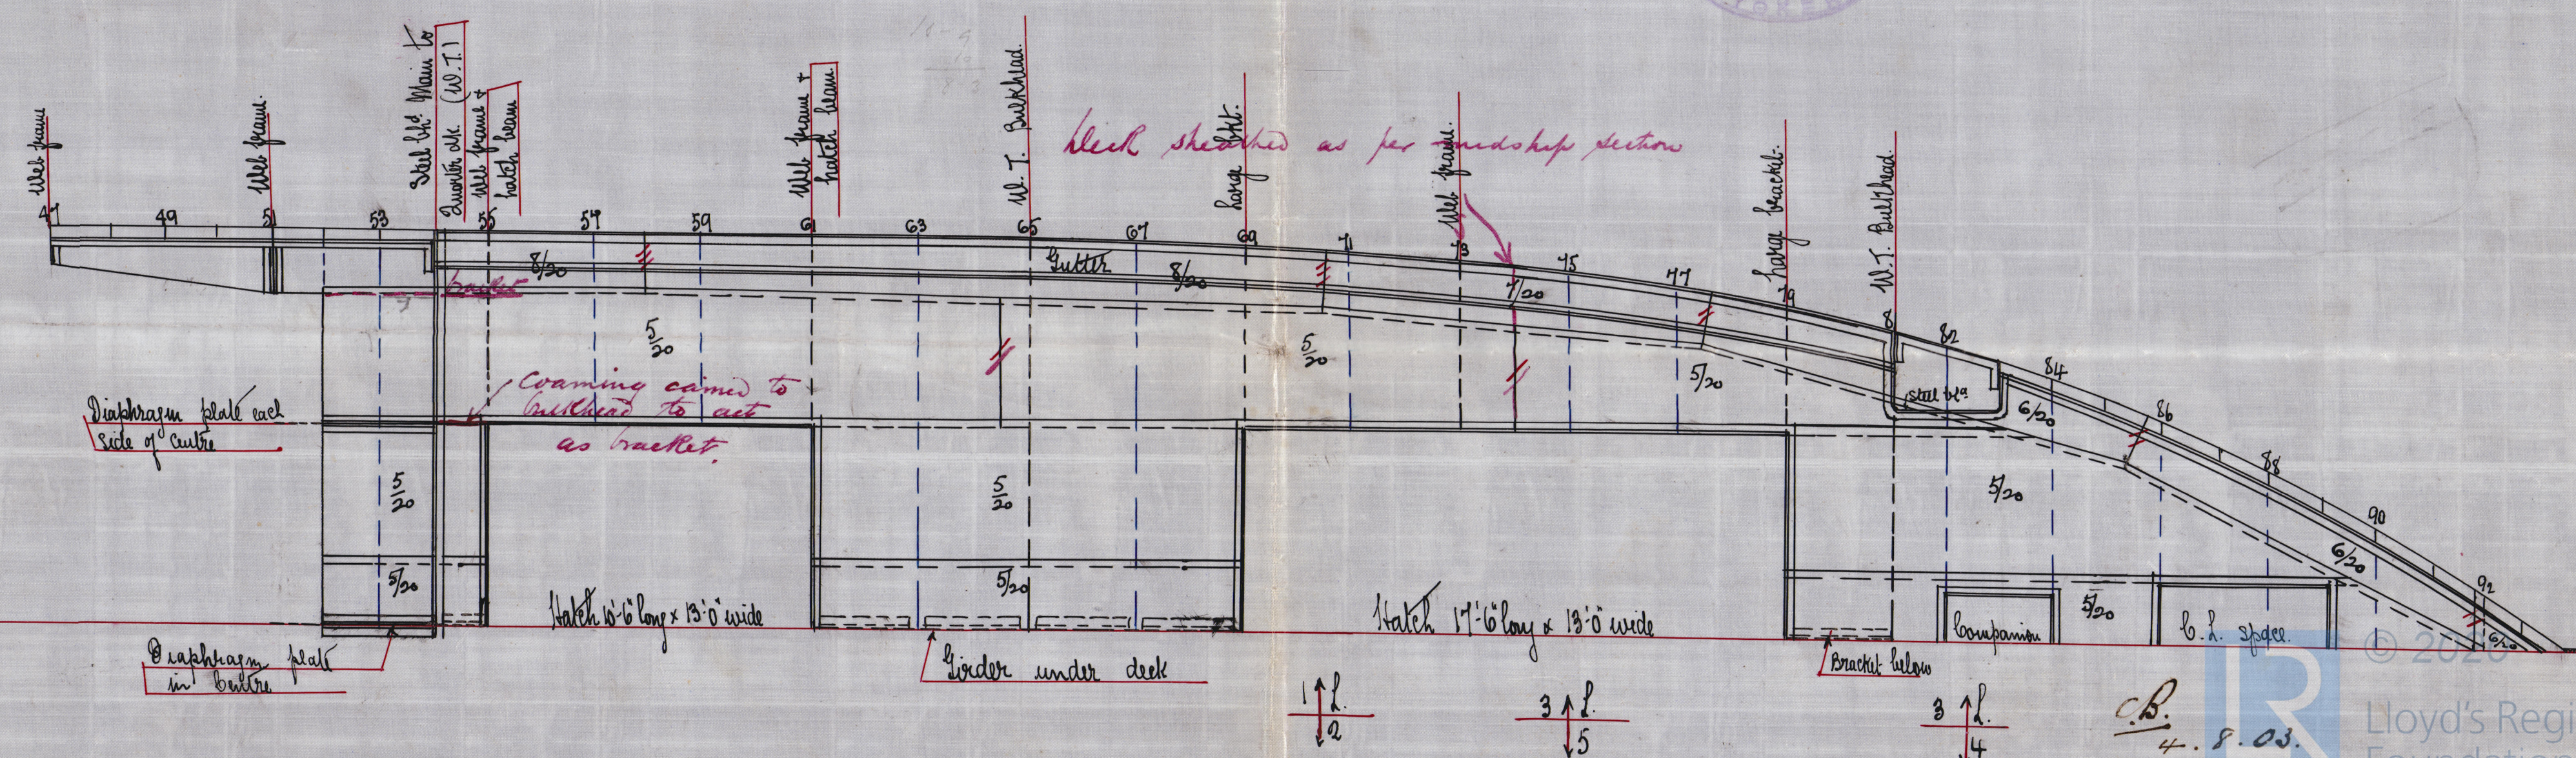

N^o 132. S.S.

Quarter and Main deck plating plans.
Scale 1/4" per foot.



Deck plan
No 132

"Lady Tennant"
Glasgow No 21454

007762-007769-0203

LR

© 2020

Lloyd's Register
Foundation