

25-2-13  
13-3-13  
2-4-13

# Midship-section. of a Steel motorvessel to carry oil in bulk.

190'0" x 33'6" x 18'0"

Scale 1/2" = 1'0"

Class + 300 A1 Lloyd's.

## SCANTLING NUMBERS

LLOYD'S BREADTH = 33.5'  
LLOYD'S DEPTH = 10.0  
TRANSVERSE NUMBER (B+D) = 51.5  
LLOYD'S LENGTH = 190  
LONGITUDINAL NUMBER L (B+D) = 9705


## NUMBER:

LLOYD'S BREADTH = 33.5'  
LLOYD'S DEPTH = 10.0  
(B+D) = 51.5  
LLOYD'S LENGTH = 190  
L (B+D) = 9705  
INCREASING FOR REGIONS  
1/4 x 23 x 6.75 = 100  
1/4 x 23 x 6.75 = 77.6  
1/4 x 23 x 6.75 = 276.42  
1/2 x 23 x 4 = 249.2  
10493.2  
10453.8

## EQUIPMENT

## ANCHORS:

1 BOWER STOCKLESS: 22 cwt.  
2 " " " " : 20 "  
2 " " " " : 18.5 "  
1 STREAM : 7.19 "  
1 KEDGE : 3.44 "  
STUD CHAIN CABLE : 210 FATHOMS 1 1/16 "  
STREAM CHAIN : 60 " 1 1/16 "  
TOWLINE STEEL WIRE: 90 " 3 "  
HAWERS MANILLA: 90 " 6 "  
WARPS " " : 90 " 5 "


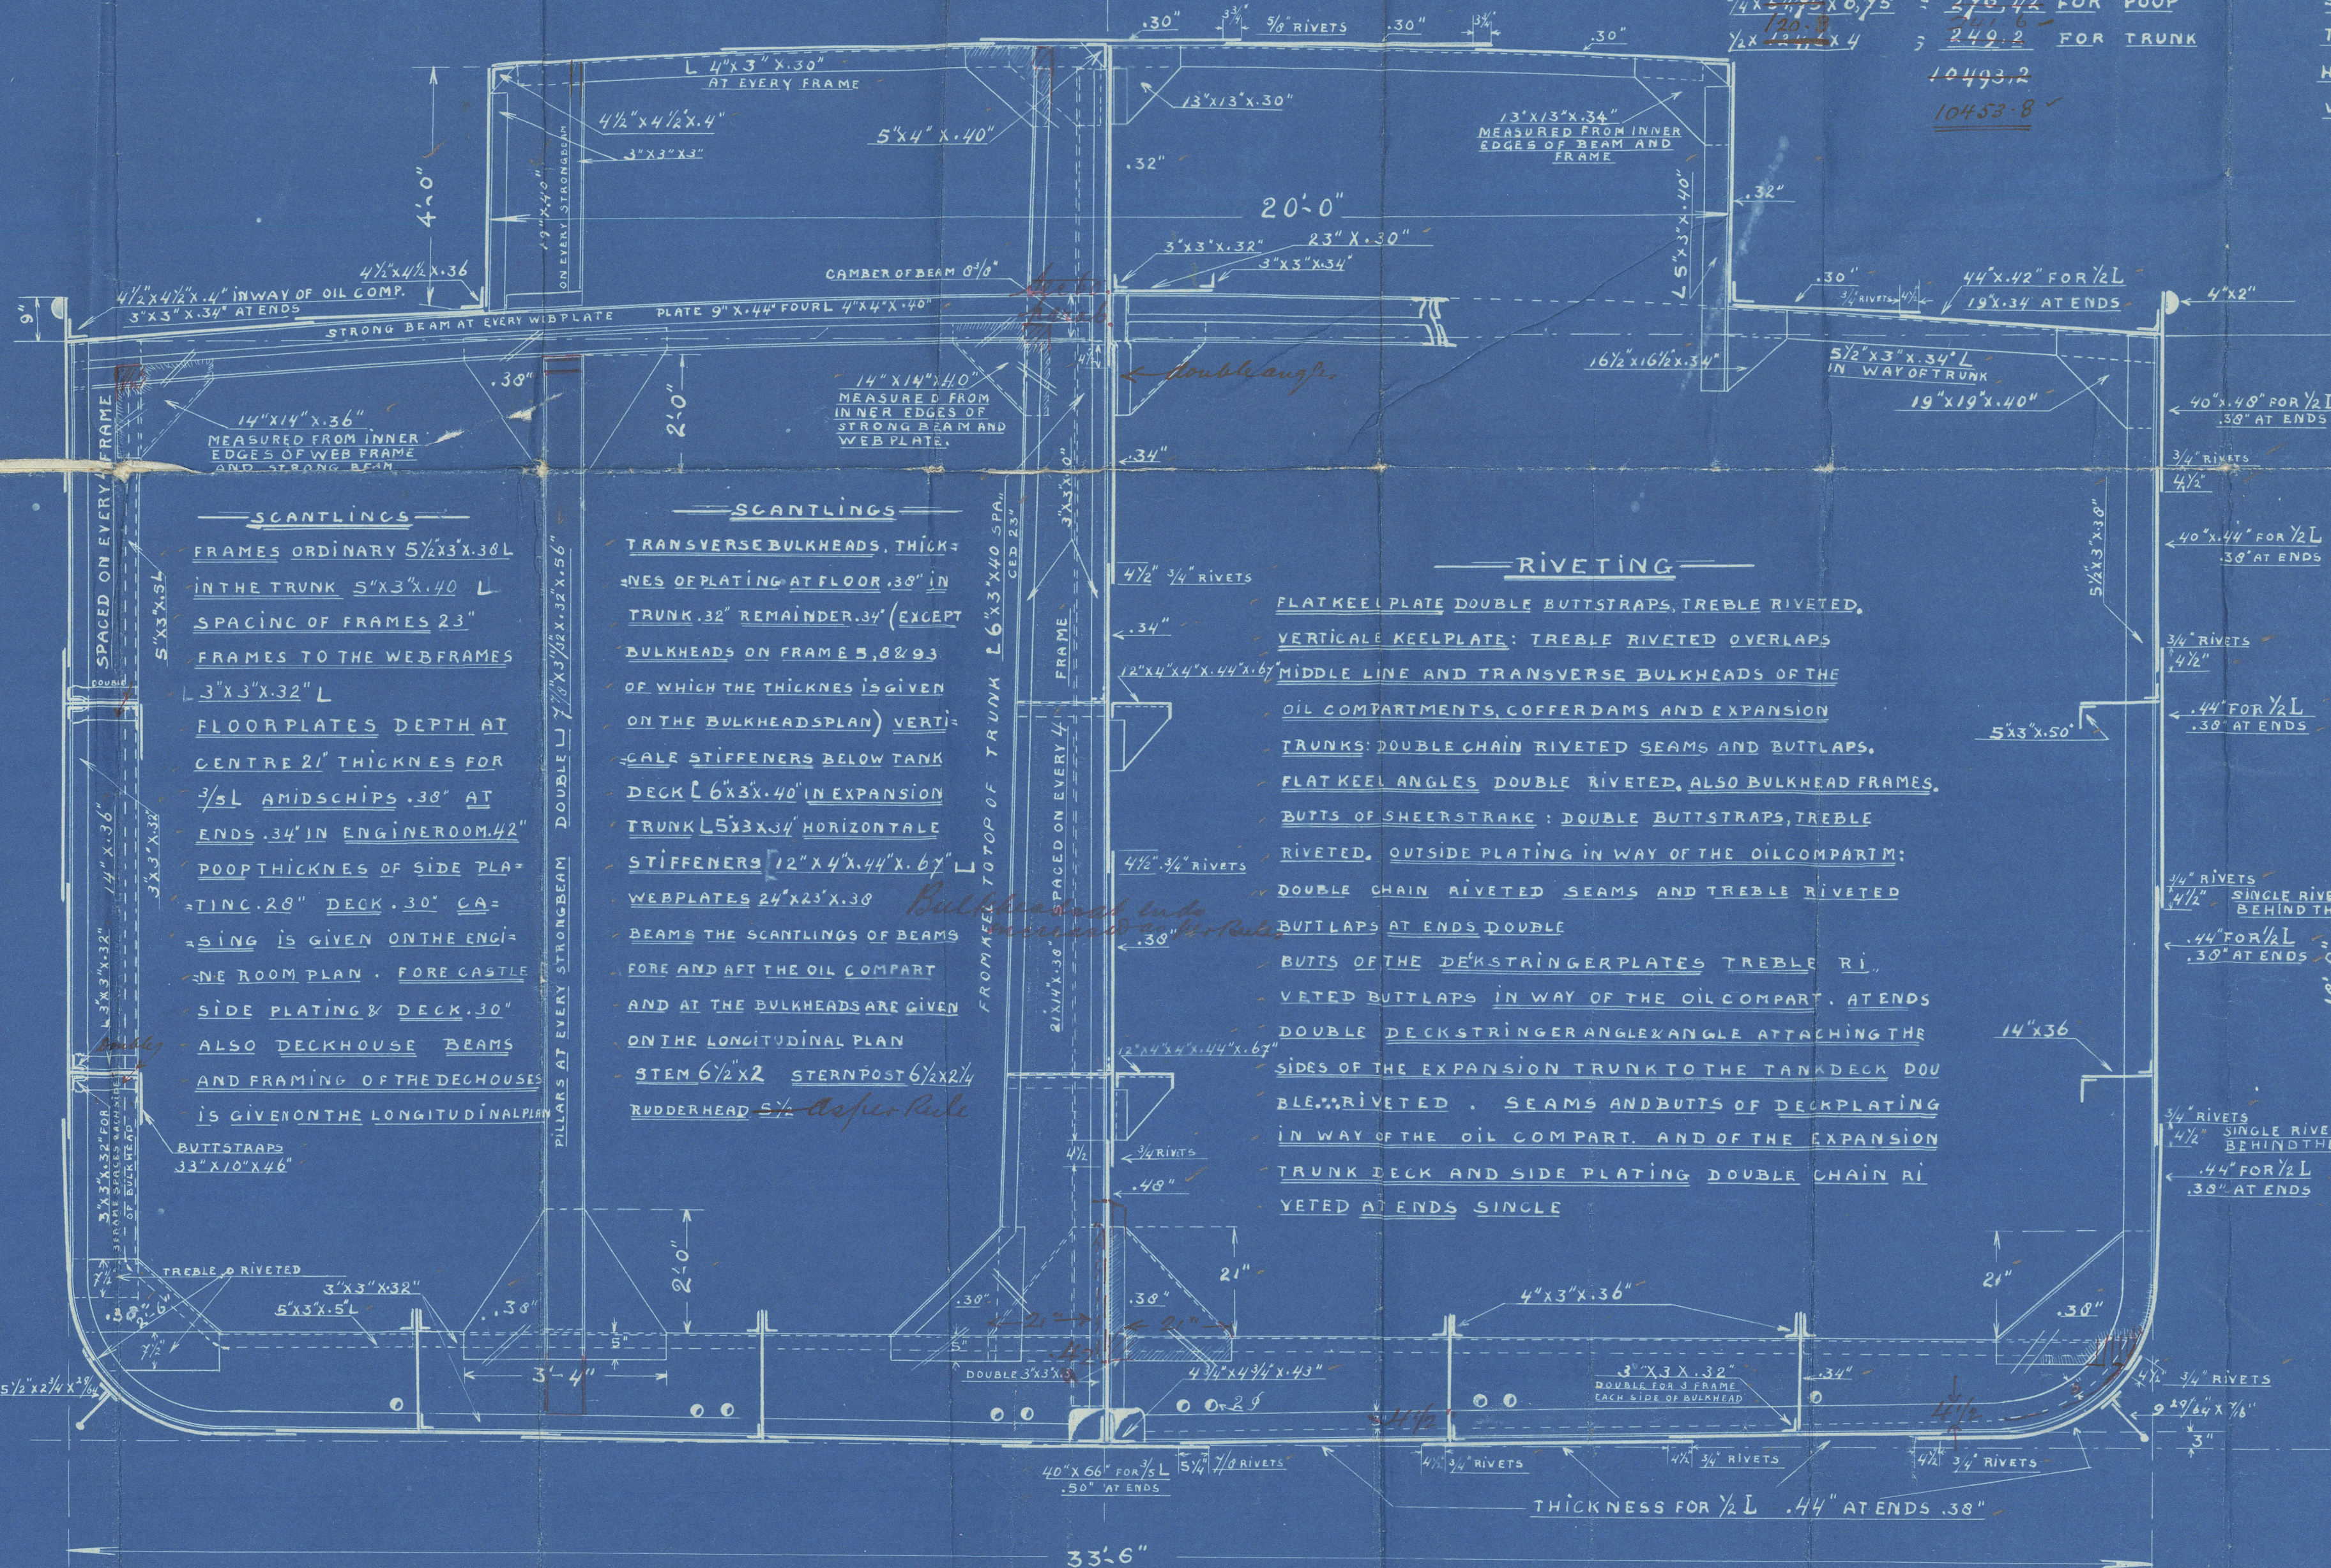


BN<sup>o</sup> 682.





682  
fractopant  
ml

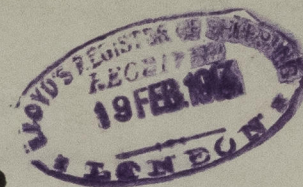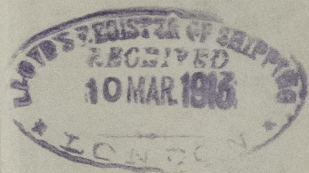

Plan of Midship Section  
Twin Screw Motor Gallia  
Adam report. no. 9102



007770-007782-0243



© 2021

Lloyd's Register  
Foundation



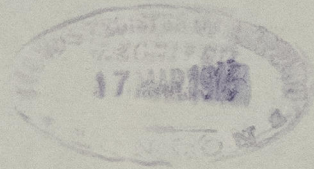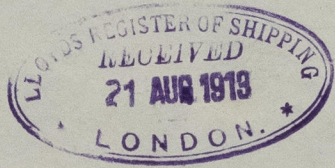

© 2021

Lloyd's Register  
Foundation