

Steel Motorvessel to carry oil in bulk No 682.
 190'-0" x 33'-6" x 18'-0" Class + 100 AI Lloyds.

Rudder and Sternpost.


Scale 1" = 1 Foot.

Speed not exceeding 10 knots




Quadrant.

STEERING CHAIN 3/4"

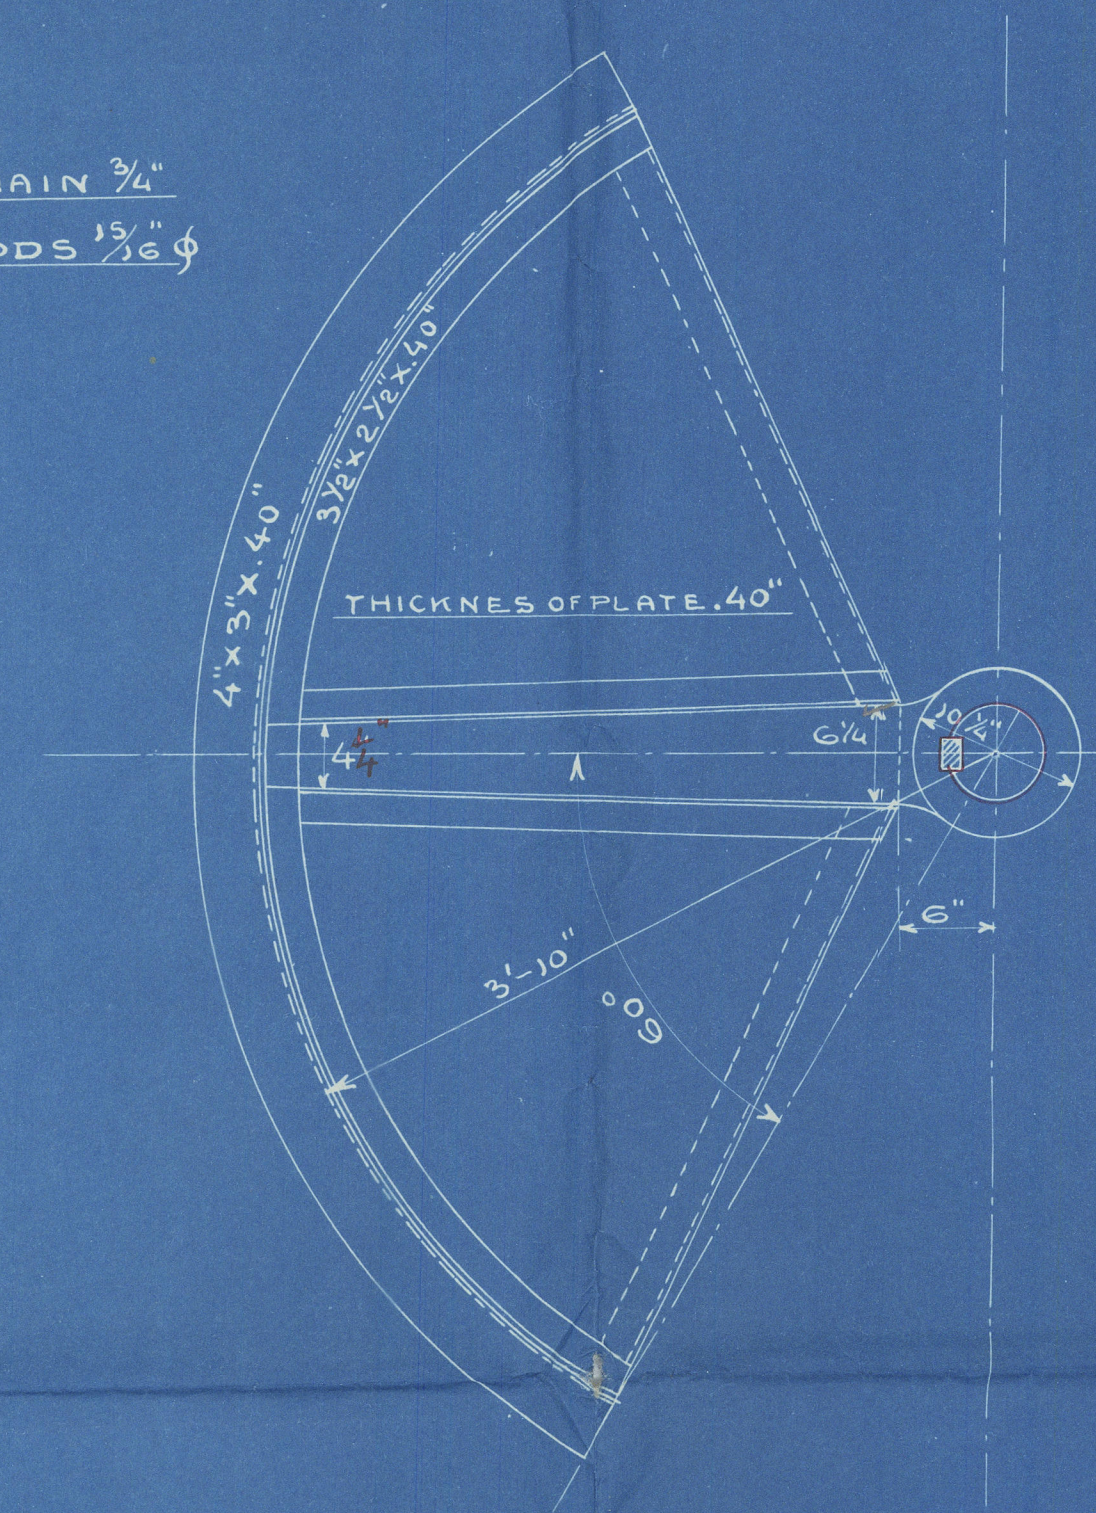


Arm with pintle.


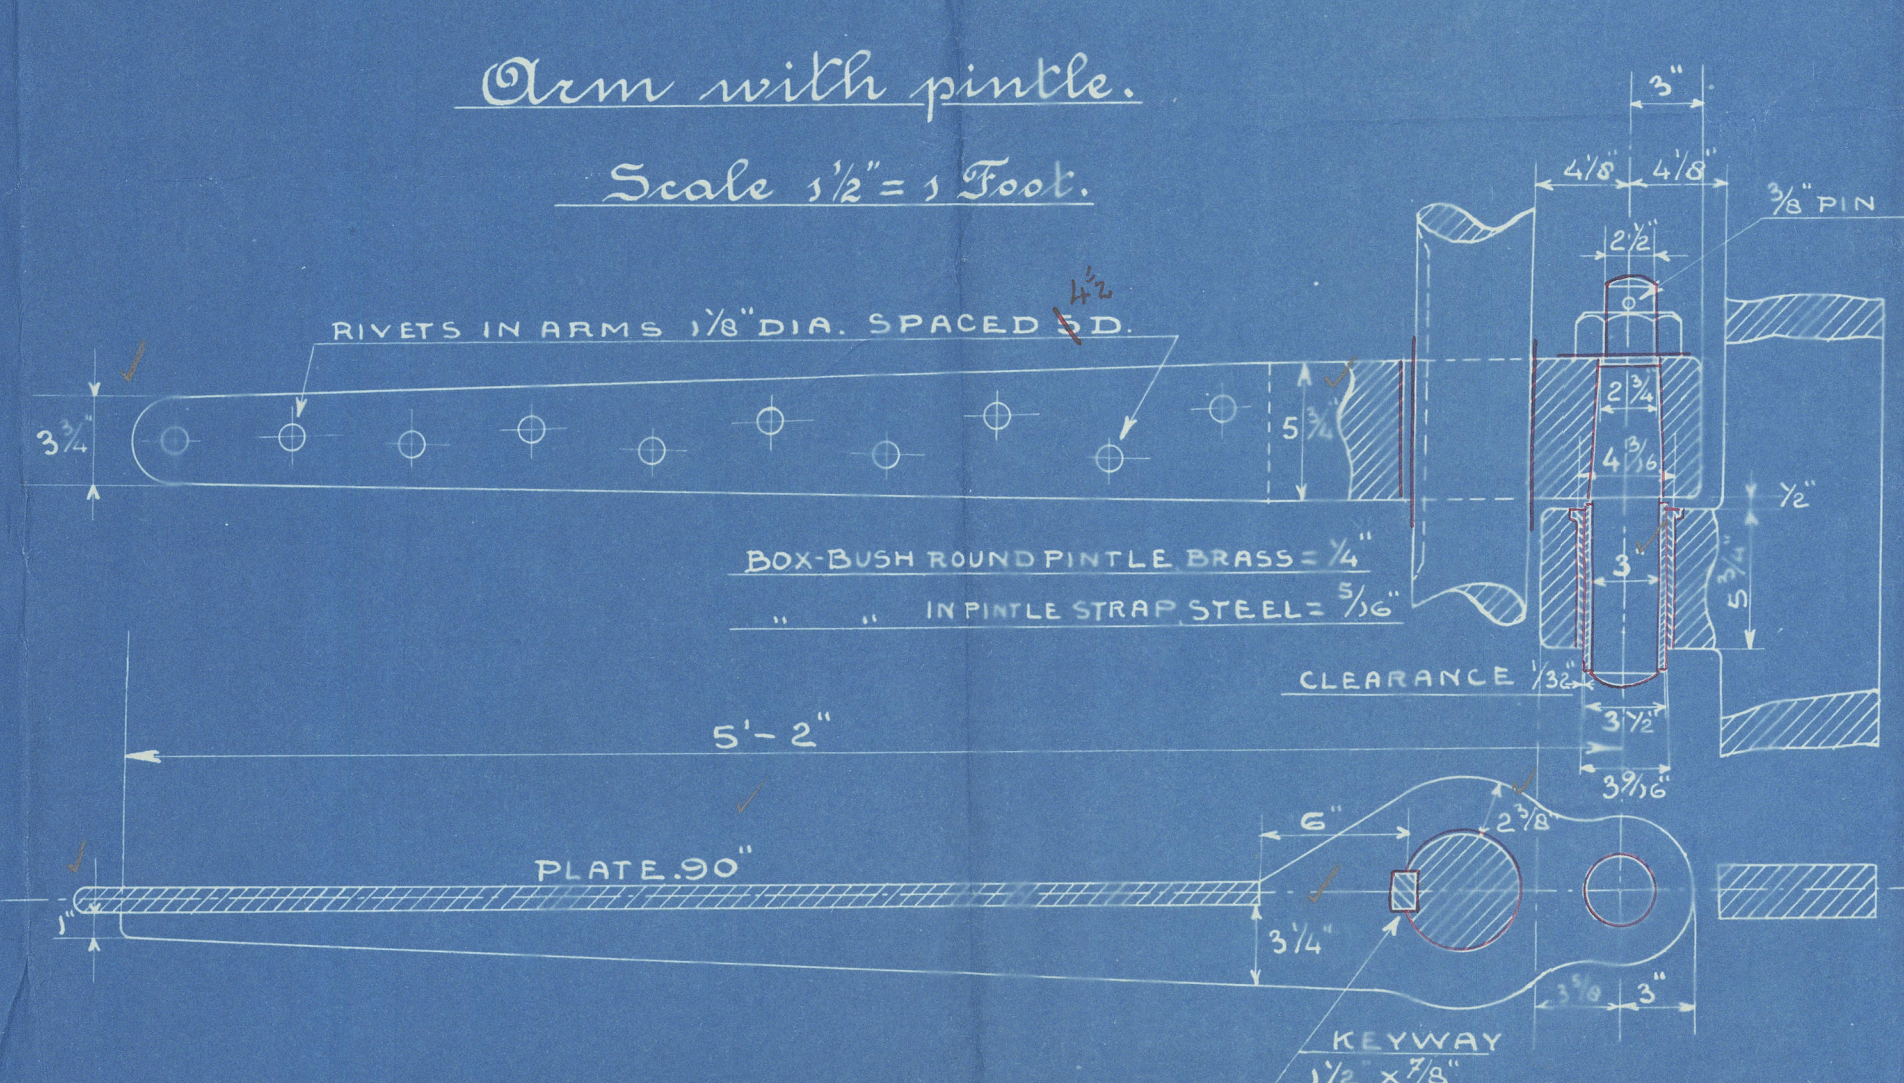



Section through A.B.

Scale 3" = 1 Foot.

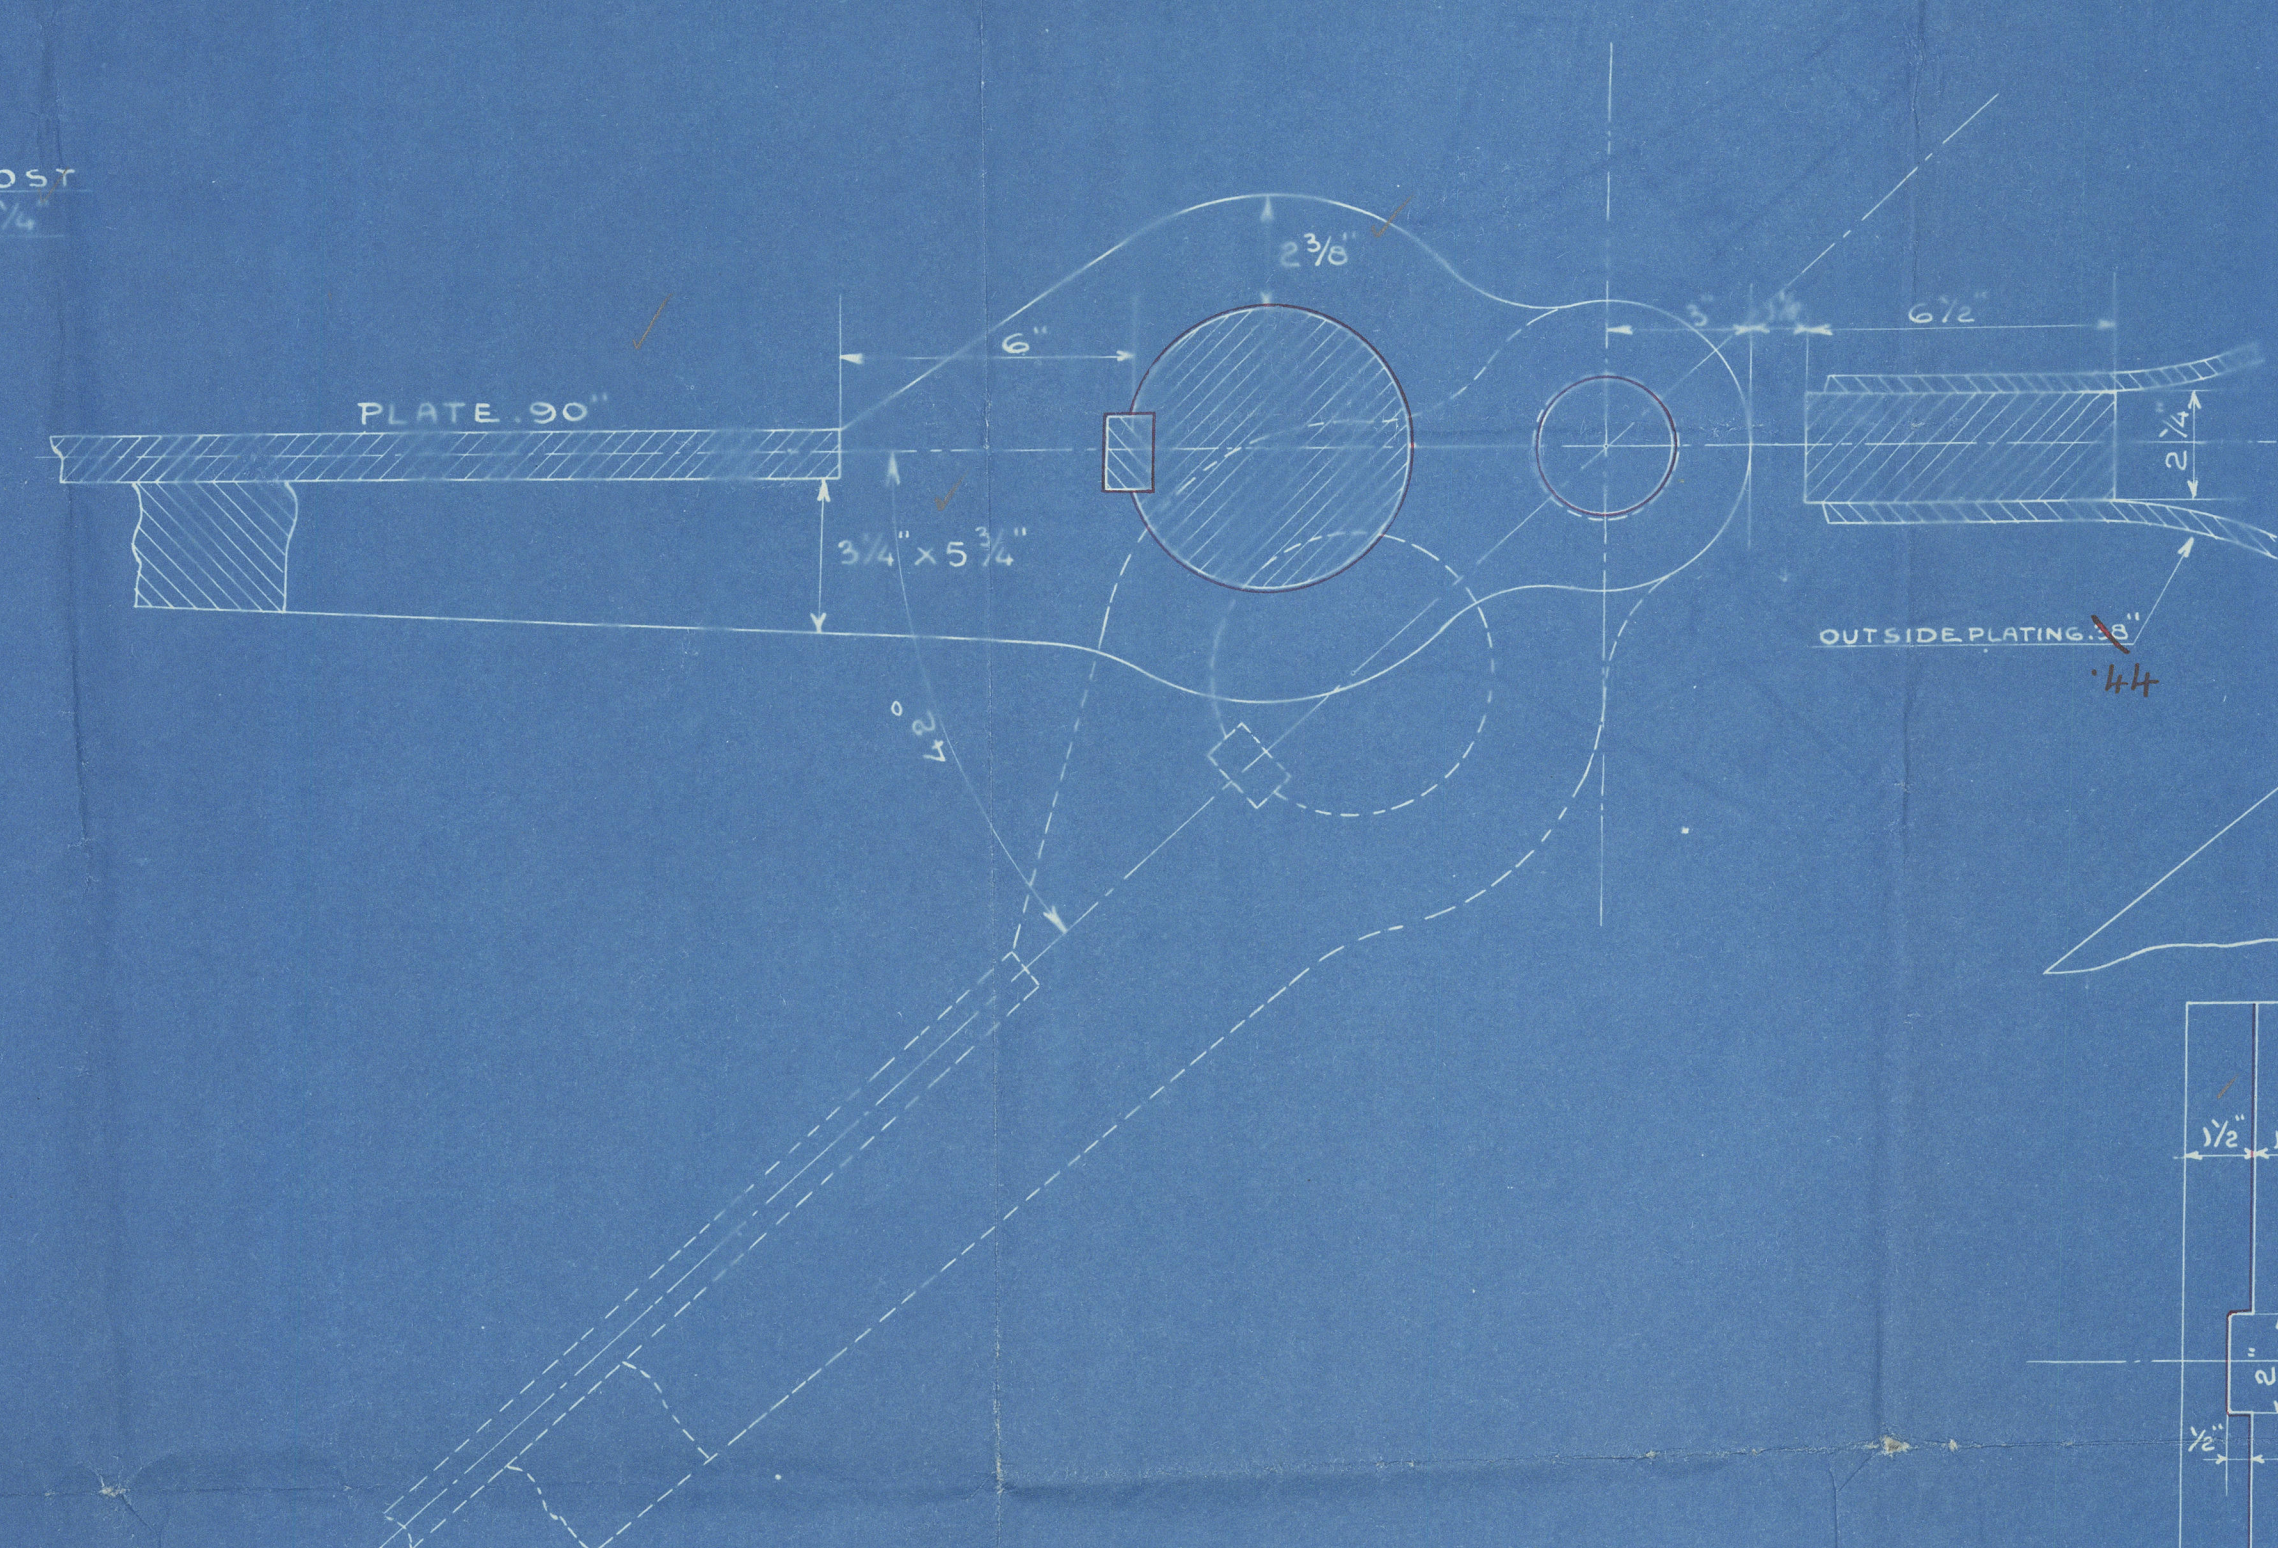

Coupling of rudderhead.

Scale 3" = 1 Foot.

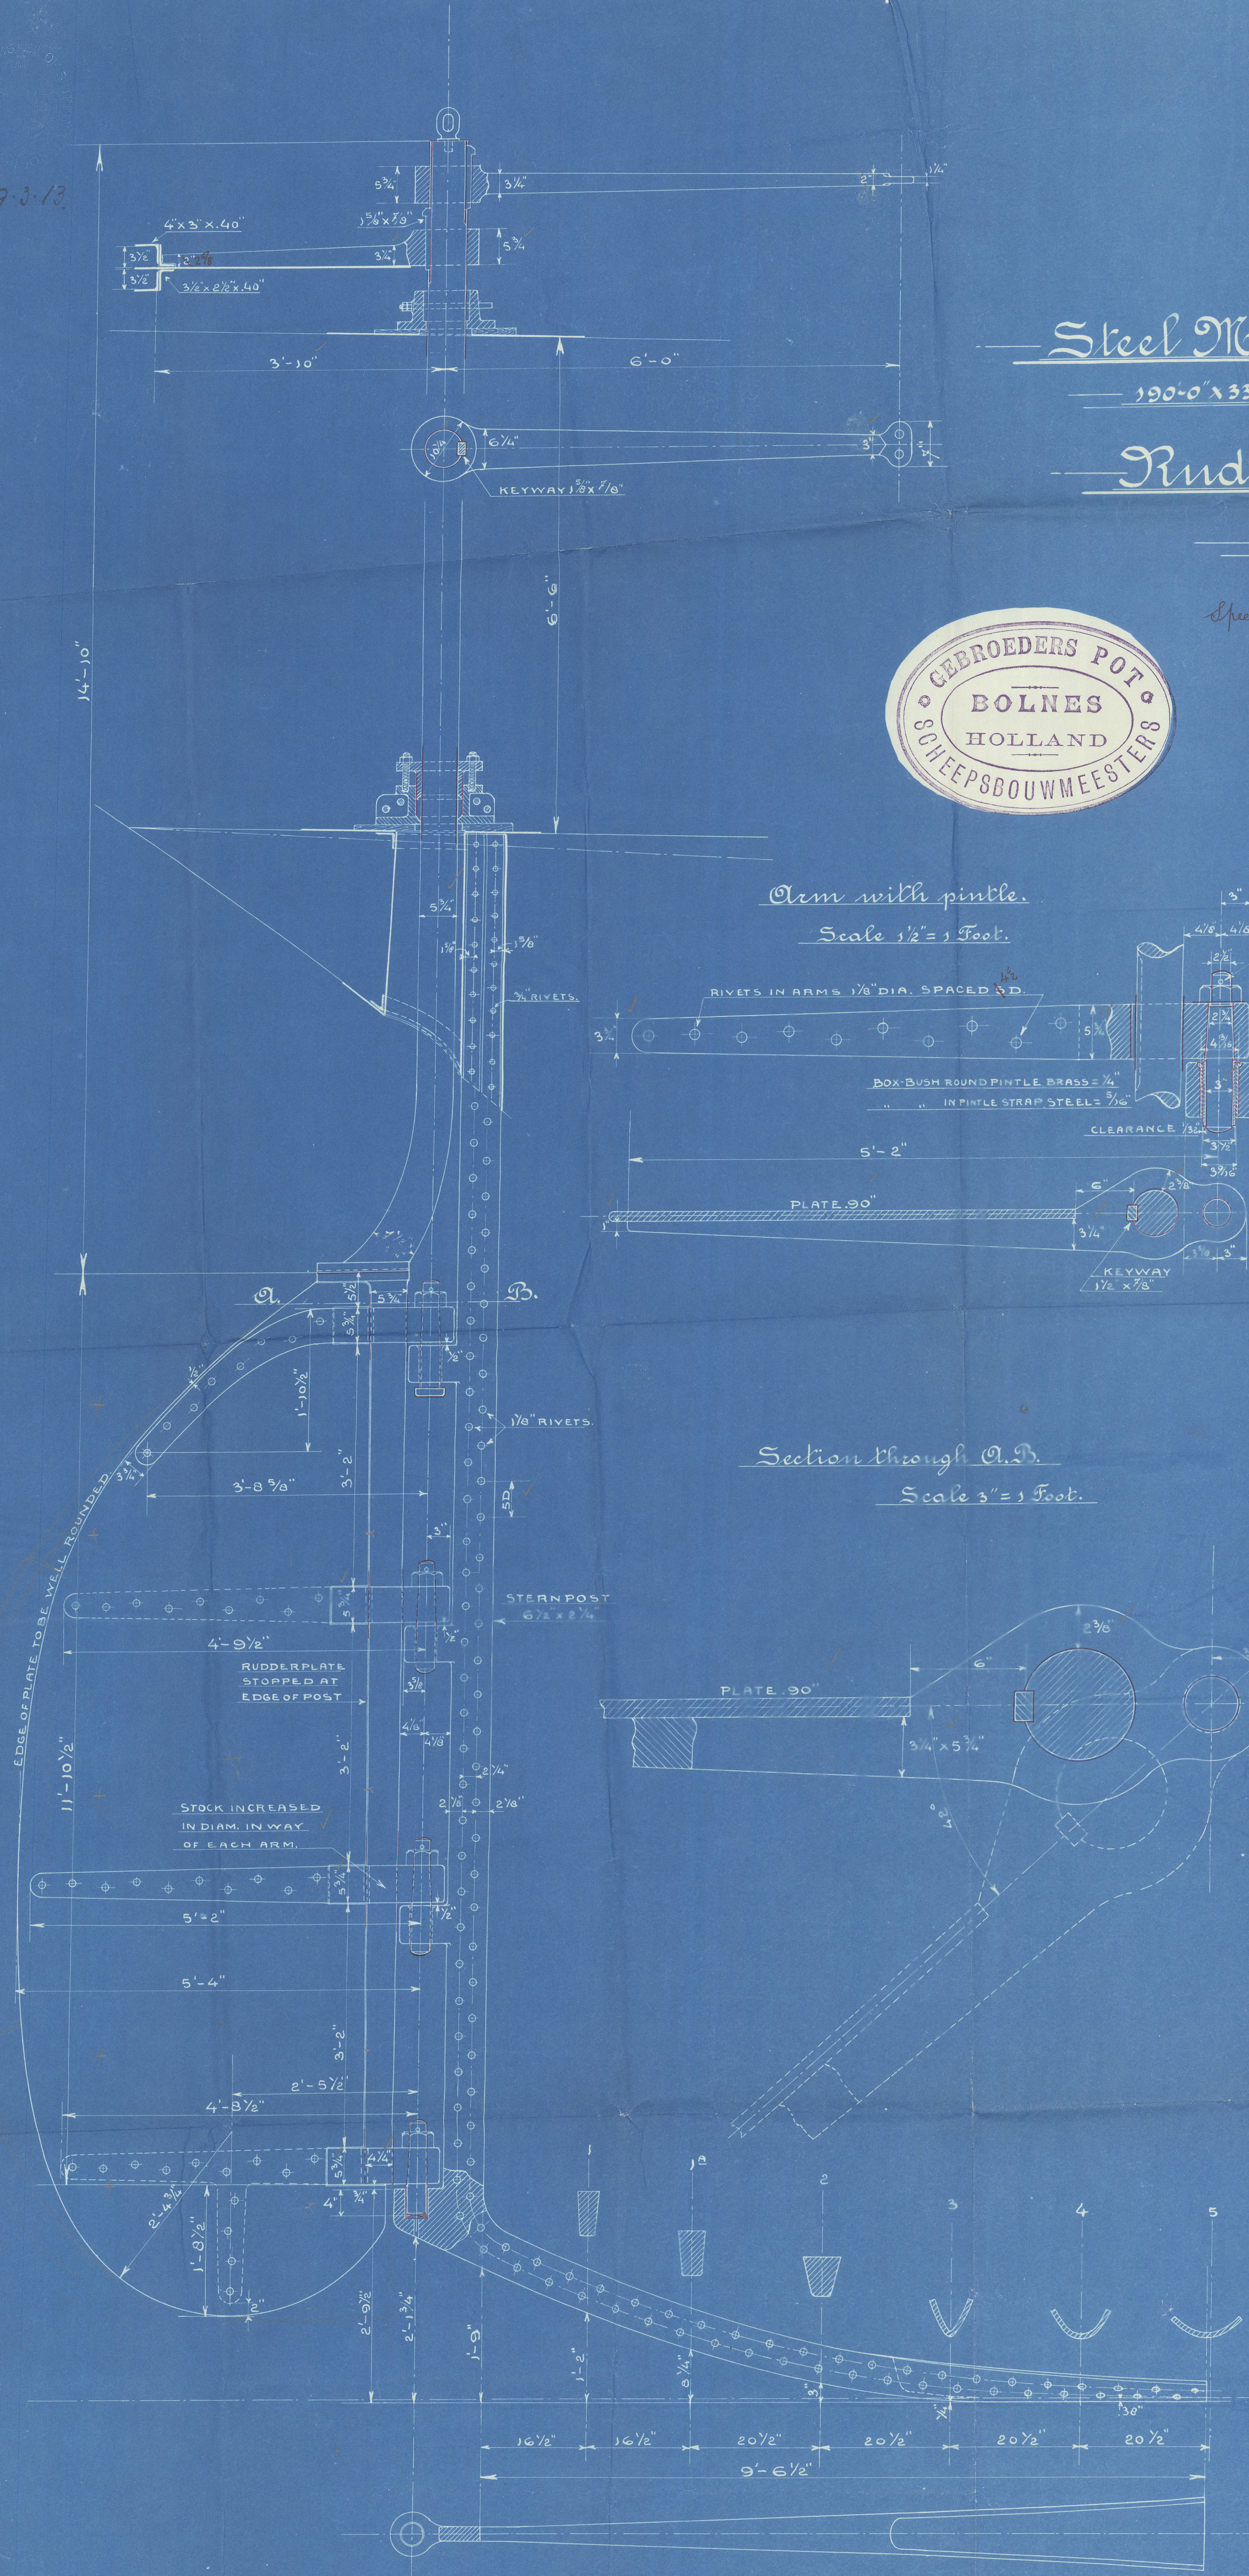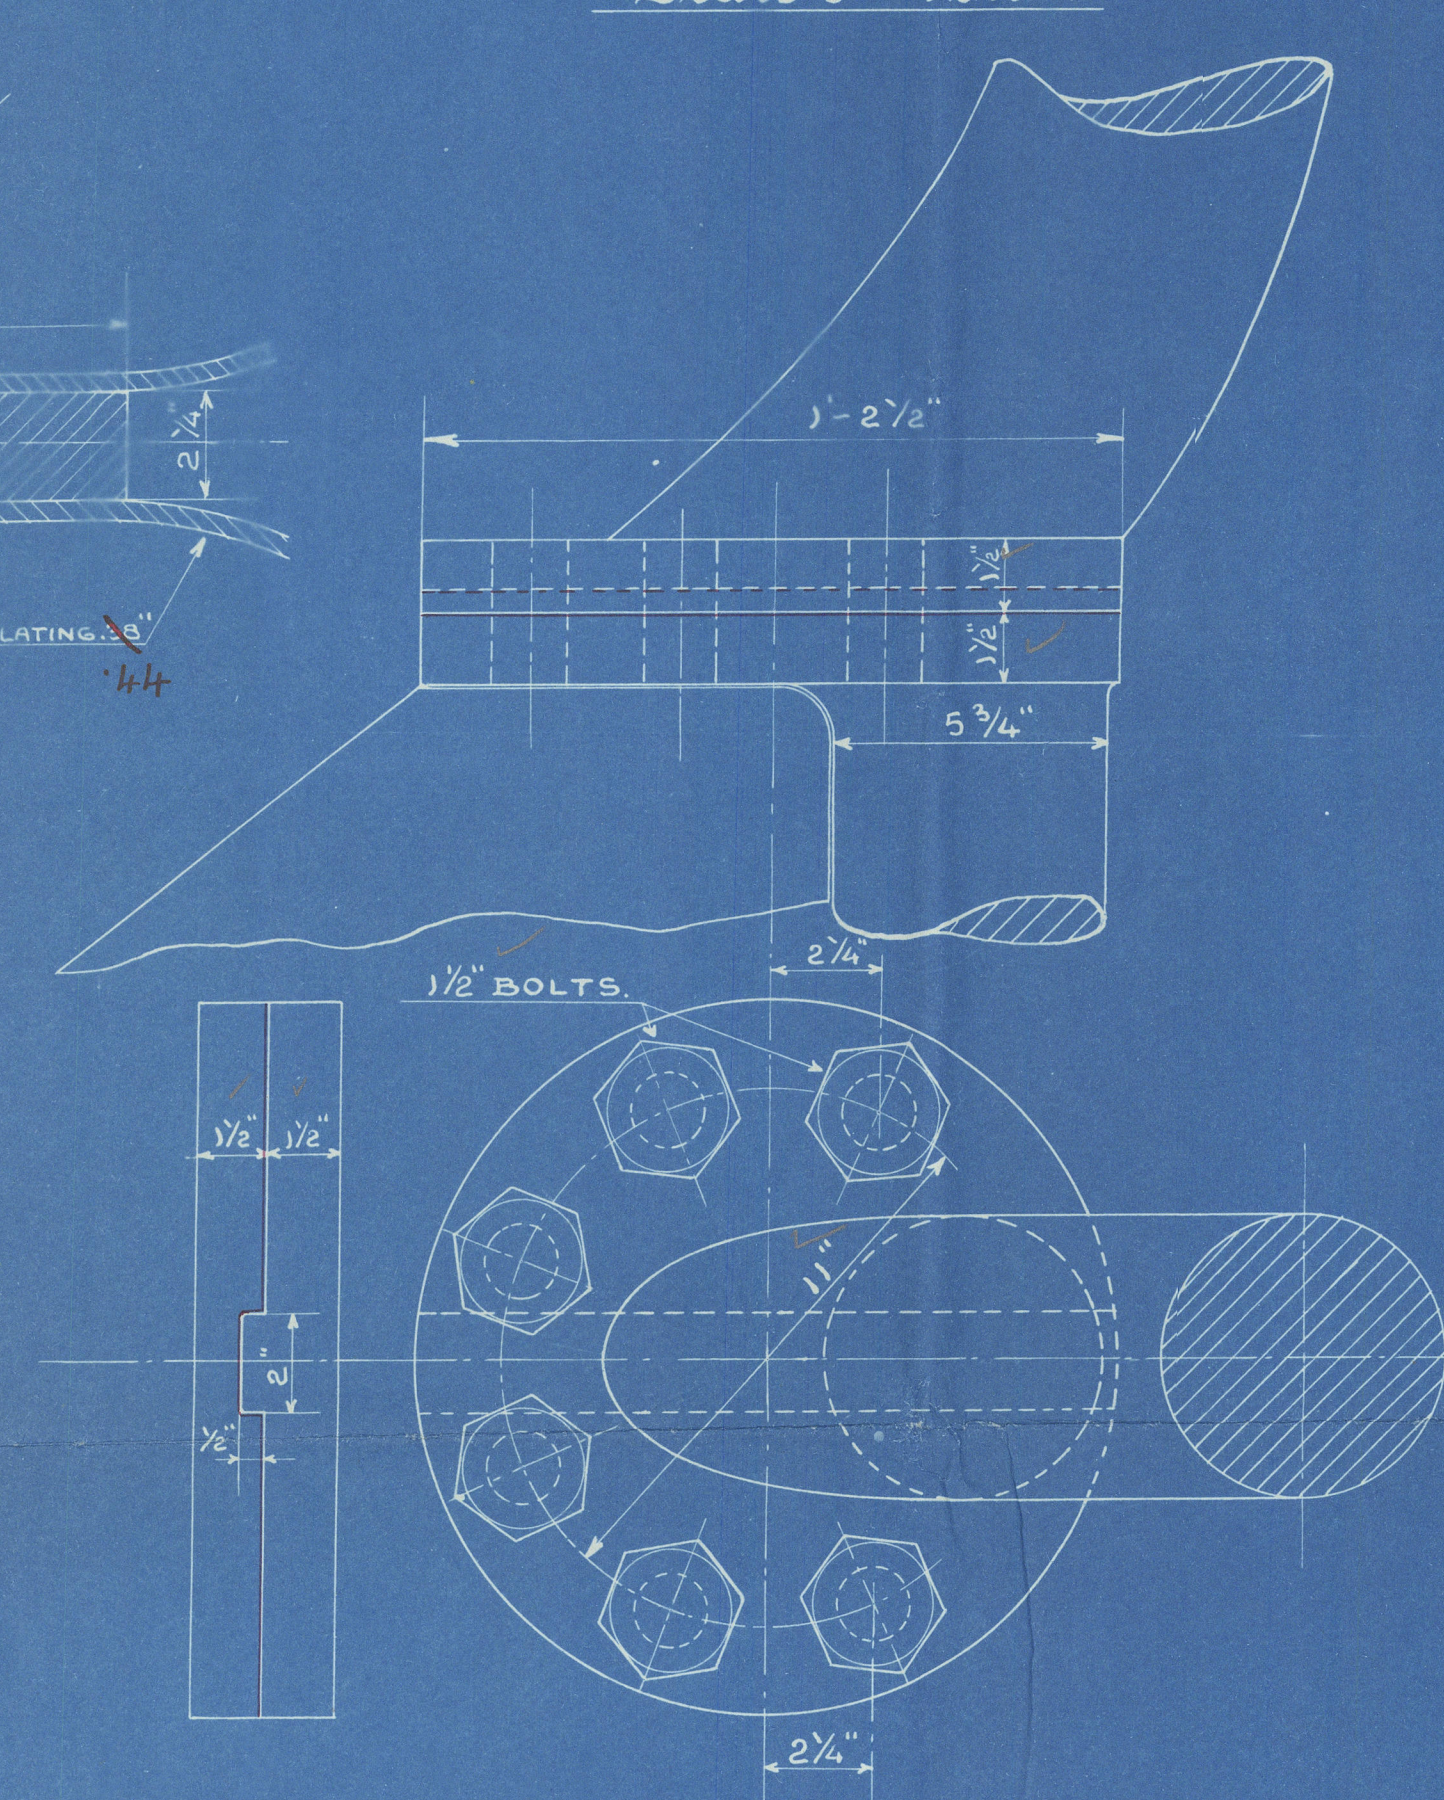



No 5215.
 5-3-1913.

1913

Plan of Rudder and Stern frame

Twin Screw. motor Gallic

Boat report. no. 9102^a

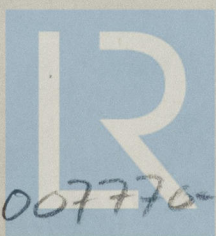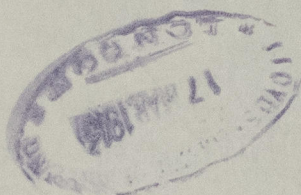

© 2021

Lloyd's Register
Foundation

007770-007782-0245