

MOUNSEY & FOSTER,
IRON SHIP BUILDERS,
SOUTH DOCK,
SUNDERLAND.

| Name | No | Report |
|-----------------|----|------------|
| Baque "Antares" | 75 | Rep 11.250 |
| "Alastor" | 76 | " 11.274 |
| "Alpheta" | 77 | " 11.287 |


April 29th 1875
Recd 30 April 75.
J. New.

MIDSHIP SECTION OF N^{os} 75, 76 & 77

SCALE 1/2 INCH = 1 FOOT

Rec 12/8/75

Flush Decked Vessels, built upon the
same grade as N^o 74.

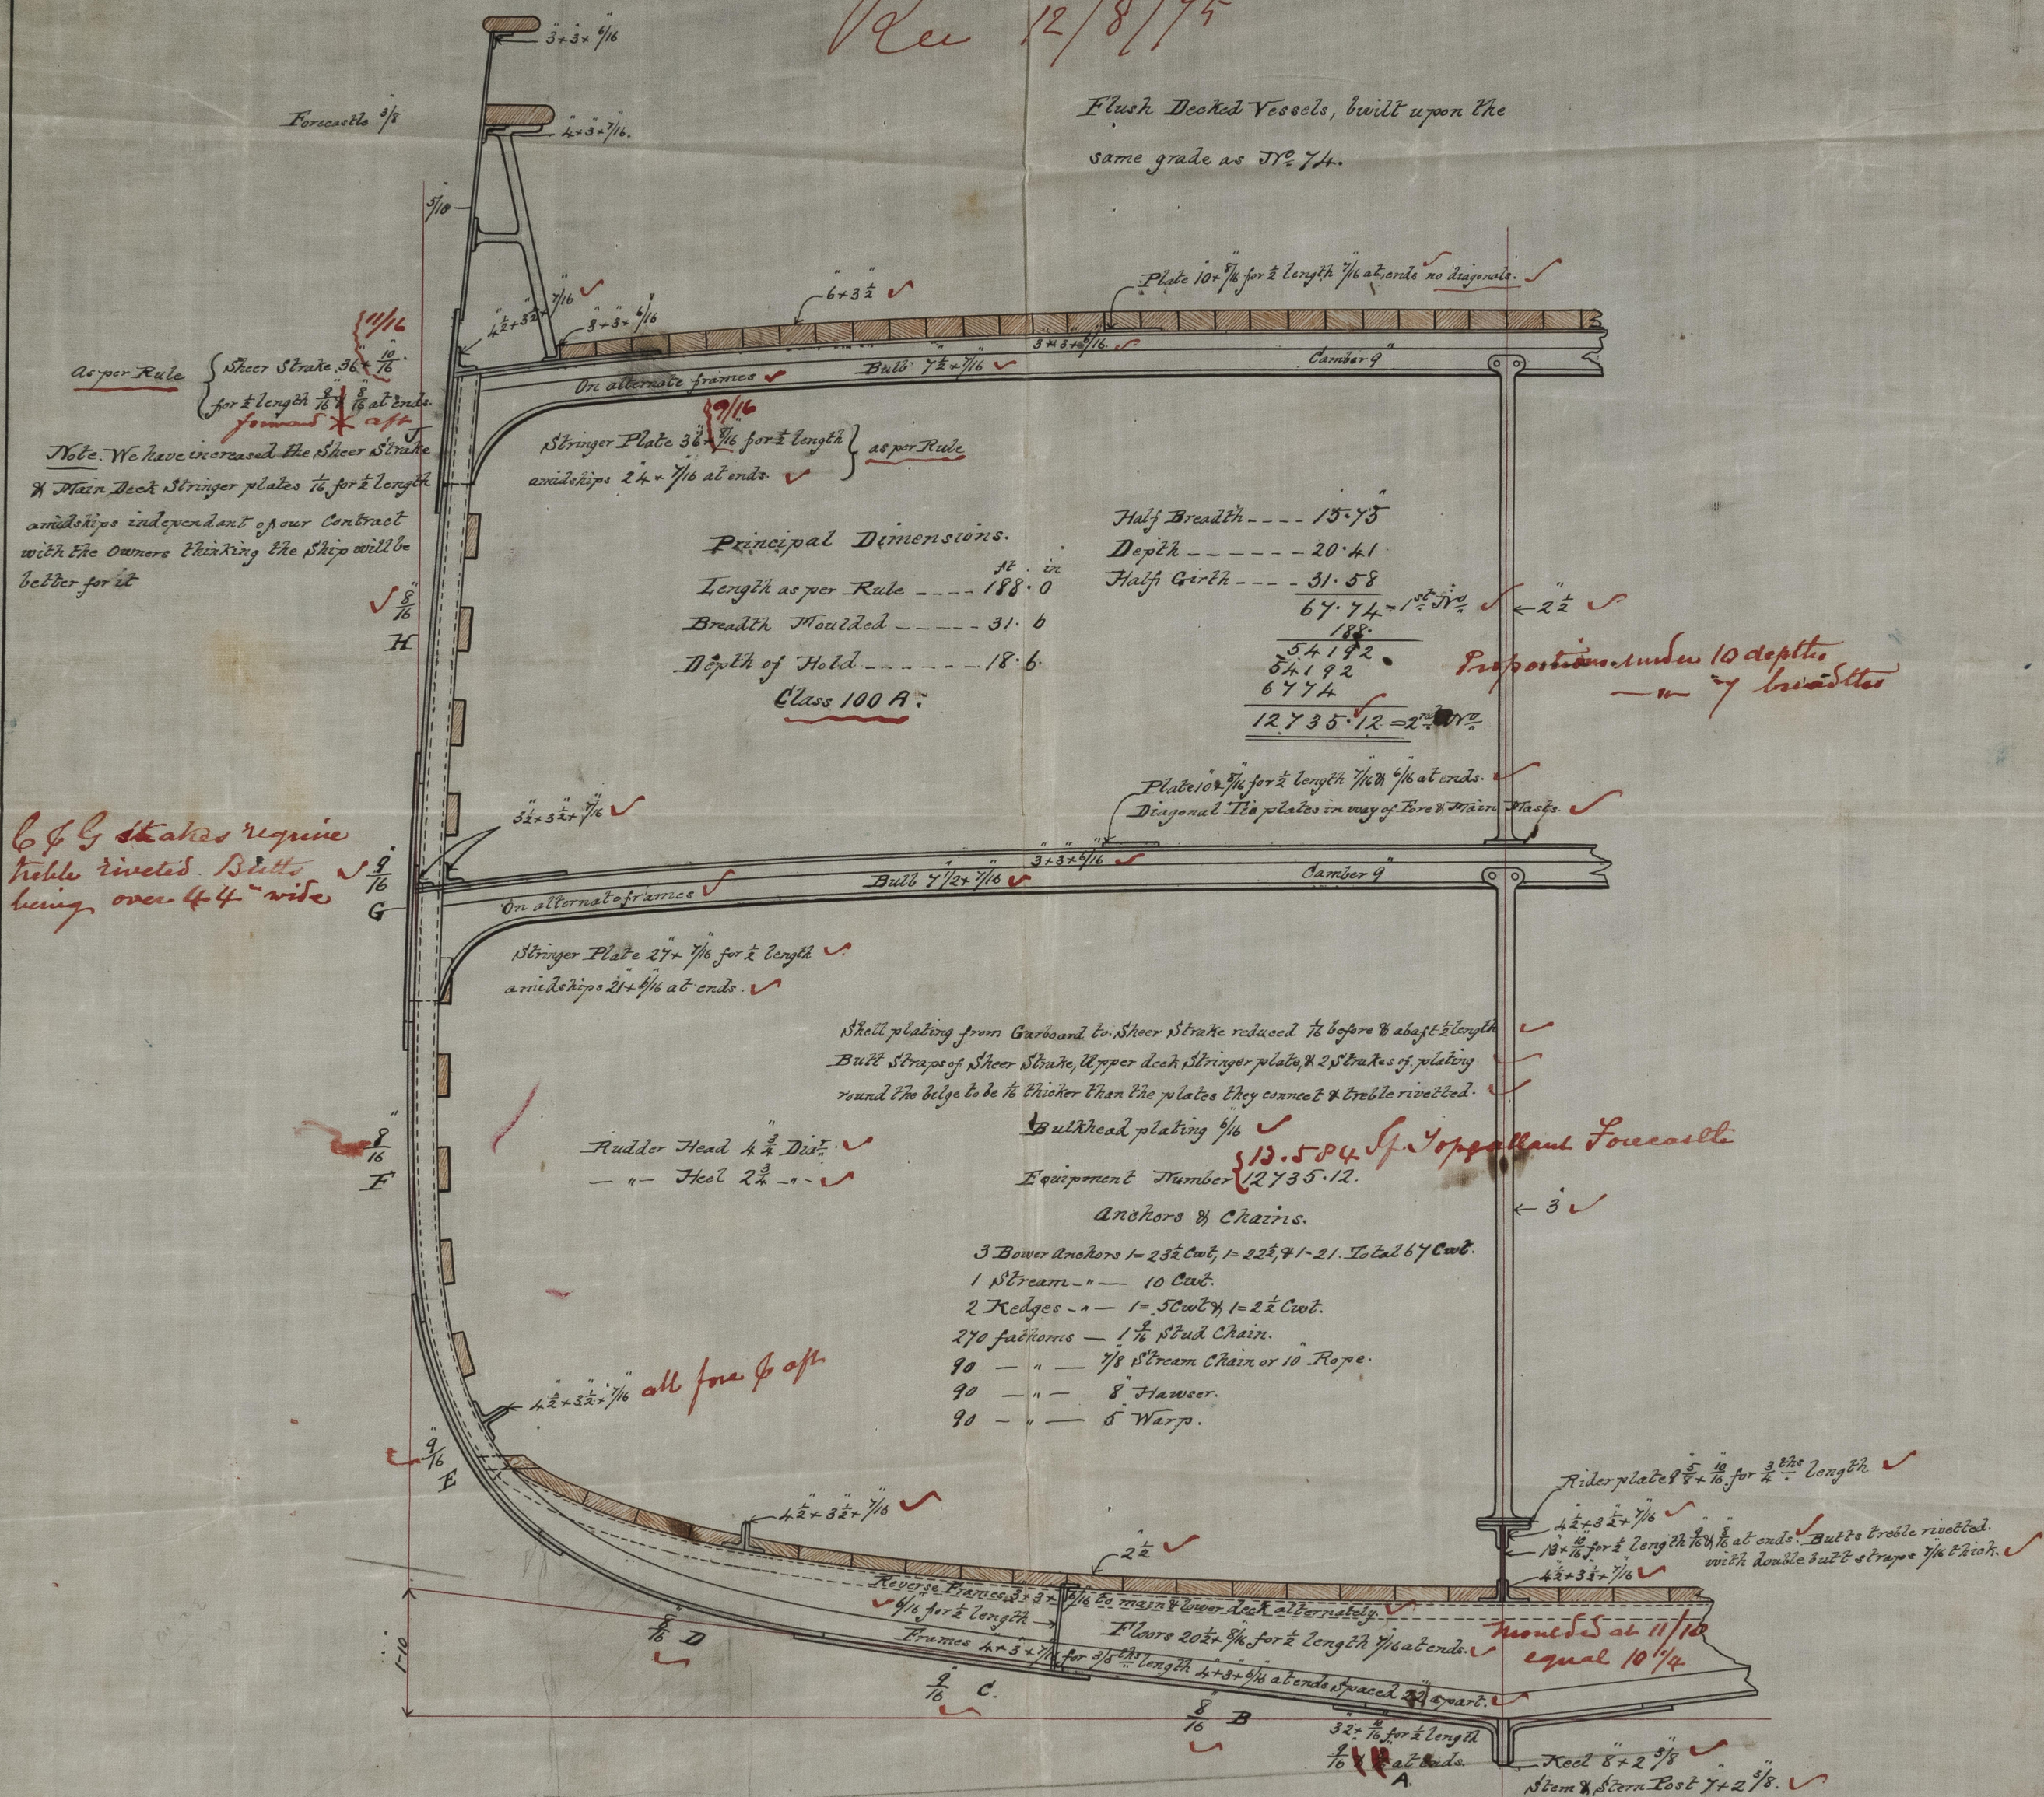

12/8/75

Recd 30 June 76.
J. W. W.

"ALASTOR"

