


T.S.S. "CONTE VERDE" No 612
 SIDE PLATING OF SUPERSTRUCTURE.
 SCALE 1/100.

WILLIAM BEARDMORE & CO., LTD.,
 DESIGNING DEPT.
 NUMBER 4940
 DATE 12-4-22
 EXAMINED BY
 NAVAL CONSTRUCTION WORKS,
 DALMUIR, N.B.

Approved
 Lloyd's Register of Shipping
 (sgd) J. Montgomery per S. Potts
 Date 10-4-22

28 MAR 1922
 (B.C. STAMP)
 (sgd) J. L. A.
 per letter 31-3-22.

 

Messrs. W^m Beardmore & Co. Ltd.

No. 612.

Side plating of Superstructures


GLASGOW REPORT No.

42623

612 Conte Verde

13.

X

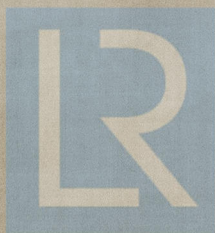

© 2020

Lloyd's Register
Foundation

007817-007824-0024