


T.S.S^s N^{os} 611 & 612
PROFILE & STEEL DECKS
DIMENSIONS :- 570"0" x 74"0" x 40"0" MLD. TO SHELTER DK
SCALE 1/8" = 1 FOOT.

Modified in Blue in Accordance with G.C. Requirements 29-7-19.
 " " Red " " " " " " " " 20-8-19.

WILLIAM BEARDMORE & CO., LTD.
DESIGNING DEPT.
NUMBER 3563.
DATE 29-8-19.
EXAMINED BY
NAVAL CONSTRUCTION WORKS,
DALMEIR, N.B.

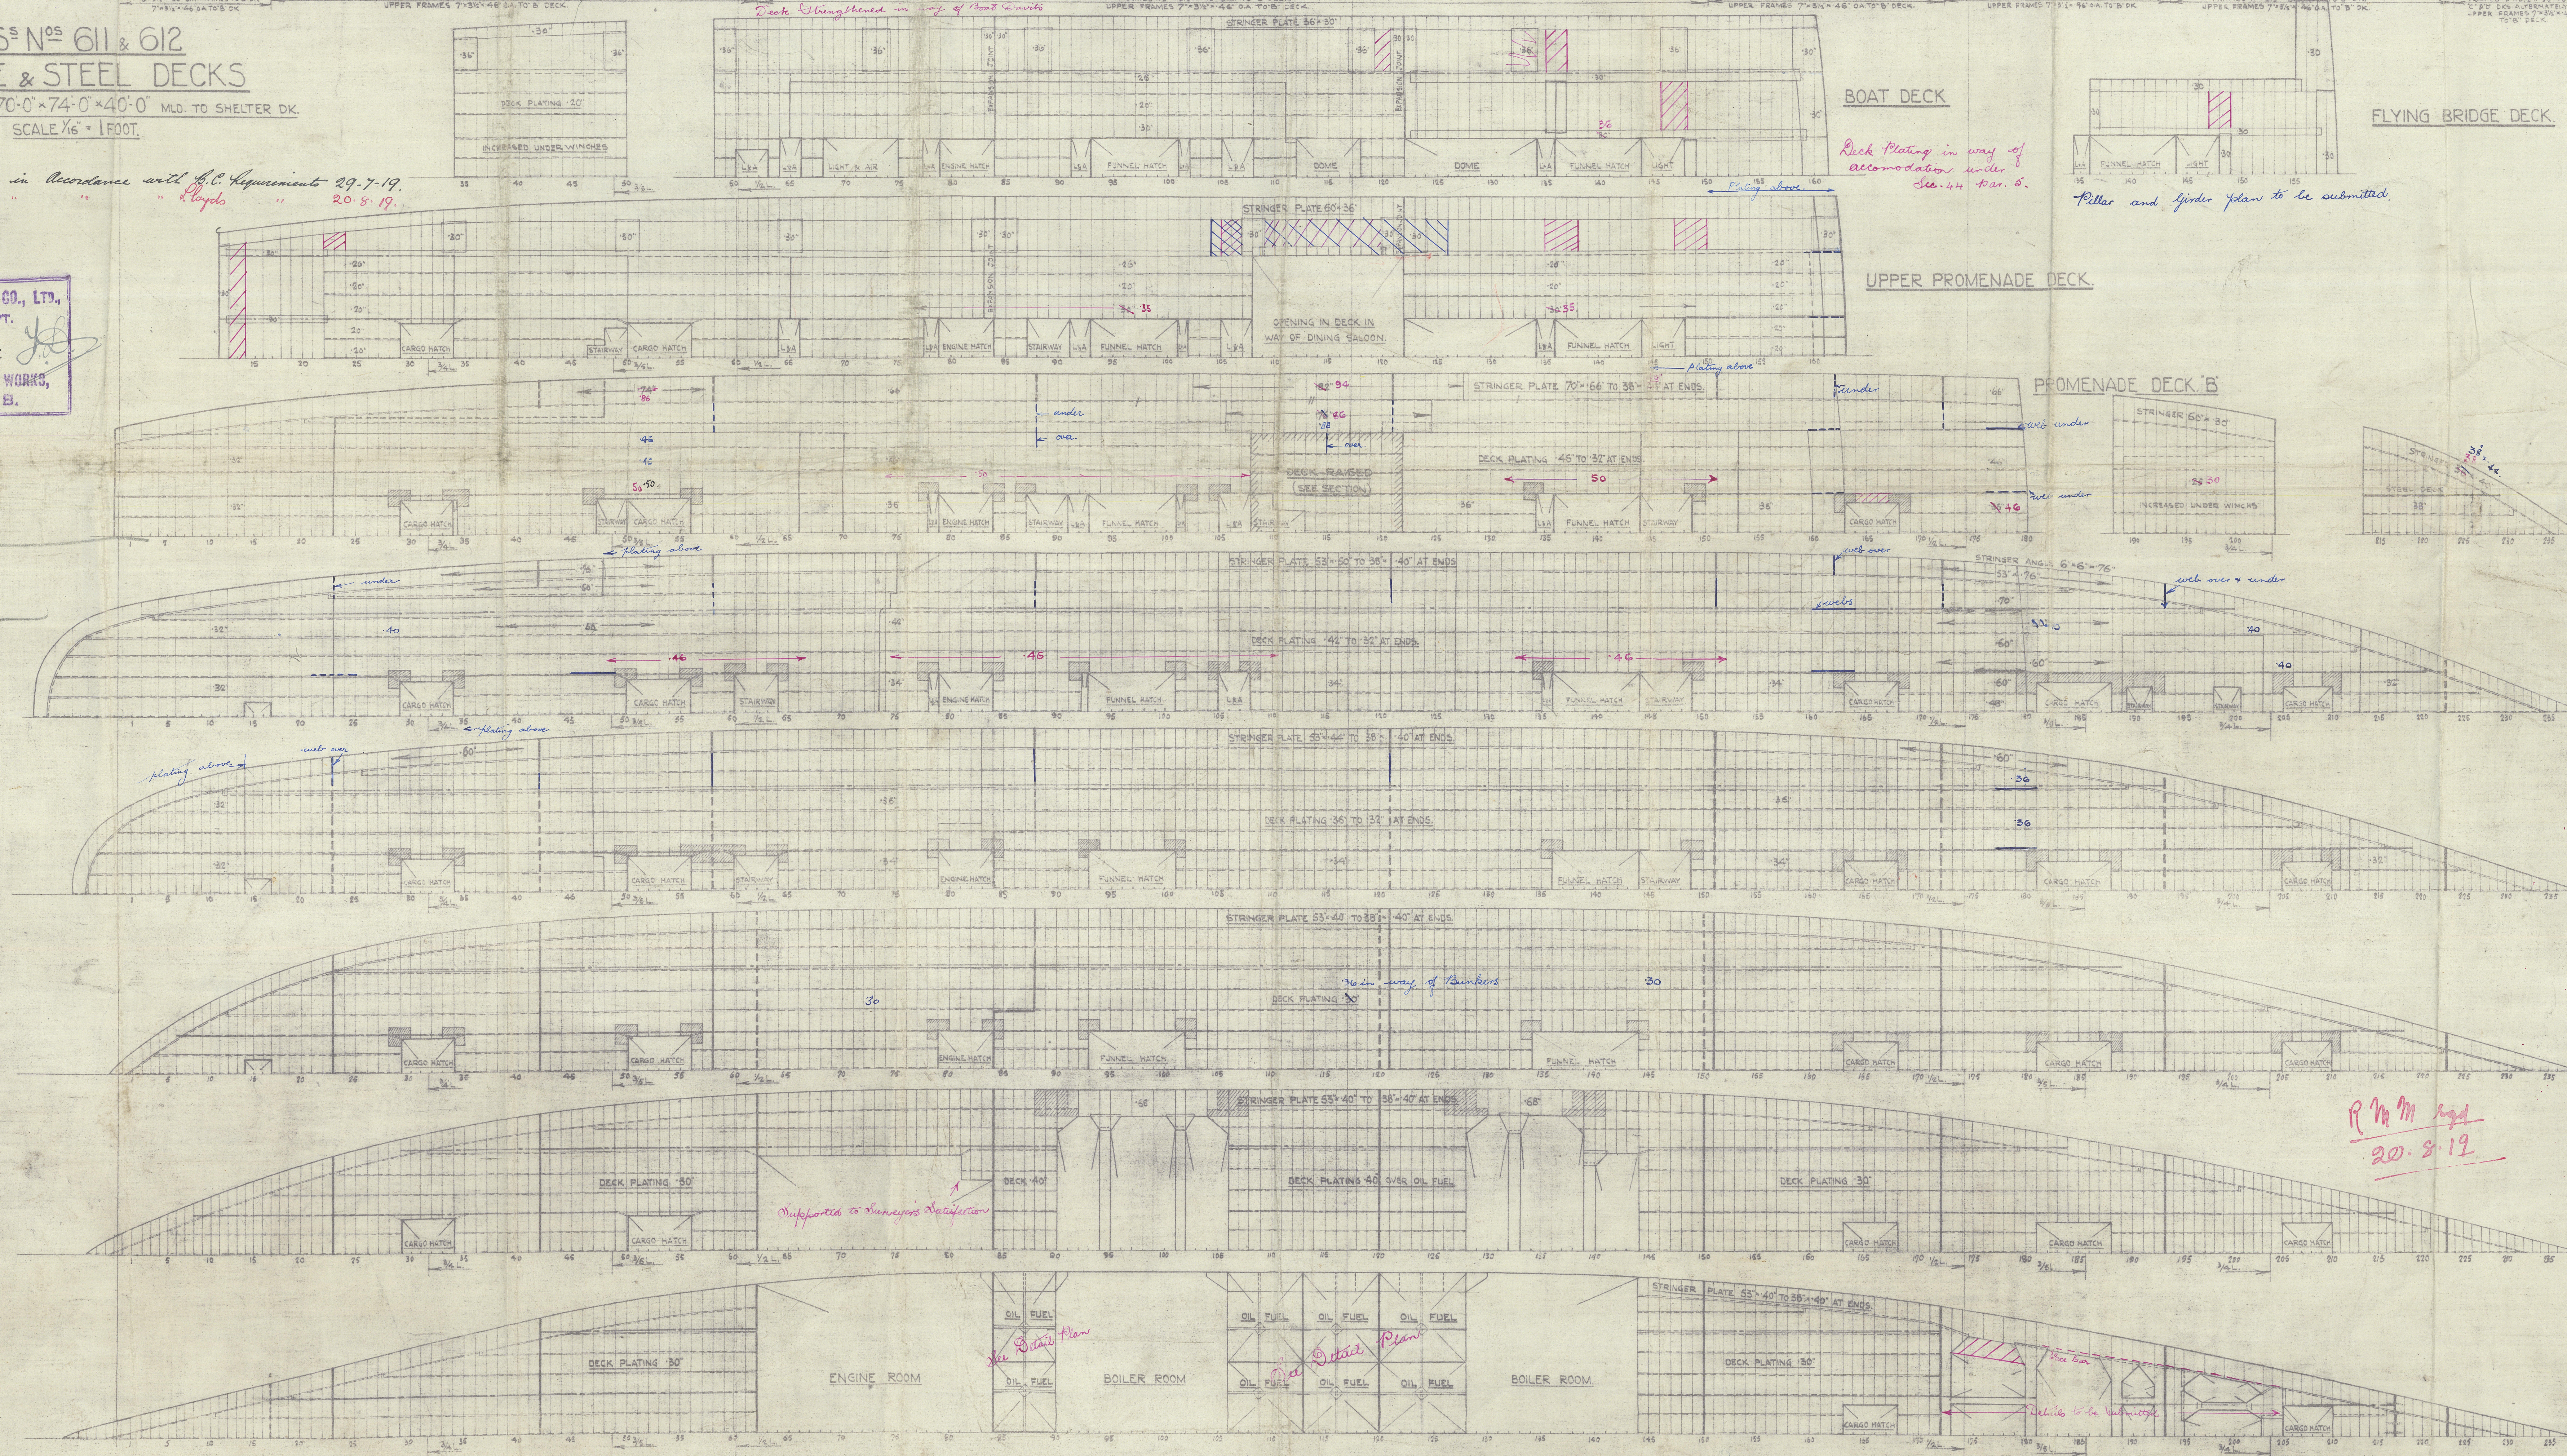

NOTE:- DETAIL SKETCH OF
PANTING ARRANGEMENT
TO BE SUBMITTED

FCLE DECK

BRIDGE DECK "C"

SHELTER DECK "D"

UPPER DECK "E"

MAIN DECK "F"

LOWER DECK "G"

© 2020
Lloyd's Register
Foundation

Pyrite & Duck plans

as. Approved by

R & B.C.

No 611-12

W. Rindman 88-75

611. Conte Ross
Gls 417 30.

612 Conte Verde * D.S. 505

LASCOW REPORT No

42623



© 2020

Lloyd's Register
Foundation

007819-007824-0026

Lloyds



© 2020

Lloyd's Register
Foundation