

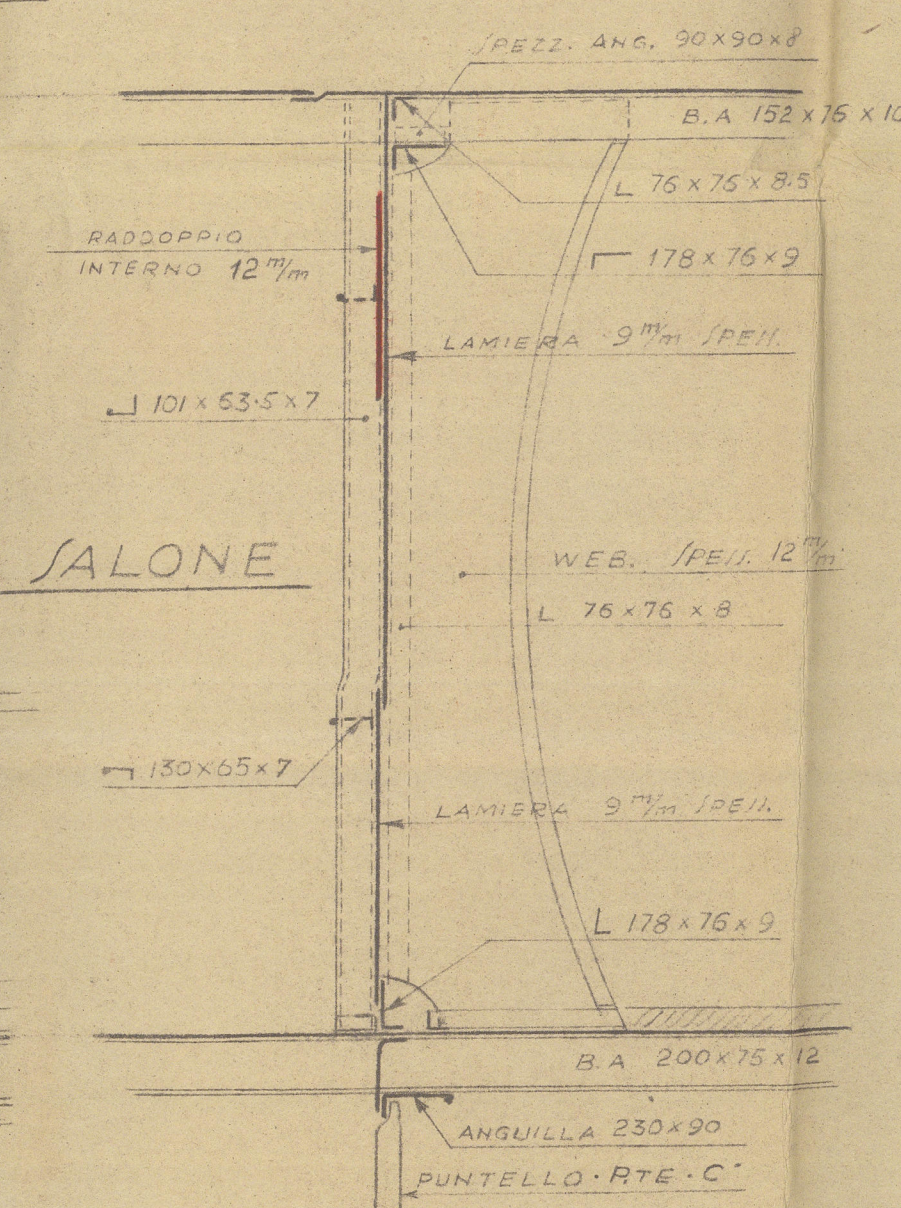


PARATIA LONGITUDINALE - DESTRA - TRA LE ORD. 108-130
SUL PONTE - A - B - SCALA 1:25

ALL'ORD. No 118

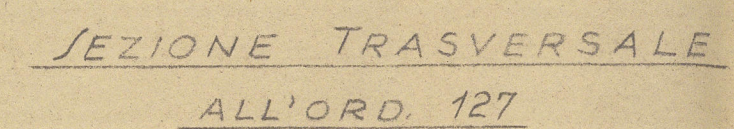

APPROVATO
12-7-1939
LLOYD'S REGISTER OF SHIPS

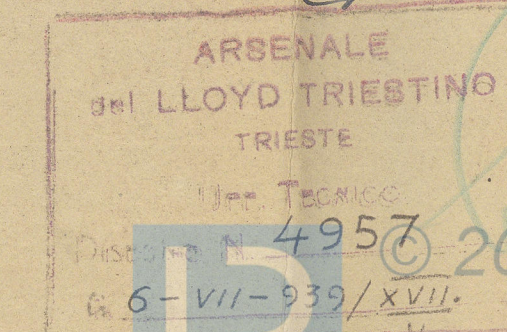

"Bonte Verde"

Tri. 12668.



© 2020

Lloyd's Register
Foundation

007817-007824-0029

SS Conte Verde

TRIESTE Rpt 12668



© 2020

Lloyd's Register
Foundation