

NUMERALS

L = 112'-0"

B+D = 35.83 TRANSVERSE NO

L x (B+D) = 4013.4 LONG. NO

d = 12

D = 8.4

- Nos 168-9-70 -

MIDSHIP SECTION

SCALE 1/2" = 1 FOOT

DIMENSIONS 112'-0" BP x 22'-6" MLD x 13'-4" MLD


CLASS 100 A1

FOR FISHING PURPOSES

EQUIPMENT

ANCHOR	5	CWT.	EX. STOCK
1	"	4 1/2	"
1	"	2 1/2	"
90	FATHOMS	1	CHAIN
60	"	5 1/2	HAWSER
60	"	4	WARP

ENGINE & BOILER CASING 8'-3" WIDE x 4'-0" HIGH.
COAMING PLATES 5/16" PLATING .26"
STIFFENERS 3 x 2 1/2 x .26"
FOUNDATION ANGLES 5 x 4 x 7/16" IN WAY OF
BOILER SPACE 3 1/2 x 3 x 5/16" ELSEWHERE
3 1/2" VERTICAL

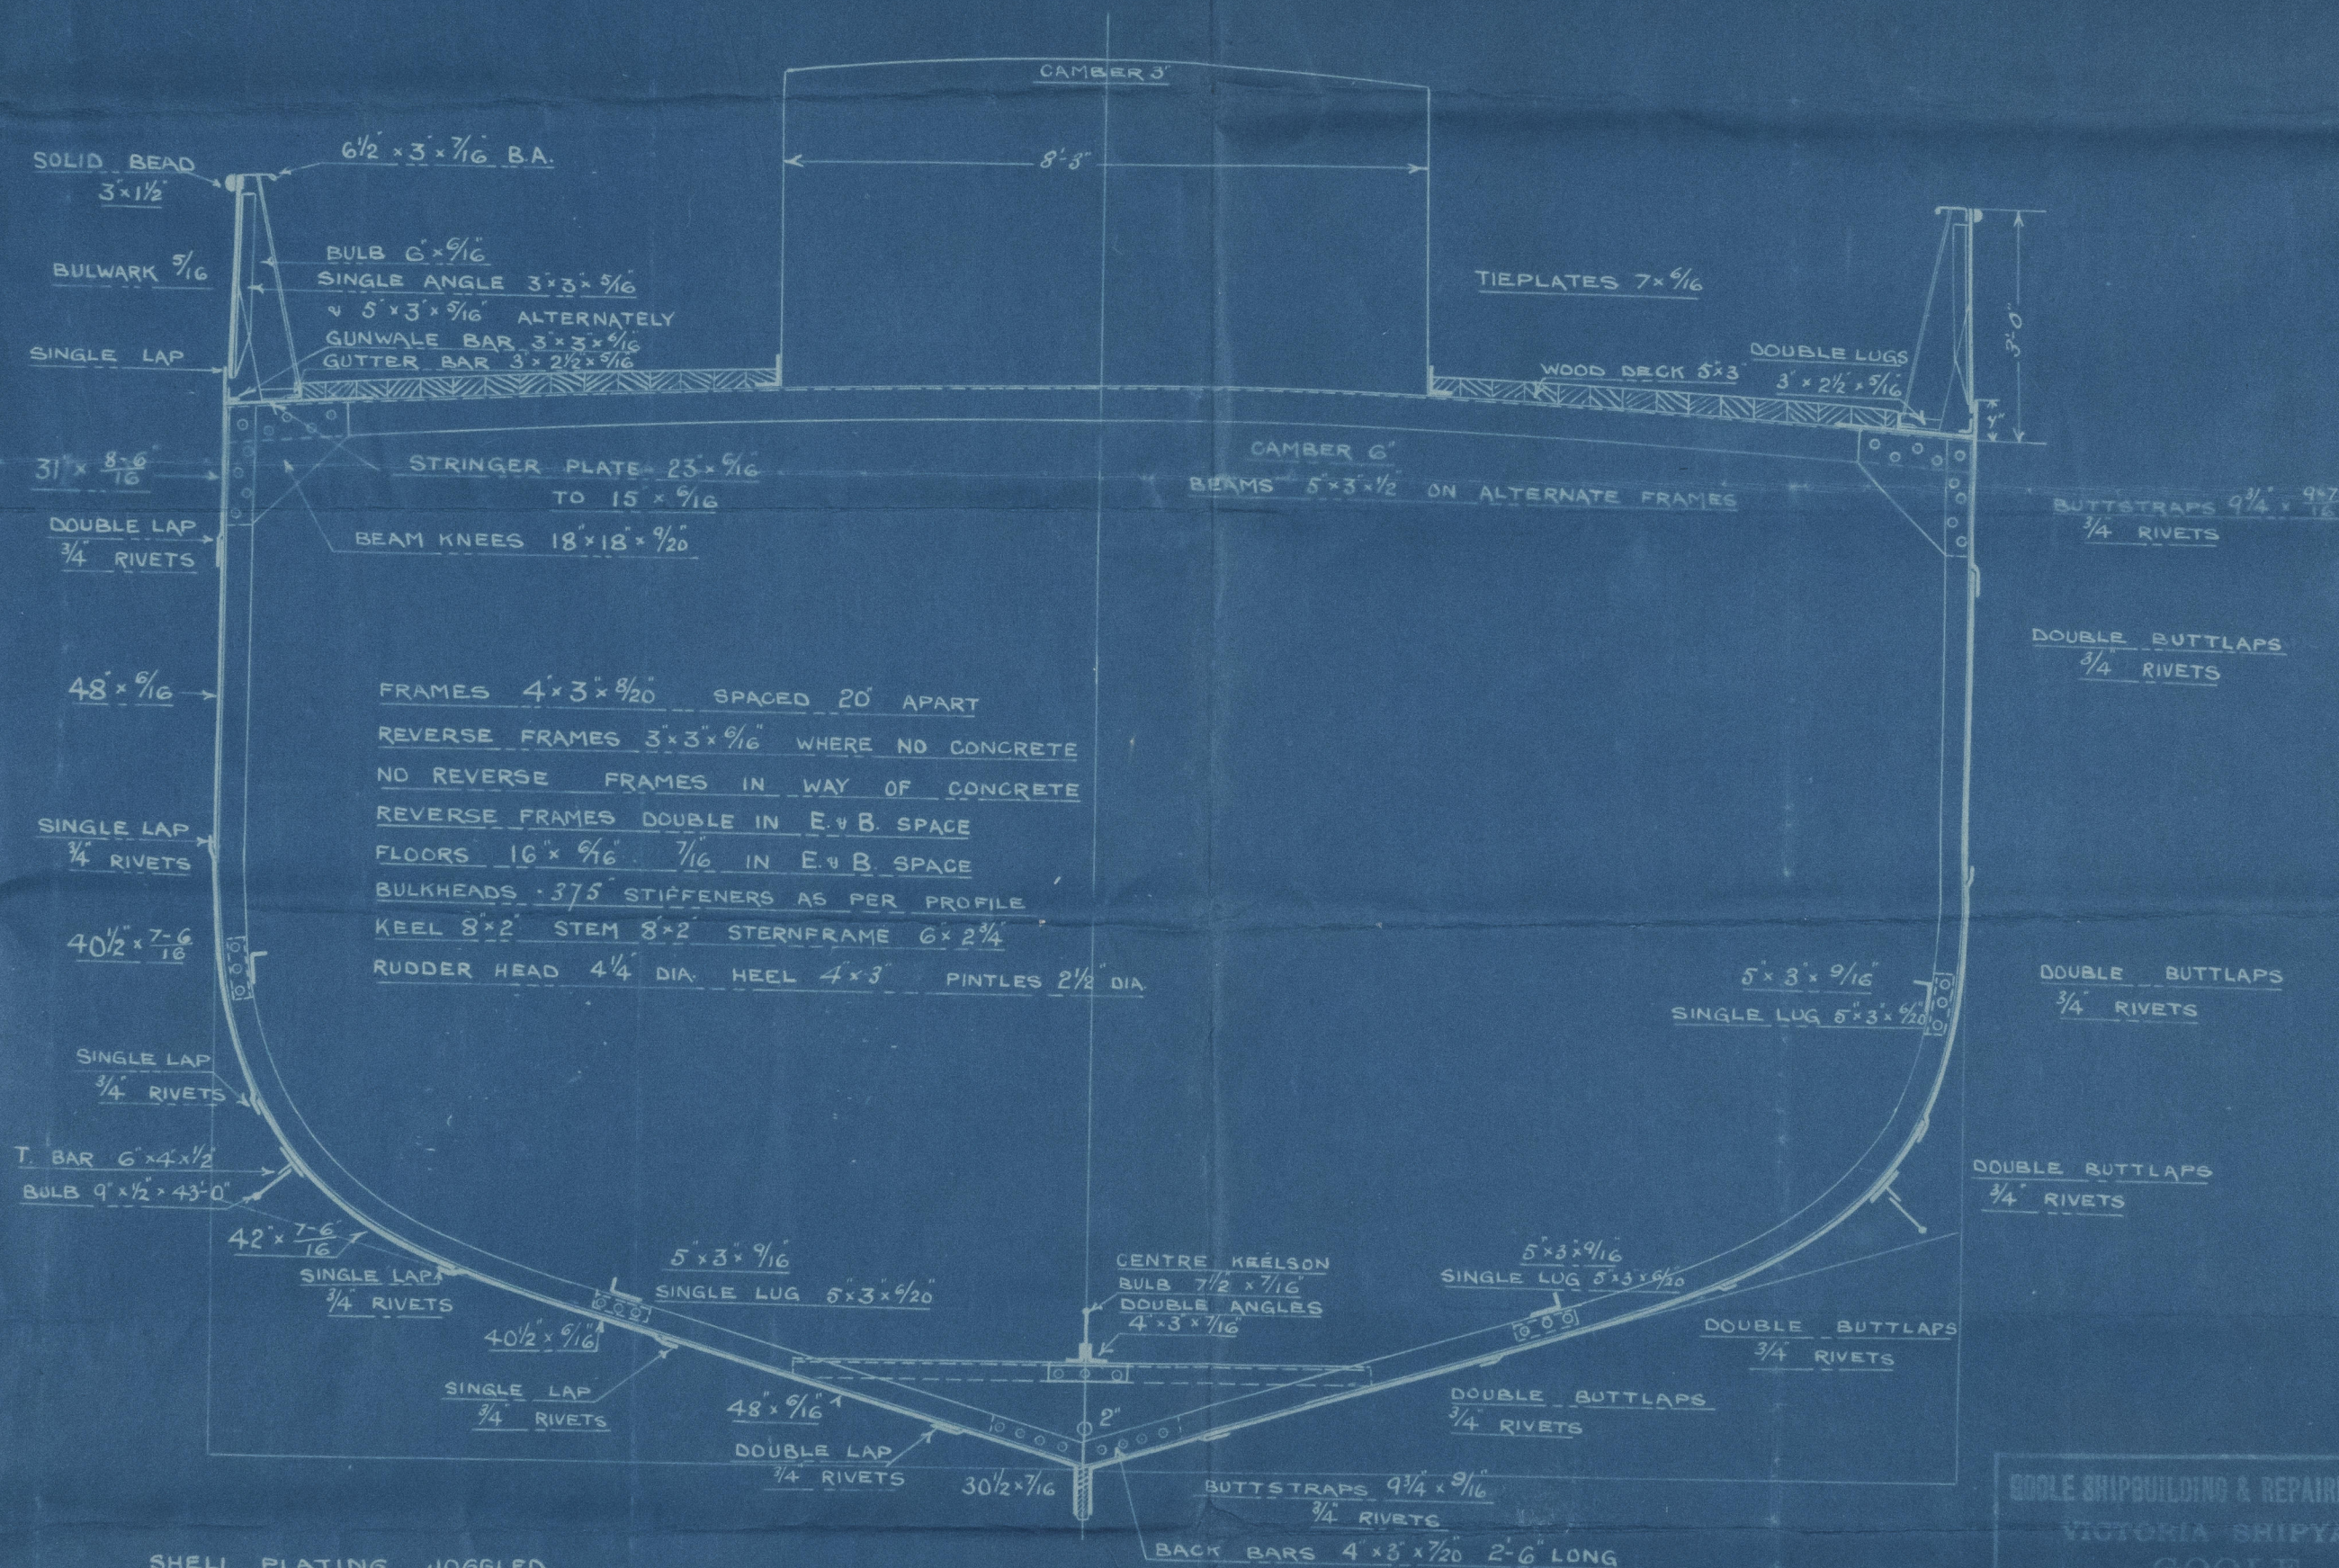

GOOLE SHIPBUILDING & REPAIRING Co. Ltd.
VICTORIA SHIPYARD,
GOOLE.

Drawing No. 142

Made by T.M. Checked by *Atkins*


Date APR. 29TH 15



Lloyd's Register
Foundation

Coast S. S. & Ry Co's Nos 168-169-170.


Midship Seelin
Ephraiah

S. S. Commander Holbrook. 
Hull Report No 28310.

S. S. Command Horton.
Hull Report No 28358.

S. S. Commander Fullerton.
Hull Report No. 28433.

of Vessels as Dull:

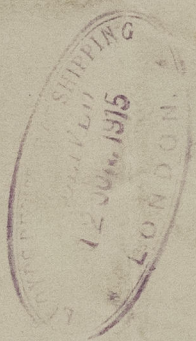

© 2020

Lloyd's Register
Foundation

007825-007833-0130