


Date 8-10-14.

-NEW ELEVATION-

- DIMENSIONS. 112'-0" B.P. x 22'-6" M.L.D. x 13'-4" M.L.D. -

- SCALE $\frac{1}{4}$ " = 1 FOOT. -

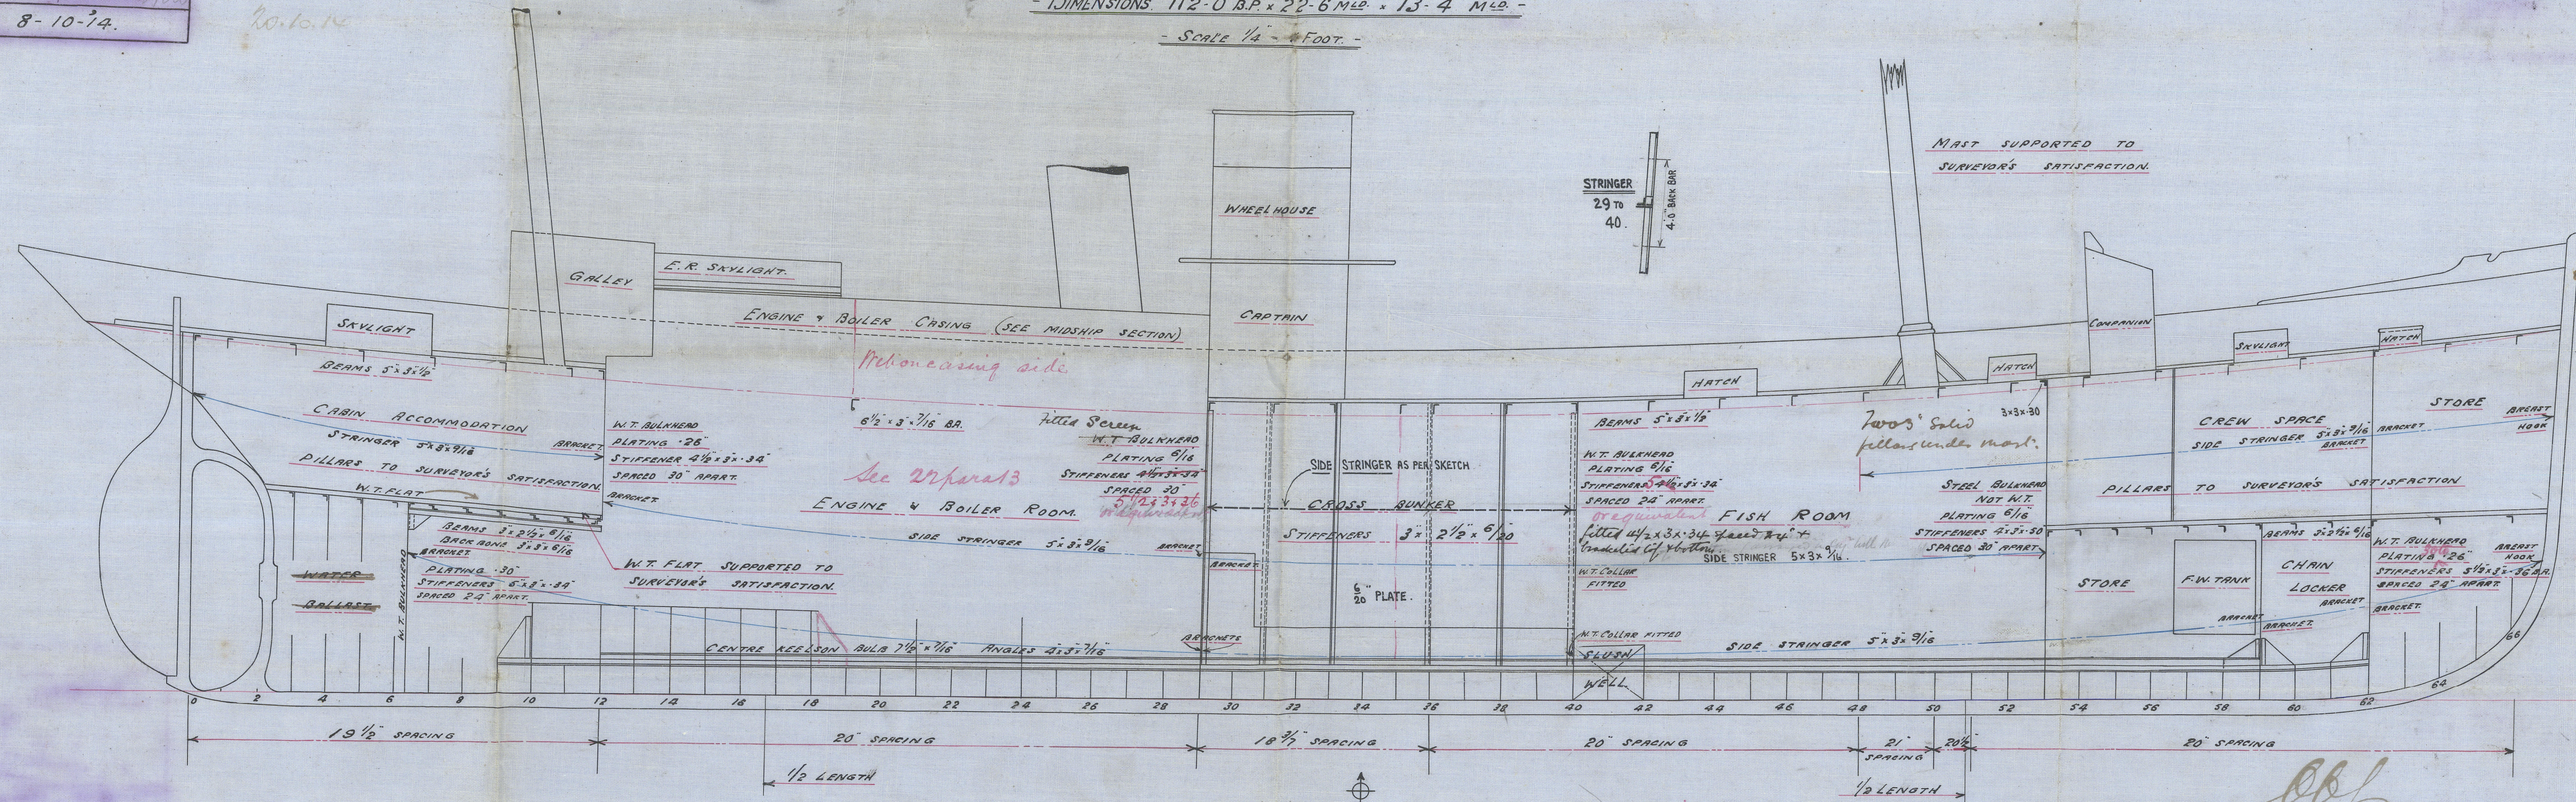

Abasto supported to surveyors satisfaction
Pillaring arrangements throughout to surveyors satisfaction

20. 10. 14

No 168-169 & 170

Amended Profile

Apratah
ex

s/s "Commander.
Hulbrook"

Hull Rpt. no. 28310

S.S. "Commander Horton"

Hull Rpt. no. 28358.

S.S. "Commander Fullerton"

Hull Rpt. No. 28433



© 2020

Lloyd's Register
Foundation

007825-007833-0131