


Will Report to Lull
1912

PLA No. 2354
FOR ENCLOSURE TO
Messrs Lloyd's Surveyors
Hull FROM
COCHRANE & SONS, LTD.
SHIPBUILDERS, SELBY
DATE Dec 17th 1912. RK

STEEL SCREW TUG

DIM = 85'-0" BP x 21'-0" MLD x 10'-0" MLD
SCALE 1/4" INCH

SCALE $\frac{1}{4}$ INCH

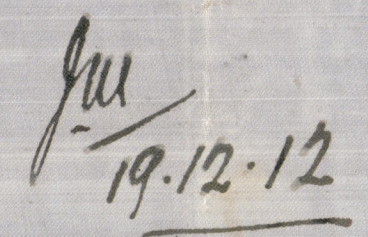

Cochrane & Sons. Ltd.

No 571.

Profile & Deck Plan.

Dimensions 85'-0" x 21'-0" x 10'-0".

S.S. Lug.



s/s Yungarth

Hull Report No 26817

19-15-12

21-1-13

21-1-13

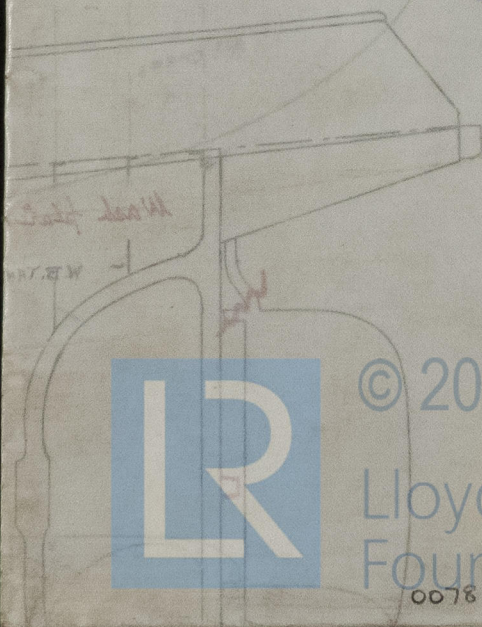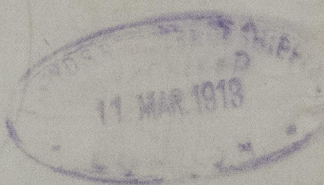

© 2021

Lloyd's Register
Foundation

007834-007845-0273