


172 N  
 19.12.12  
 2.1.13  
 11.1.13

19.12.12  
 2.1.13  
 11.1.13

# MIDSHIP SECTION STEEL SCREW TUG No 571

DIMENSIONS: 85'-0" B.P. x 21'-0" MLD x 10'-0" MLD  
 TO CLASS 100.A. LLOYDS FOR TOWING PURPOSES.  
 SCALE 1/2 INCH.

PLAN No. 2353  
 FOR ENCLOSURE TO  
 Messrs Lloyd's Surveyors  
 Hull FROM  
 COCHRANE & SONS LTD  
 SHIPBUILDERS, SELBY  
 DATE Dec 17<sup>th</sup> 1912. RK

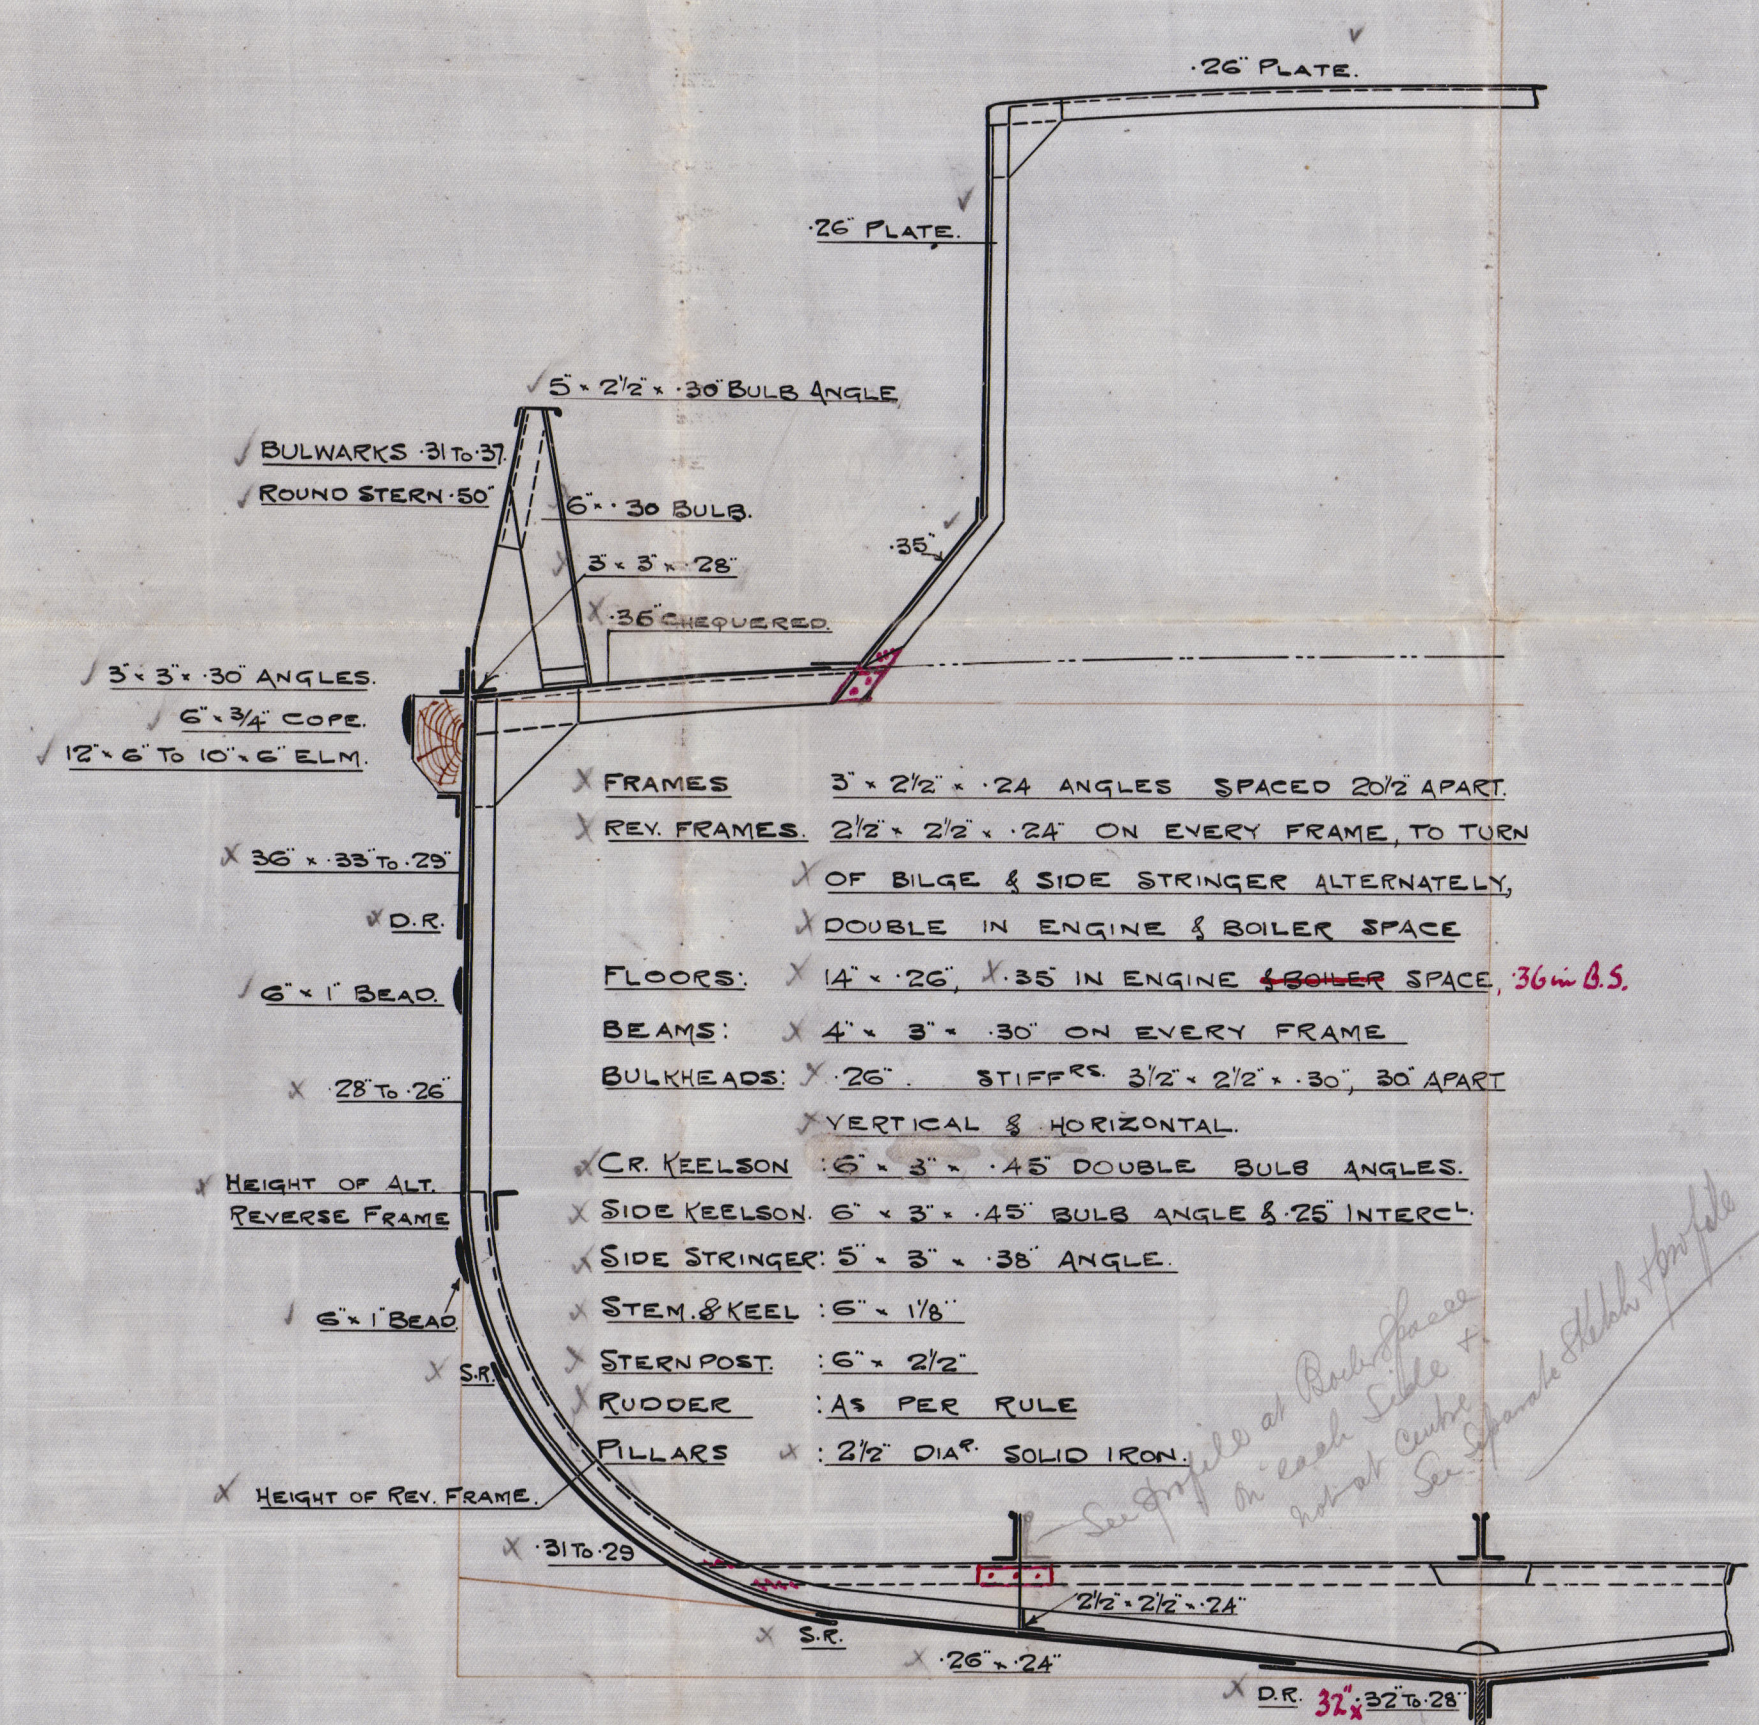

NUMERALS.  
 B + D ----- 31. x  
 L x (B + D) ----- 2655 x

PROPORTIONS.  
 L ----- 4.04 x  
 B ----- 8.5 x  
 D ----- 8.93

EQUIPMENT.  
 2 ANCHORS ----- 5 CWTs STOCKLESS.  
 1 " ----- 2 1/4 " EX STOCK.  
 60 FATHOMS ----- 1 1/8" STUD LINK CABLE  
 " ----- 5 1/2" HAWSER.  
 " ----- 3" WARP.

RIVETING.  
 BUTTS OF SHELL PLATING LAPPED & DOUBLE  
 RIVETED, EXCEPT GARBOARD & SHEER STRAKE  
 WHICH ARE TO BE STRAPPED & DOUBLE RIVETED.

19.12.12



Cochrane & Sons. Ltd.

No 571.


Midships Section.

Dimensions 85'-0" x 21'-0" x 10'-0"

S.S. Ing.

s/s 'Yewgarth'  
Hull Report No. 26317

10.51.15  
81.1.2  
81.1.11

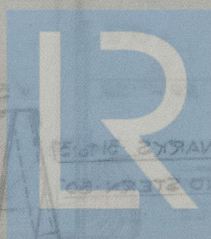

© 2021

Lloyd's Register  
Foundation

007834-007845-0274