

N^os 244 & 5 & 8

MIDSHIP SECTION

SCALE 1/2" = 1 FOOT

DIMENSIONS 140'-0" BP x 24'-0" MOULDED x 13'-10" MLD

CLASS 100 A.1
STEAM TRAWLER
STEEL

LOYDS NUMBERS

L = 140'-0"

B + D 24 + 13.83 = 37.83

d = 12.41

L x (B + D) = 5296.20

L/D = 10.12

NUMERAL FOR RUDDER 68.53 SPEED 10 1/2 KNOTS

- EQUIPMENT
- ✓ 4.1.12 ANCHOR 8 1/2 TON STOCKLESS
 - ✓ 6.1.12 ROOGER ANCHOR 3 1/2 TON EX STOCK
 - ✓ 10.1.12 120 FATHOMS 1 1/8" CHAIN CABLE SHORT LINK
 - ✓ 60 " 6" HAWSER
 - ✓ 60 " 5" WARP

SOLID BEAD
3 x 1 1/2

BULWARK 5/16
9/16 IN WAY OF R.O.D.

4 x 3 x 7/16
BULB ANGLE

BULB 7 x 3/8

3 x 3 x 3/8
2 1/2 x 2 1/2 x 3/8
DOUBLE LUG

✓ QUARTER DECK 81'-0" x 6" HIGH
✓ SCANTLINGS SAME AS MAIN DECK

ROUND OF
BEAM 7"

✓ BEAMS 6 x 3 x 9/20 SPACED
✓ 40" APART

✓ KNEES 18 x 18 x 9/20

✓ STRINGER PLATE 28 x 7/8
TO 19 5/16

5 x 4 x 5/20
IN WAY OF R.O.D.
SINGLE LUG 5 x 3 x 3/8

✓ FRAMES 4 1/2 x 3 x 9/20 SPACED 20" APART

✓ REV " 3 x 3 x 3/8 ACROSS TOP OF FLOORS

✓ WHERE NO CONCRETE

✓ REV " DOUBLE IN E & B SPACE

✓ FLOORS 17 x 5/16 7/16 IN E & B SPACE

✓ BULKHEADS 1/4 HORZ. & VERT. STIFFENERS 3 x 2 1/2 x 5/16

✓ KEEL & STEM 7 1/2 x 1 1/2 BULB

✓ STERN FRAME 6 1/2 x 8

✓ RUDDER HEAD 4 1/4 DIA. HEEL 3 x 2 3/4 } SEE PLAN

✓ PINTLES 2 3/4 (as per Rule)

✓ PILLARS AS PER RULE

5 x 4 x 9/20
SINGLE LUG 5 x 3 x 3/8

DOUBLE ANGLES 3 x 3 x 3/8
BULB 9 x 1/2

5 x 4 x 8/20
SINGLE LUG 5 x 3 x 3/8

BULB 8 1/2 x 1/2
ANGLES 5 x 3 x 1/2

BUTTSTRAPS OF
BULWARK SINGLE 5/8
RIVETS

DOUBLE BUTTSTRAPS

DOUBLE LAP

3/4 RIVETS

TREBLE BUTTSTRAPS

FOR 1/2 LENGTH

3/4 RIVETS

DOUBLE LAP

3/4 RIVETS

36 T-6

TREBLE BUTTSTRAPS

FOR 1/2 LENGTH

3/4 RIVETS

DOUBLE LAP

3/4 RIVETS

TREBLE BUTTSTRAPS

FOR 1/2 LENGTH

3/4 RIVETS

DOUBLE LAP
3/4 RIVETS

TREBLE BUTTSTRAPS
FOR 1/2 LENGTH

COOK WELTON & GEMMELL LTD

SHIPBUILDERS

BEVERLEY

DATE SUBMITTED DEC 29 - 1911

APPROVED JAN 5

C.B.



4.1.12

© 2020

Lloyd's Register
Foundation

Cook, Welton & Gemmell
No. 244-5-8 and 7.
Midship Section.
~~Deputy Master~~
"Pavlova"

Hull Rpt No. 25285

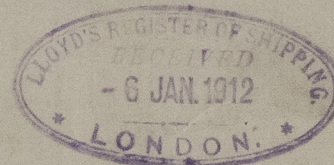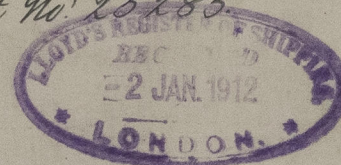

007865-007873-0213



© 2020

Lloyd's Register
Foundation