



SCALE :- $\frac{1}{4}$ " = ONE FOOT.

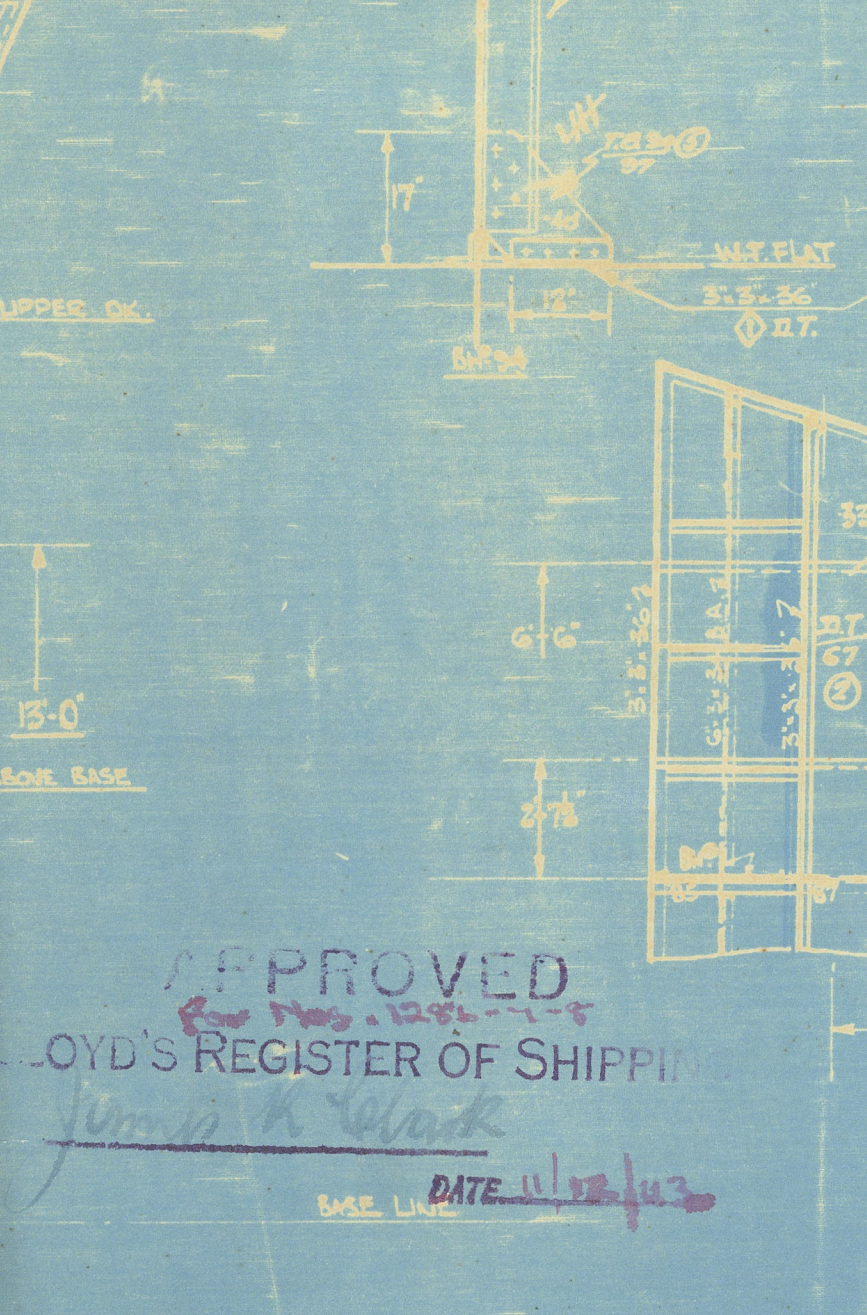

D. S. 427

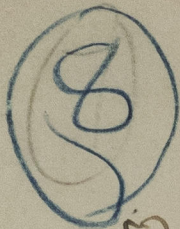

Messrs. A. & J. Inglis Ltd.

Yard No. 1151P.

1175P, 1184P, 1190P.
1225P, 1227, 1282P.
1286-7-8.

Fore End Framing.


1151P Empire Maiden
GLASGOW REPORT No. 65040

1175P Empire Gypsy
GLASGOW REPORT No. 66313

1225P Empire Harvest
GLASGOW REPORT No. 67910

1227 Empire Dombey
GLASGOW REPORT No. 68627

1286P Empire Rivoli
GLASGOW REPORT No. 69167 *

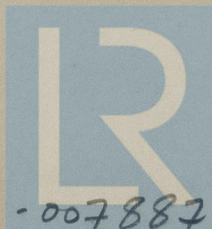

© 2021

Lloyd's Register
Foundation

007881-007882-0039