

For the information of Surveyors and the Committee only.

Received at

Office,

1890

Lloyd's Register of British and Foreign Shipping.

(Report on Vessel No. 207 Port Boston)

No. 96

SHIP FORGINGS OR CASTINGS.

I have to report that the undermentioned ~~Iron or~~ Steel Forgings or Castings,
manufactured by Jore River Shipbuilding Co.

of Quincy Mass. for the Vessel No. 207, being built
by Jore River Shipbuilding Co. of Quincy Mass.

have been inspected by me as set forth below, and found to be, so far as can be seen,

after having been subjected to Tests as set forth in the Rules to be sound and free from defects

on Forgings.

Lloyd's

No. 96

B.S.M.

8/1/12

Stewart Humphreys
July 8th 1912

STERN FRAME.

RUDDER FRAME.

STEM.

Material*

How made

Dimensions

Progress on Inspection

Date when Inspected

Open length. ^{stock and} open length.

Forged *Forged.*


To approved drawing *To approved drawing*

Forging, forged & finished *Forged and finished*

May 2nd 7 and 31st *May 2nd 31st*

June 6th *July 8th*

SKETCHES OF FRAMES SHOWING POSITION AND DESCRIPTION OF WELDS OF FORGINGS, OR PARTICULARS OF TESTS APPLIED TO CASTINGS.

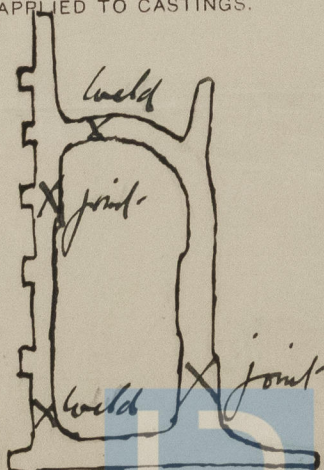

Fee (if any chargeable) £

To be paid at

* If of Iron, state whether scrap or puddled Iron.