
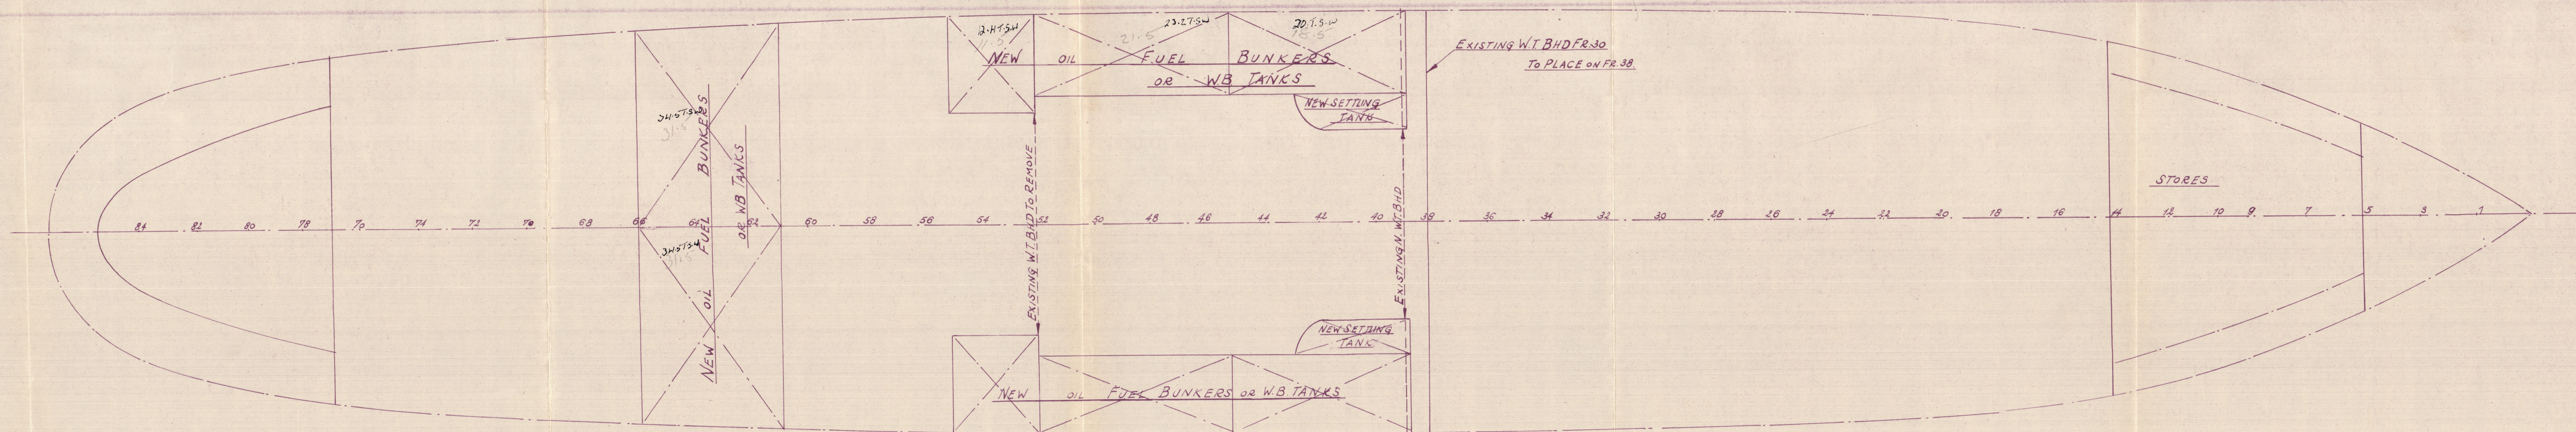


27 JUL 1946

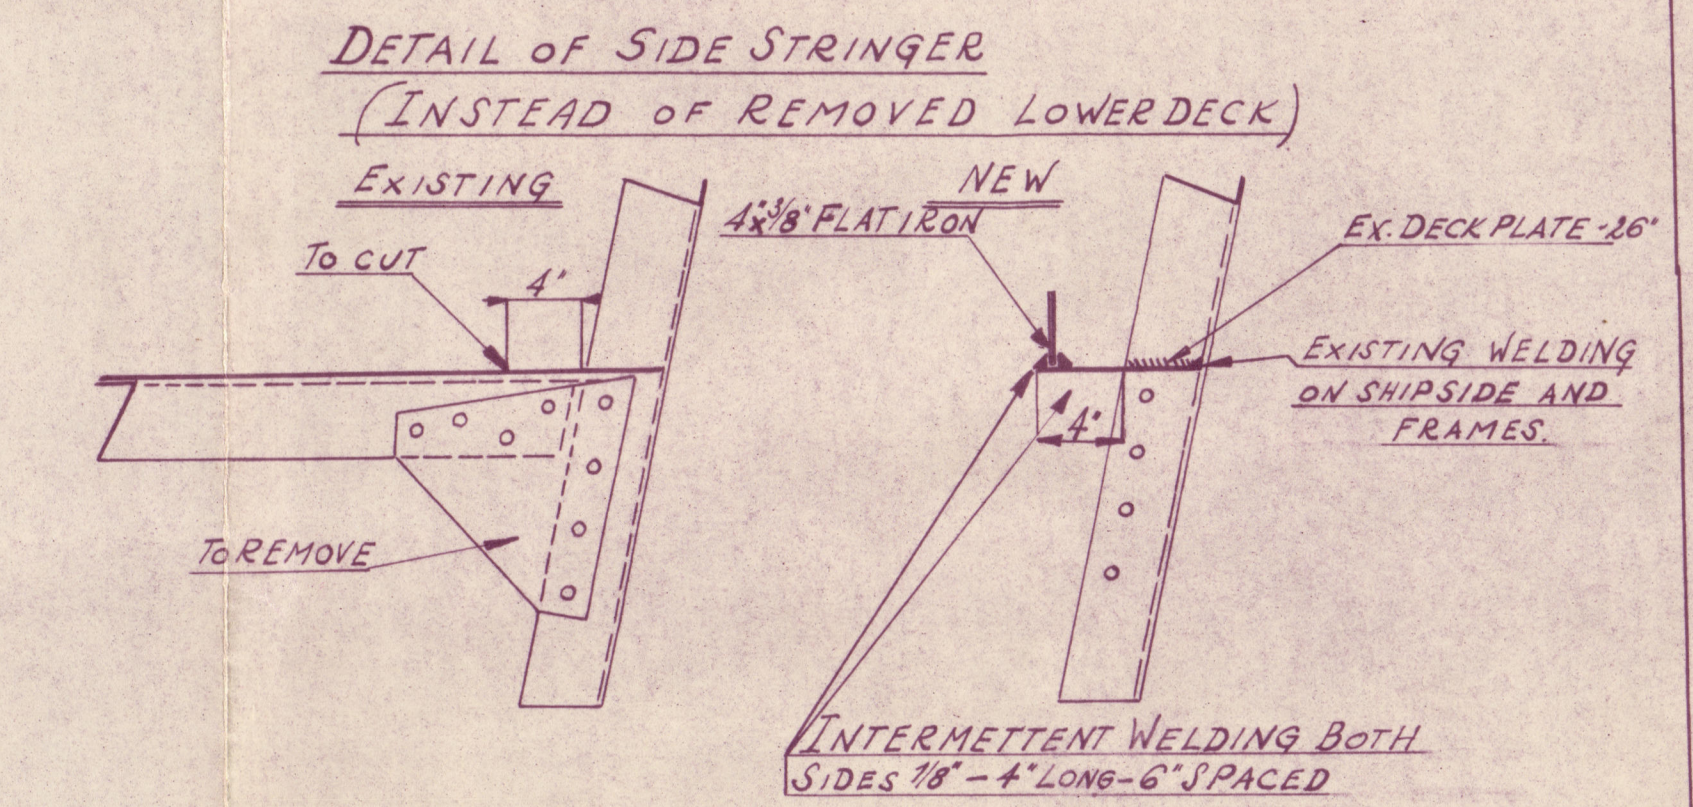

Ad
26.7.46

 © 2021

007888-007894-0027

Handwritten signature



© 2021

Lloyd's Register
Foundation