

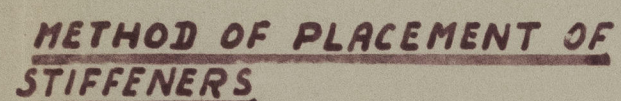
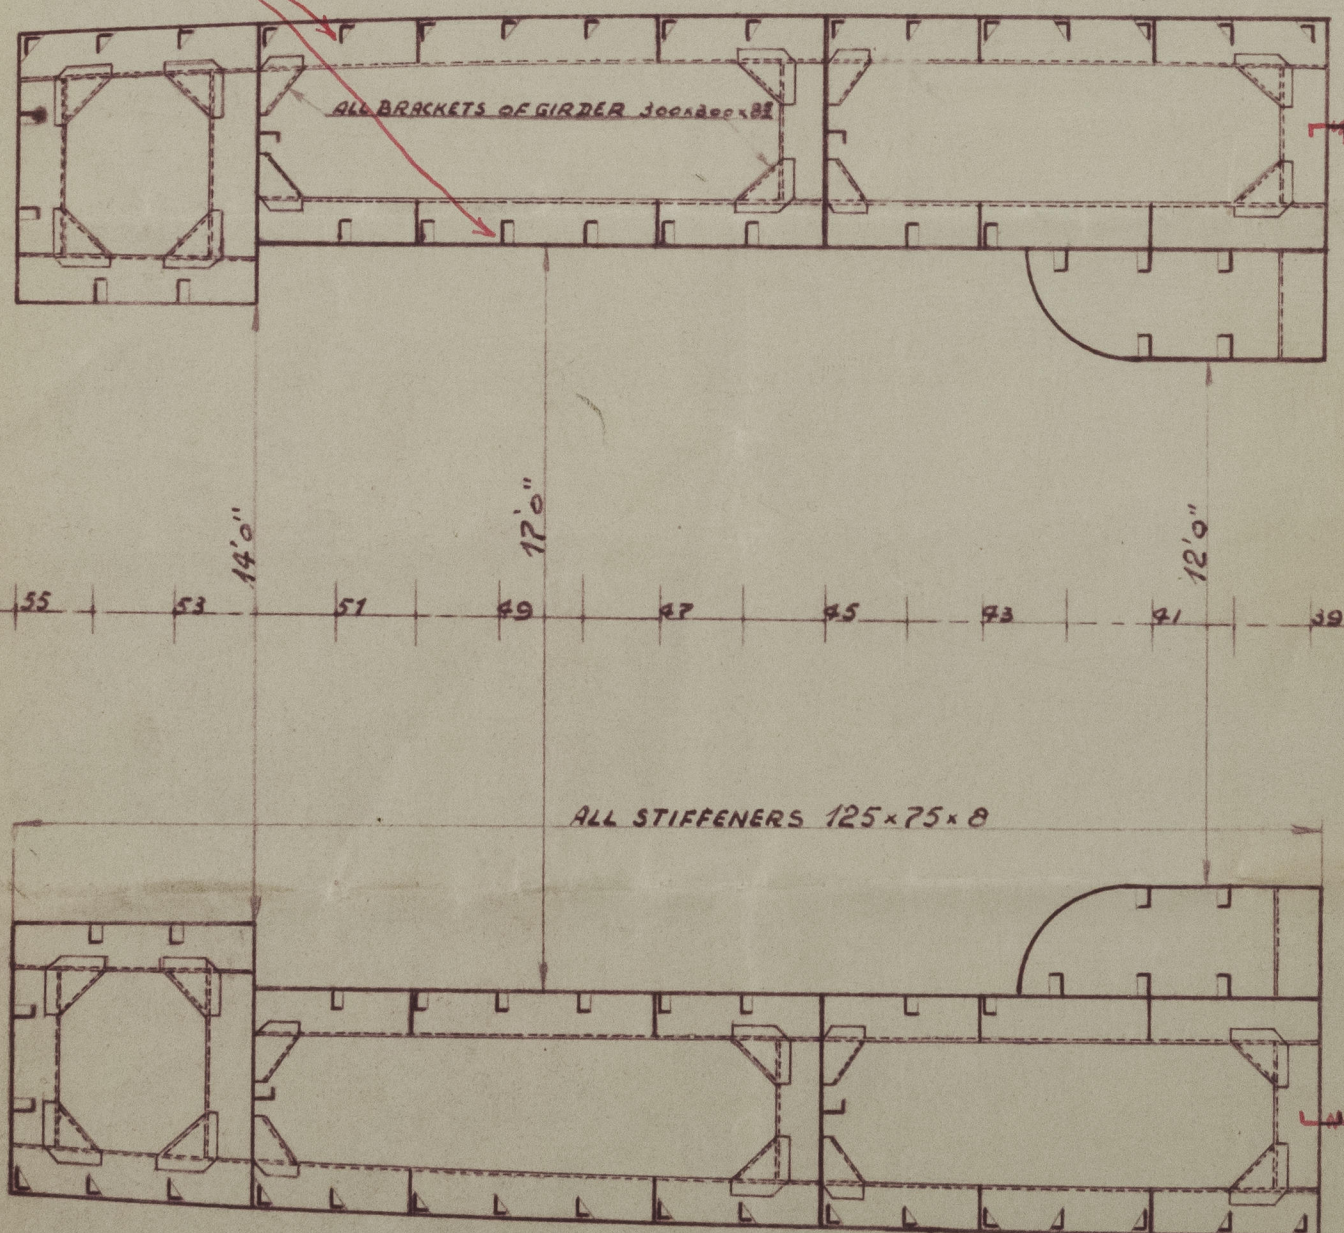
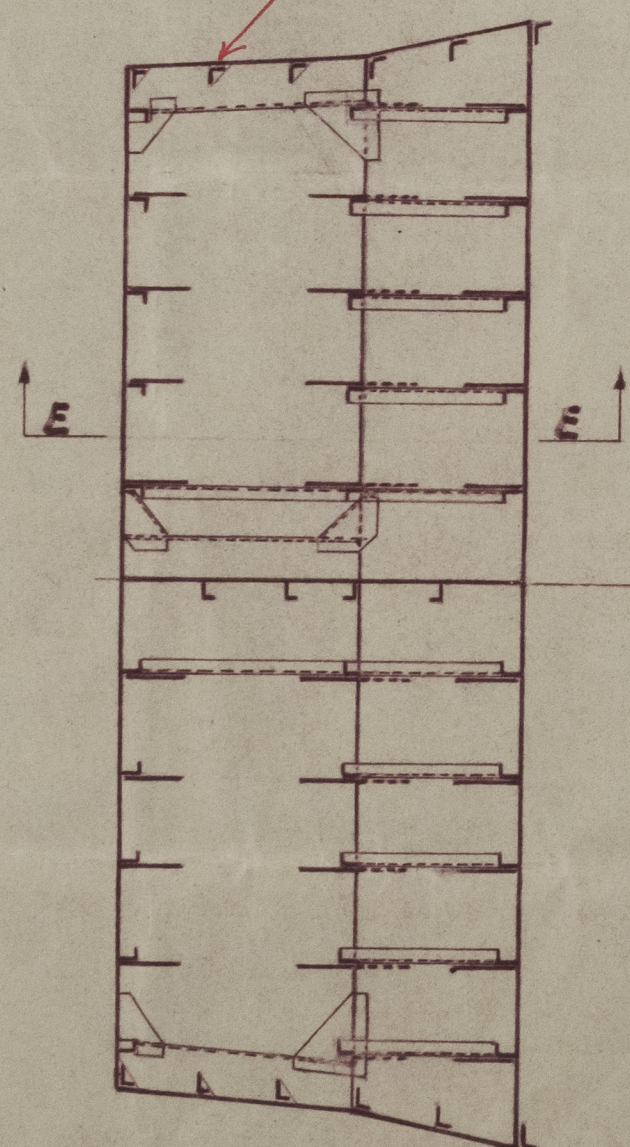


SECTION EE

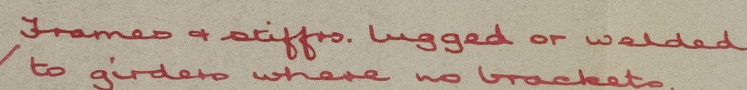

BRACKETS SPACED ABOUT 900<sup>m</sup>

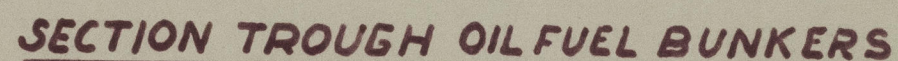

ANTWERP

Ad  
9.10.46