


Lloyd's Register of Shipping.
SURVEYS FOR FREEBOARD.
(CONDITIONS OF ASSIGNMENT.)

Index No. 37906.
(For London Office only).

Ship's Name "Vic 94"
Official Number 180431
Nationality and Port of Registry British, Hull
Port of Survey Hull
Surveyor's Signature J. I. Palmer
Date of Survey During construction.

Disposition and dimensions of superstructures, trunks, deckhouses and machinery casings to be inserted in the diagrams and tabular statement:—

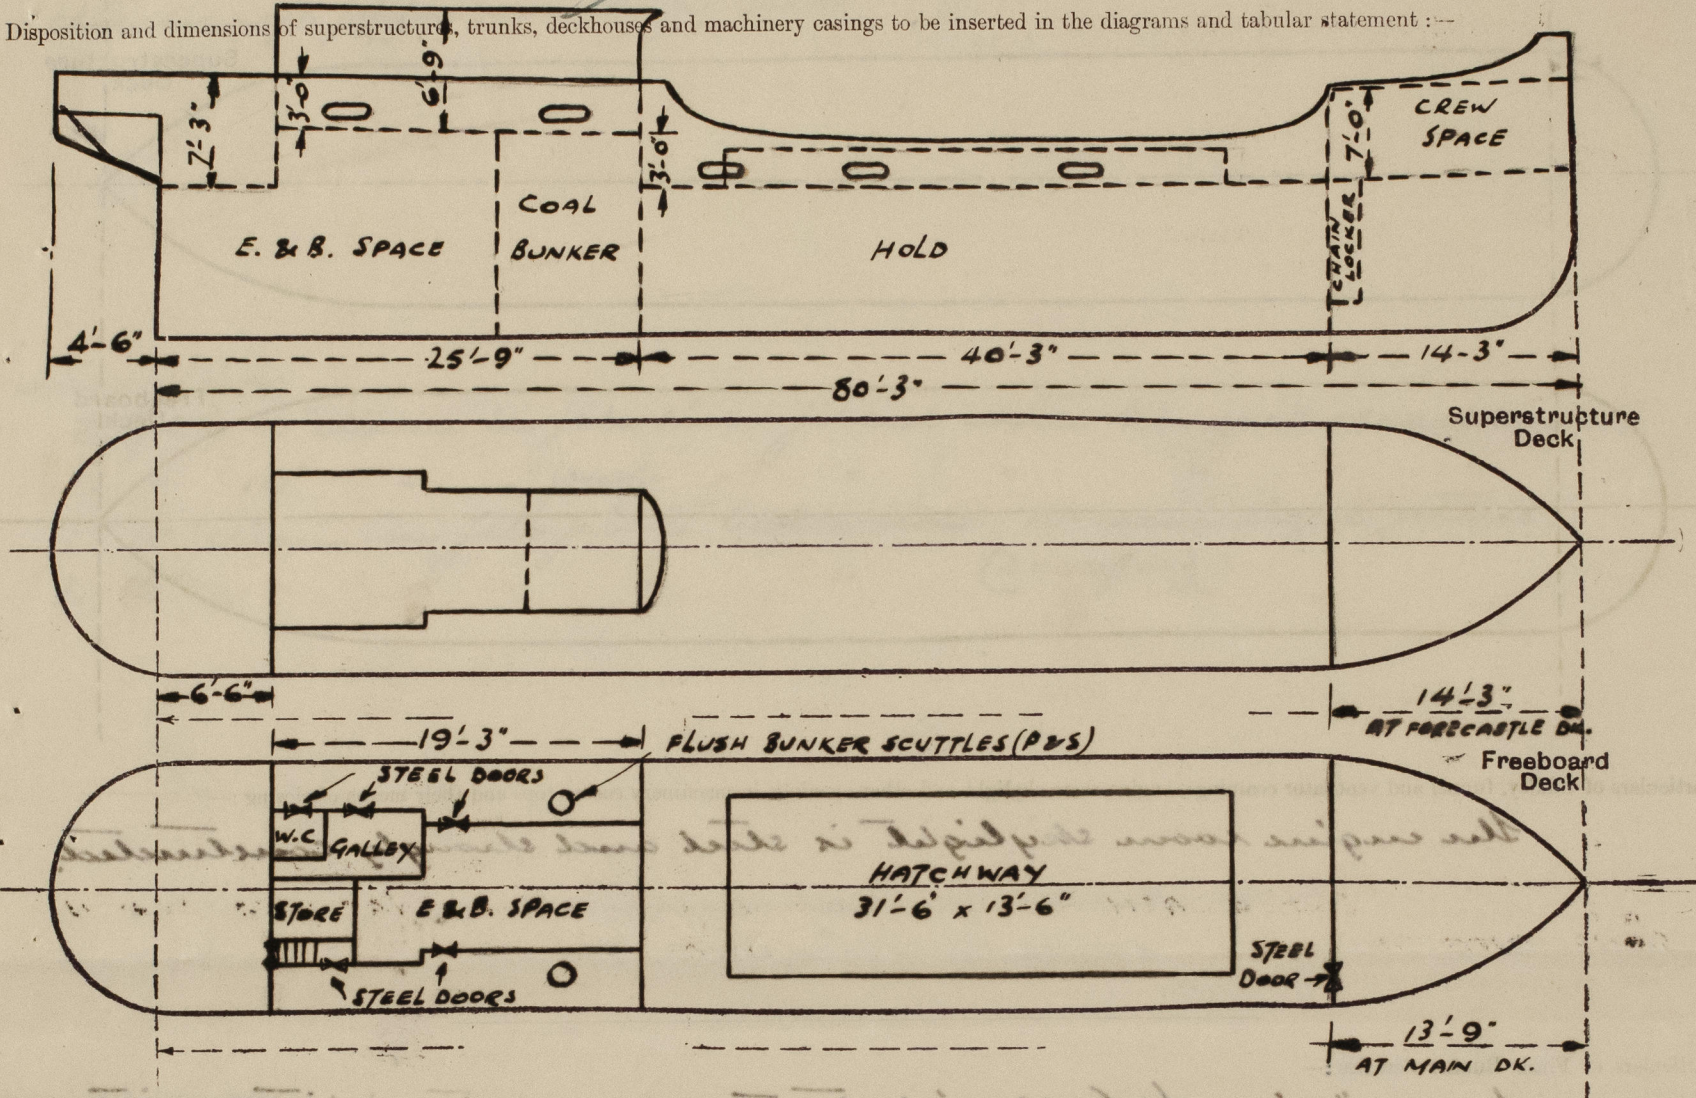

Particulars of Superstructures, Trunks, Casings, Deckhouses.


	Coaming	Plating	Stiffeners	Spacing	End Attachments of Stiffeners	Size of Openings	Height of Sills	Height of Casings
Poop Bulkhead	NONE	.26"	2 1/2 x 2 1/2 x .25	2'-6"	NONE	ONE IN ENCLOSED CASING	✓	3'-0" ABOVE R.Q. DECK
Raised Quarter Deck Bulkhead	"	.26"	1 1/2 x 2 1/2 x .30	2'-4 1/2"	BRACKETS AT TOP	NONE	✓	4'-3" BELOW "
Bridge, After Bulkhead								
Bridge, Forward Bulkhead								
Forecastle Bulkhead	NONE	.20"	2 1/2 x 2 1/2 x .25	2'-1 1/2"	NONE	4'-6" x 1'-9"	21"	7'-0"
Trunk, Aft								
Trunk, Forward								
Exposed Machinery Casings on Freeboard or Raised Quarter Decks	NONE	3/16"	3 x 5/16 PLATE	2'-4 1/2"	BRACKETS AT TOP	4'-1 1/2" x 1'-1 1/2"	18"	6'-9"
Exposed Machinery Casings on Superstructure Decks								
Machinery Casings within Superstructures not fitted with Class I Closing Appliances								
Deckhouses on Flush Deck Ships								

Particulars of Closing Appliances (state if capable of being manipulated from both sides).

Poop Bulkhead	One opening 7'-0" x 2'-6" in enclosed casing on S.S.
Raised Quarter Deck Bulkhead	✓ No openings.
Bridge, After Bulkhead	✓
Bridge, Forward Bulkhead	✓
Forecastle Bulkhead	One steel hinged door operated from both sides
Exposed Machinery Casings on Freeboard or Raised Quarter Decks	Five " " " 5 (3 per 2.55) " " " "
Exposed Machinery Casings on Superstructure Decks	
Machinery Casings within Superstructures not fitted with Class I Closing Appliances	
Deckhouses on Flush Deck Ships	

PARTICULARS OF PROTECTION TO OPENINGS, ETC.

The following diagrams should be used to indicate the positions of cargo and coaling hatchways, gangway, cargo and coaling ports, ventilators, companionways, etc., which would affect the seaworthiness of the ship:—

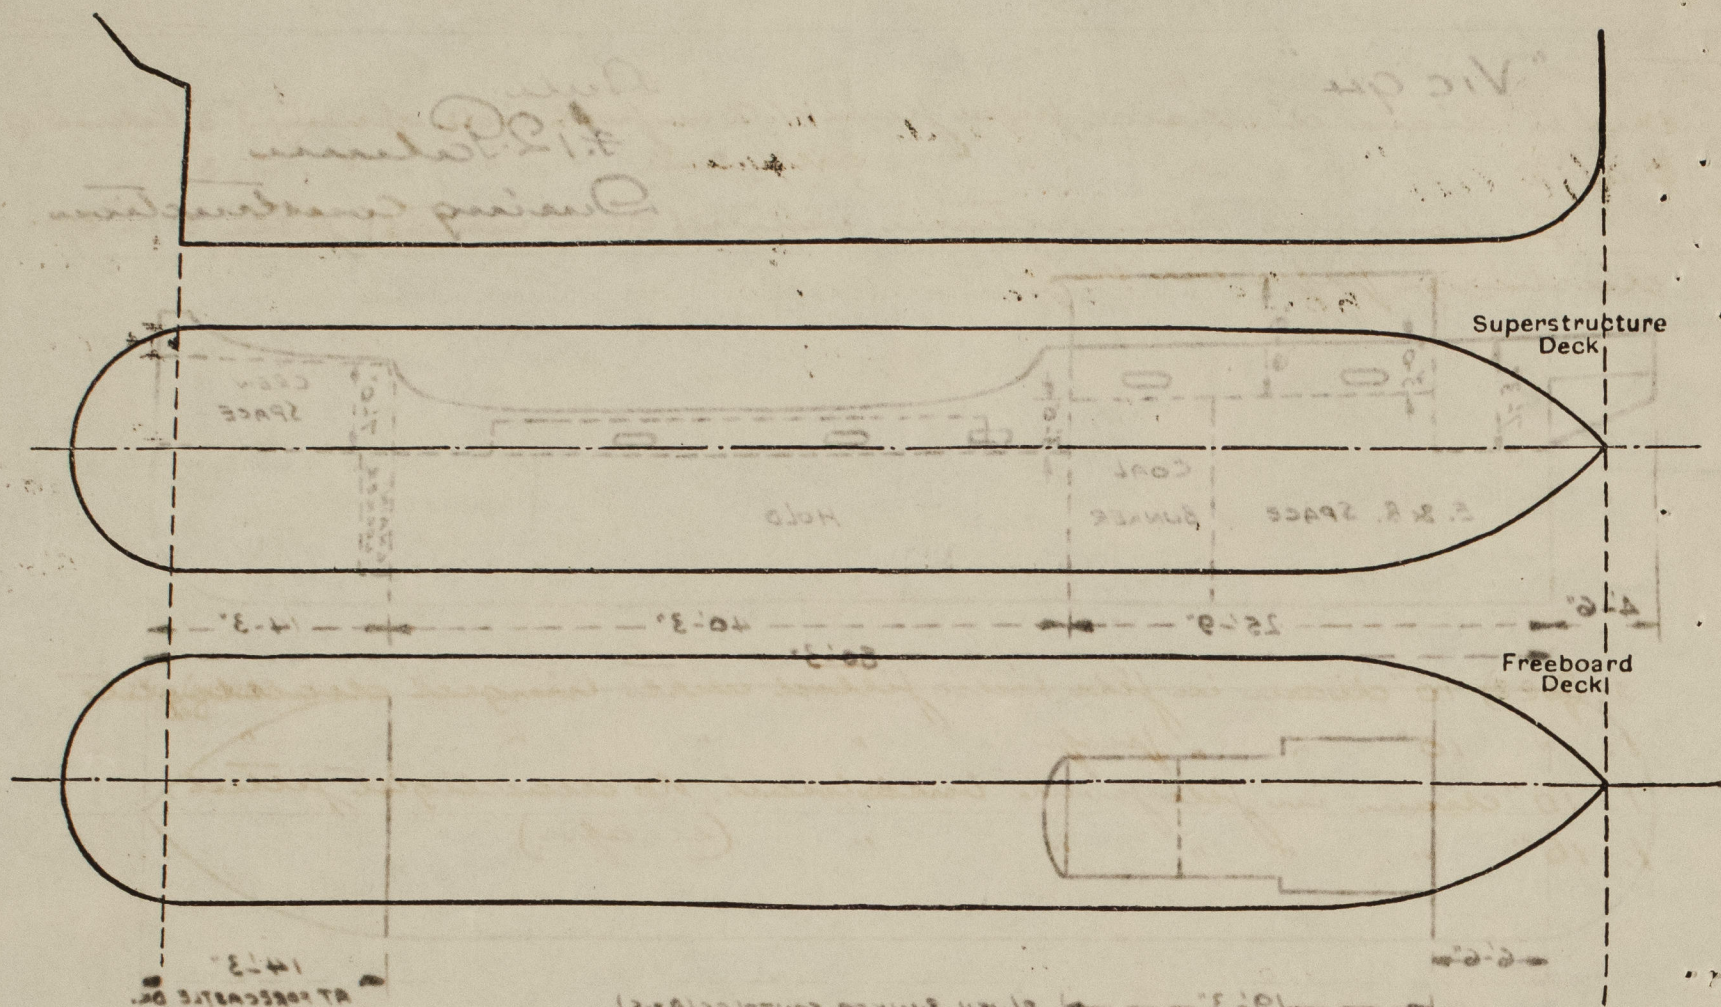

Particulars of fiddley, funnel and ventilator coamings, engine room skylight and other openings in machinery casing tops and their means of closing :—

The engine room skylight is steel and strongly constructed.

Particulars of Flush Bunker Scuttles :—

Two 17" diams (Woodhams patent, approved type) fitted with chain attachments on the underside to a drive beam. ✓

Particulars of Companionways :—

None.

Particulars of Ventilators in exposed positions on freeboard and superstructure decks :—

Two comb ventilators on foreboard deck to hold, 10" diam, coaming 36" x 34".
Two " " " file deck to crew space. 8" " " 36" x 30"
One " " " poop " " cabin 6" " ✓ " 30" x 30"

All ventilators are constructed in accordance with the Rules and provided with wood plugs and canvas covers.

Particulars of Air Pipes in exposed positions on freeboard, raised quarter, or superstructure decks :—

One C.I. air pipe one side deck 2'-0" high, $\times 1\frac{1}{2}$ " diam to fore peak tank.
Wood plug with chain attachment provided for closing the opening.

Particulars of Gangway Cargo and Coaling Ports:—

Name. ✓

Particulars of Scuppers and Sanitary Discharge Pipes :—

One 4" diam discharge pipe from W.C. on port side, opening 2'-3" below R.Q. Deck.
One 1½" " " " " galley sink " " " 2'-3" " " "
Automatic non-return valves (gun metal) fitted to each
discharge pipe on ship's side.

Particulars of Side Scuttles :—

2. (yes) 10" diam in felt side fitted with binged deadlight.
1. " 10" " " prop " " "
1. 10" diam in felt front bulkhead. No deadlight fitted.
1. 16" " " " " " (escape)

Vertical distance of Sill of lowest Side Scuttle above top of keel

13-0"

Particulars of Guard Rails :—

Fixed round sides @ after end of file deck.
" " proof deck.

Particulars of Gangways, Lifelines, etc. :—

Our lifeline (p. 25) from fore end of 12. Q. deck
to forecastle bulkhead.

Particulars of Freeing Arrangements.

	Length of Bulwark	Height of Bulwark	Size of Freeing Ports	Number each side	Area each side	Rule area each side
After Well	19.25	3'-0"	4'-6" x 1'-0"	Two	9 sf	8.45 f.
Forward Well	40.25	3'-0"	4'-6" x 1'-0"	Four	18 sf	* 15.73 s.f.

State position of each freeing port (After Well:— *From R.O. DECK FORWARD BULKHEAD TO FORE END OF EACH OPENING*
18" x 11'-0"


(F. and A. position and height above deck edge) } Forward Well:— *FROM FILE BULKHEAD TO FORE END OF EACH OPENING.*
 3'-6", 13'-0", 22'-9" @ 32'-0". *4" ABOVE DECK EDGE*

State whether the freeing ports are fitted with shutters, bars, or rails, and give particulars of such:— *ONE 2" FLAT BAR.*

Additional area where sheer is less than standard.

* Includes 50% even
for no shear. © 2

PARTICULARS OF PROTECTION TO OPENINGS, ETC.

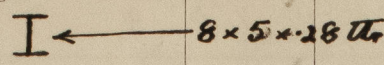HATCHWAYS ON FREEBOARD AND SUPERSTRUCTURE DECKS.											
Description of Hatchway		MAIN									
Dimensions of Hatchway		31'-6" x 13'-6"									
COAMINGS	Height above Deck	2'-3"									
	Thickness	.36									
	Sides	.36									
	Stiffeners	.30									
	Brackets, Stays	.30									
HATCH BEAMS	Number	7									
	Spacing	4'-0"									
	Scantling and Sketch										
	Bearing Surface	3 1/2									
	FORE AND AFTERS	NONE									
HATCH COVERS	Material	WOOD									
	Thickness	2 1/2"									
	How fitted	F.L.A.									
	Bearing Surface	2 1/2"									
Spacing of Cleats		2'-0"									
Number of Tarpaulins		2									
<p>*Are wood fore and afters steel shod at all bearing surfaces? <input checked="" type="checkbox"/> YES</p> <p>Are battens and wedges efficient and in good condition? <input checked="" type="checkbox"/> YES</p> <p>Are tarpaulins in good condition and in accordance with rule requirements? <input checked="" type="checkbox"/> YES</p> <p>Are lashings provided in accordance with rule requirements? <input checked="" type="checkbox"/> YES</p>											

Particulars of any special features:—

EXTRA LASHINGS ARE PROVIDED FOR THE MAIN HATCHWAY WHICH CONSTITUTE THE SPECIAL LASHINGS FOR HATCHWAYS EXCEEDING IN BREADTH 60% OF THE BREADTH OF THE SHIP.

Endorsement at first survey and at surveys for renewal of Certificate:—

The fittings and appliances are in accordance with the particulars shown on this form (or as now modified) and are in good condition.



© 2021

Lloyd's Register Foundation