

S.S.N. 71.

31.5.06

English Sections	Equivalent German
6 x 3 x 8/20 - 9/20	150 x 75 x 10 - 11
7 x 3 x 9/20	165 x 75 x 12
7 x 3 x 10/20	180 x 80 x 12
7 x 3 x 12/20	180 x 80 x 14.5 190 x 75 x 14
7 1/2 x 3 x 9/20 - 10/20	190 x 75 x 11 - 13
8 x 3 1/2 x 10/20	200 x 85 x 13
8 1/2 x 3 1/2 x 10/20	220 x 90 x 12
9 x 3 1/2 x 10 1/2 9/20	220 x 90 x 14 - 12.5
9 x 3 1/2 x 12 1/2 11/20	240 x 95 x 14.5 - 14

Dimensions:
Length between perpendiculars 288'-1" 87.80 m.
Breadth moulded 48'-6" 12.95.
Depth moulded 19'-7" 5.97.
Height of Quarterdeck 4'-0" 1.22.
Bridge & Forecastle 7'-0" 2.14.
Class: Lloyds + 100 A 1.
- Lloyd's Numerals -
1/2 Breadth 21'-3" 21-3
1/2 Girth 39'-0 1/2 43-0 1/2
Depth 20'-5 1/2 24-5 1/2
1st Number 80-9 and 88-9 for quarterdeck
Length 288.08
2nd Number 23 263
Lg. 6.78. Lg = 14.1.

Equipment Number 25956.

2 Bower anchors stockless	at 39 Cnts.
1 Bower anchor	32
1 Stream anchor excl. hook	10
1 Kedge anchor	5
240 fathoms stud chain cables 13/16"	
75 " 4 1/4" steel wire	
90 " 4 " "	
2 at 90 fathoms 7" Manila	
2 - 90 " 6 " "	


Strake No. 1
In way of bridge 1 1/2" Butts
treble riveted and overlapped
In way of poop & forecastle 7/20
Butts double riveted and overlapped.

Strake L
In way of bridge 10/20
at break 20/20 off
at bridge bulkhead 13/20

In way of forecastle 7/20
Butts in way of bridge treble
riveted, forecastle double
riveted.

Sheerstrake K
42" x 13/20 L 1/2 L
ends 10/20
at break 13/20
at bridge bulkhead 20/20

All landing edges of shell to be double riveted.
Butts of outside plating overlapped and to be
treble rivet.
Butts of inside strake quadruple rivet where over 54" wide.
Butts of outside strake quadruple rivet where over 48".

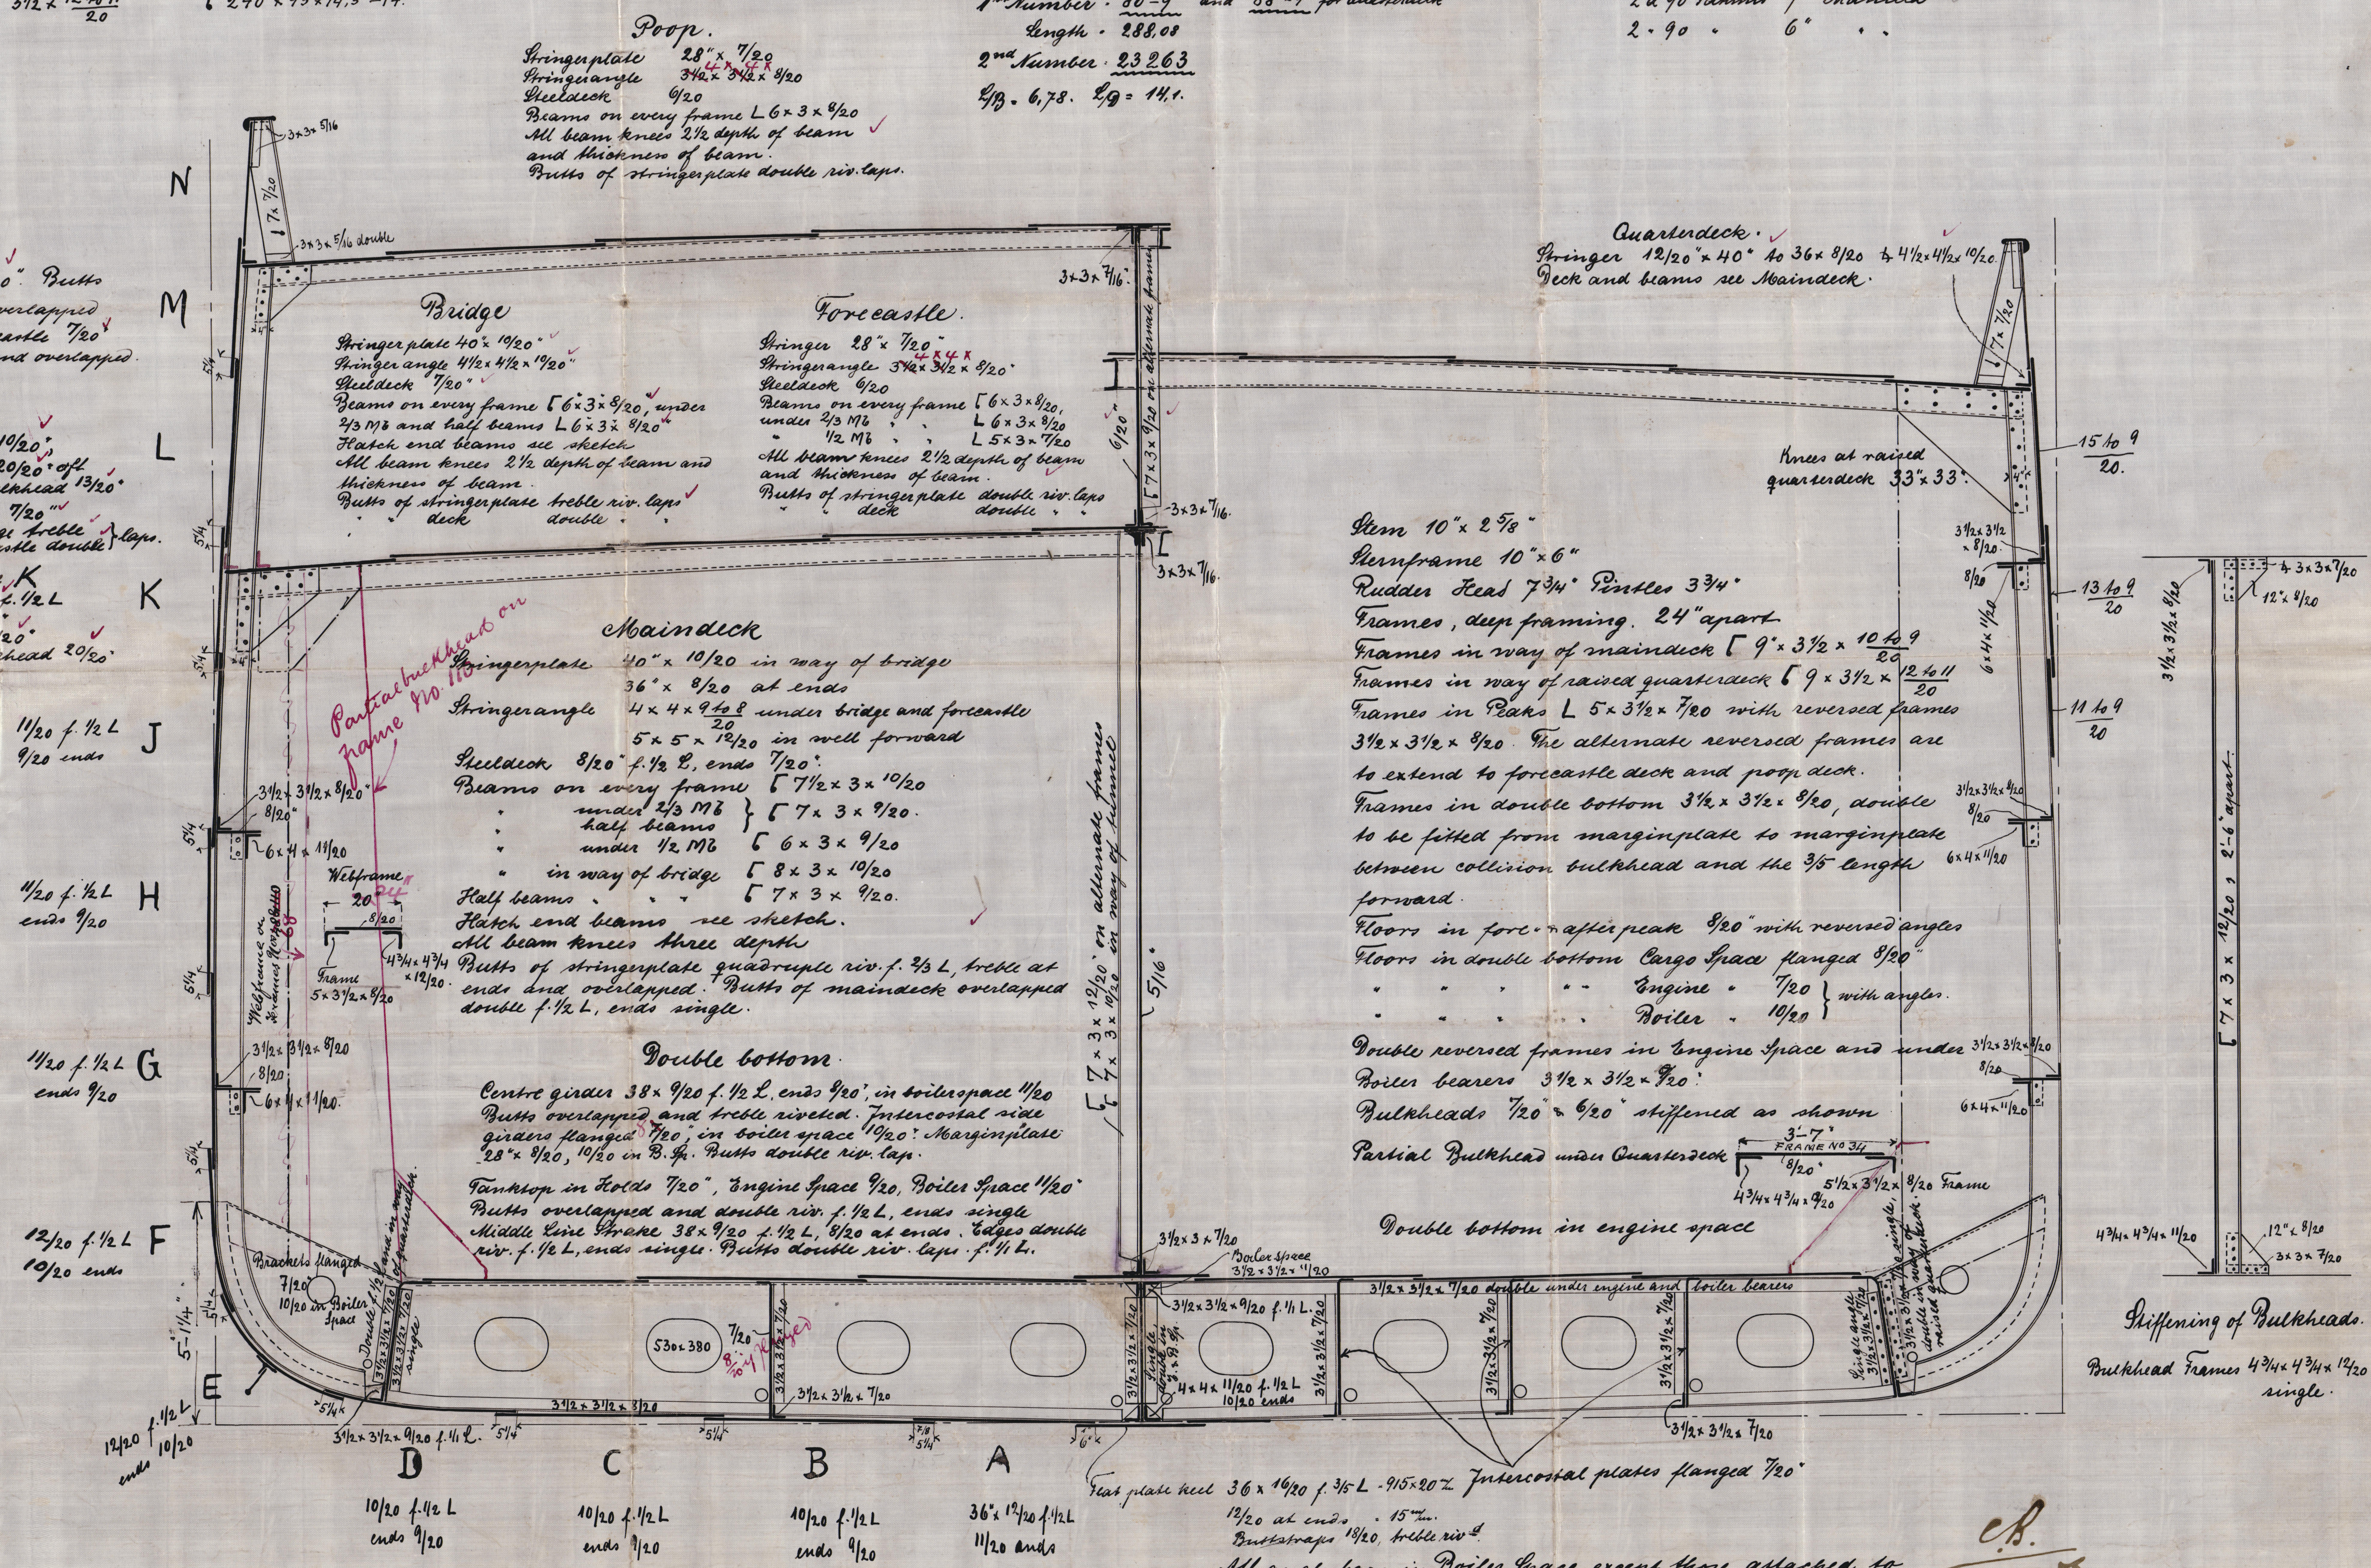

Strake B & C of outside plating to have the midships thickness maintained forward to the collision bulkhead and bottom forward strengthened as per Rules.

All angle bars in Boiler Space, except those attached to outside plating to be 1/2" thick of an inch thicker than given in the above Table.

C.B.
31.5.06.

HAMBURG LETTER 29. 5. 06

Levensan
Ham 9689.

Berta

© 2020

Lloyd's Register
Foundation

007909-007918-0272