


5.4.06

S. S. No. 71  
Nordersteven.  
1:20, 1:10.

Material: Schmiedeeisen 100 kg. Lloyd's Allot

Alle Maße sind Millimeter

Approved 5.4.06  
C.A.

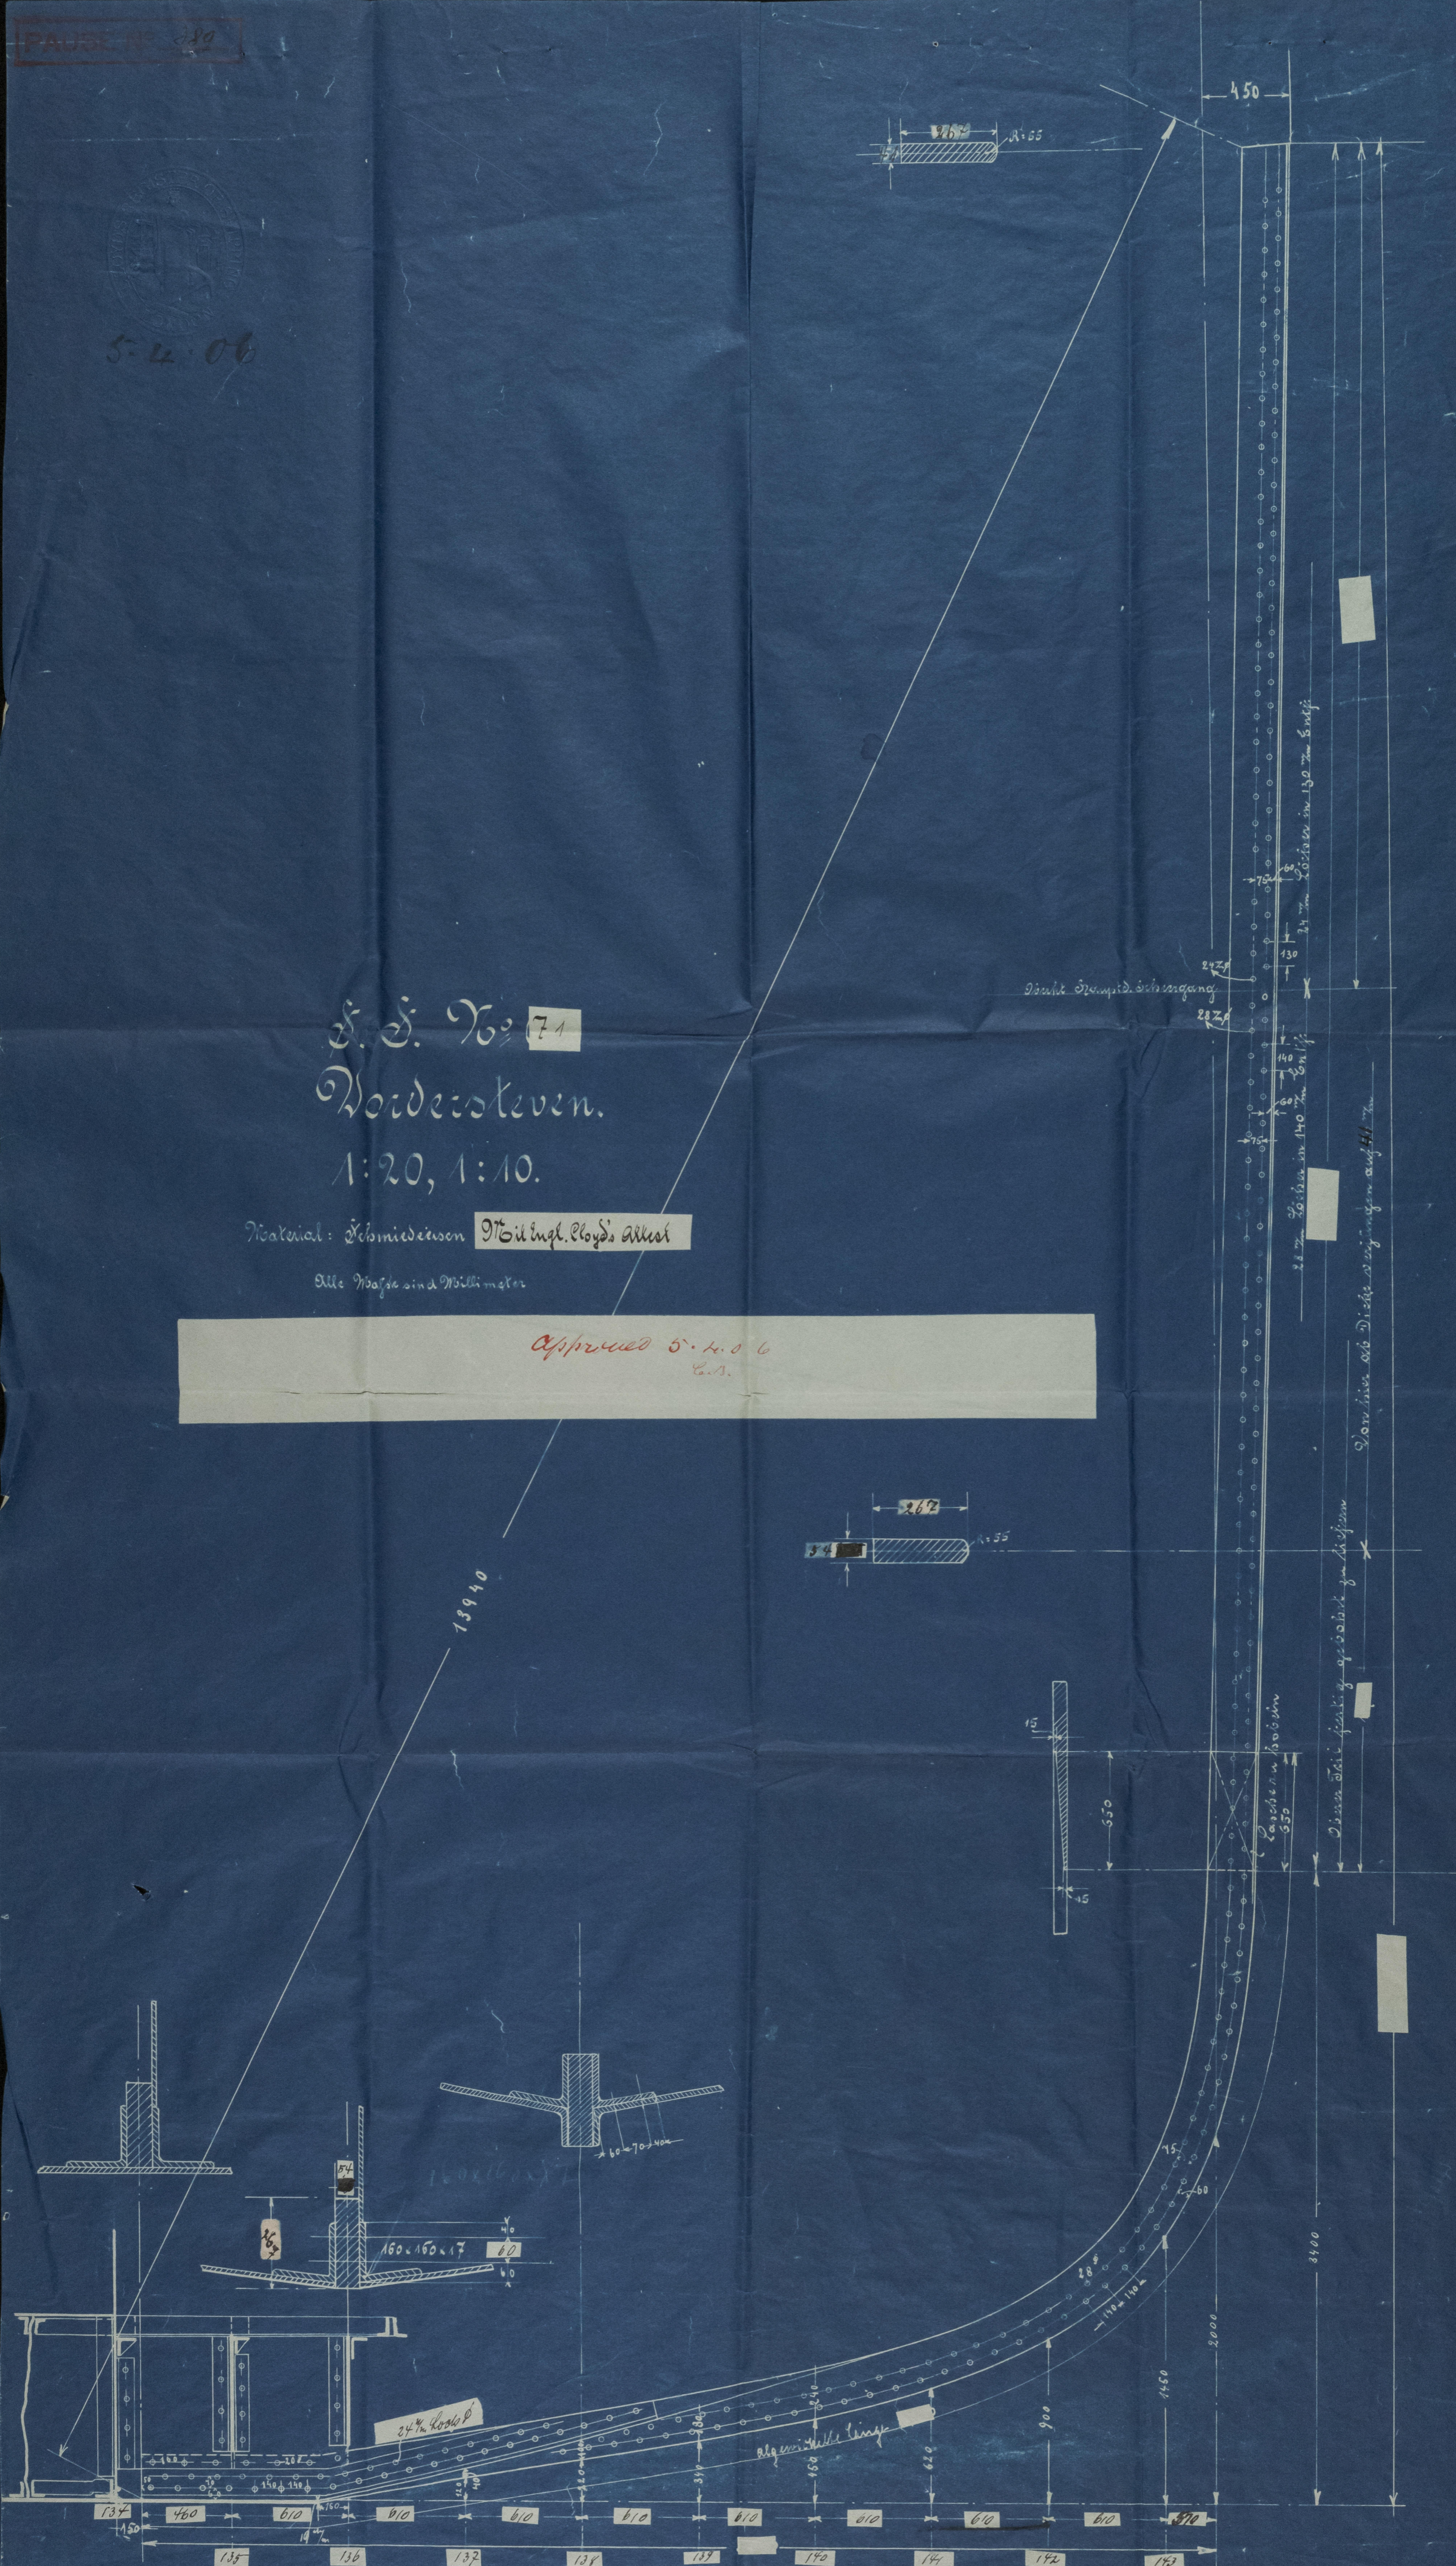


Sketch of Steamer  
Eider Ucraft No 41


Hamburg letter

31. 3. 06

Levensau  
Ham 9889.

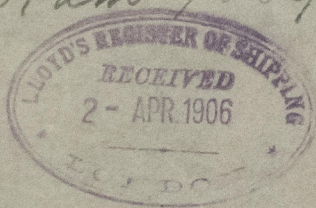

Hüsseldorf office - 9 JUNE 1906  
Oberb. Stahlwerk

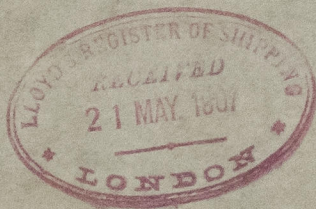

© 2020

Lloyd's Register  
Foundation

007909-007918-0273