


COSTRUITO: <i>g. m.</i>	UFFICIO TECNICO MECCANICO	MONFALCONE 27/2/25
COPIATO: <i>g. m.</i>		


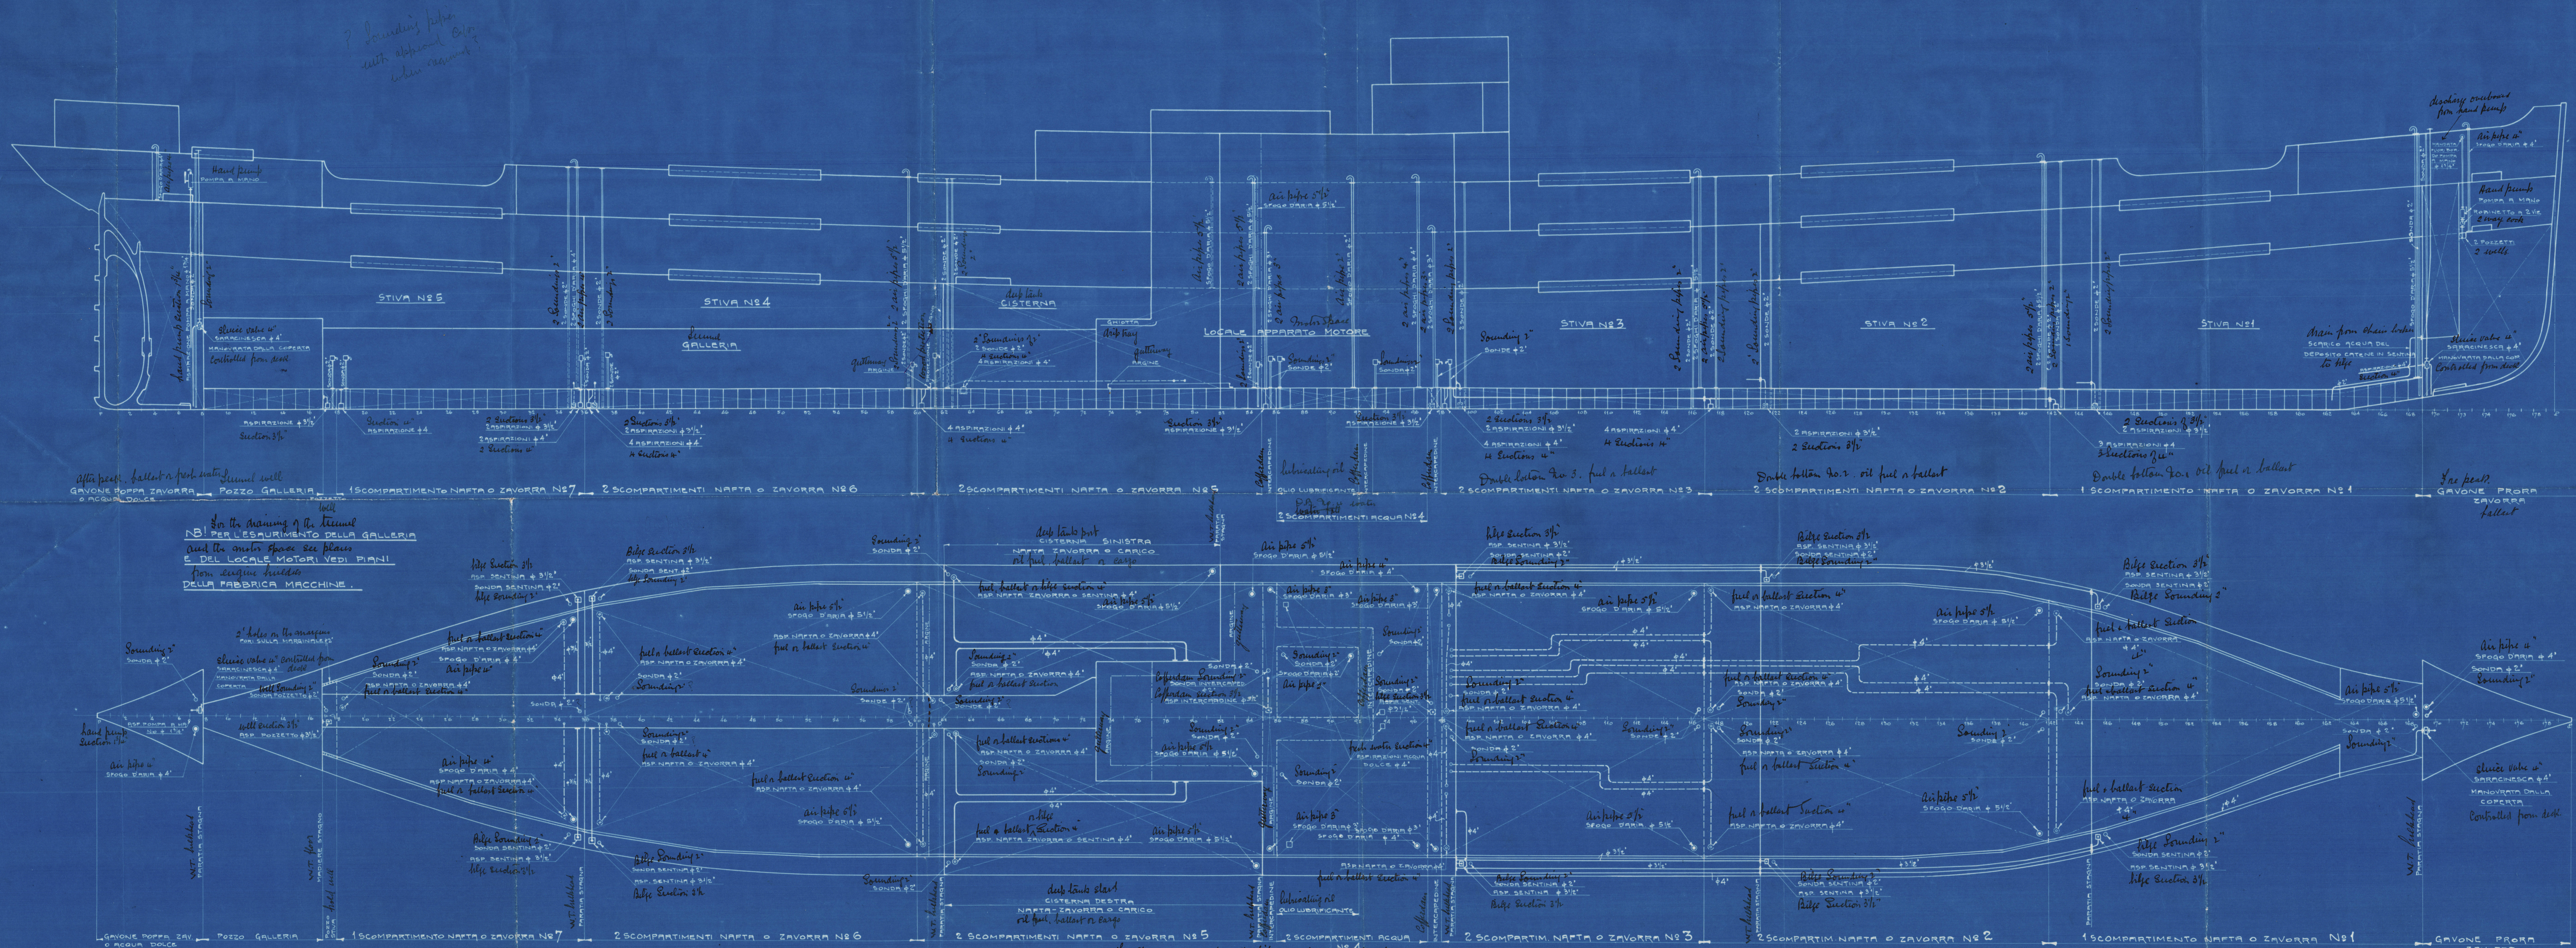

See letter re area of air pipes A.T.G. 29-4-25