



Plan showing Altered Part of Stem post  
with new Sections.

S.S. No 181

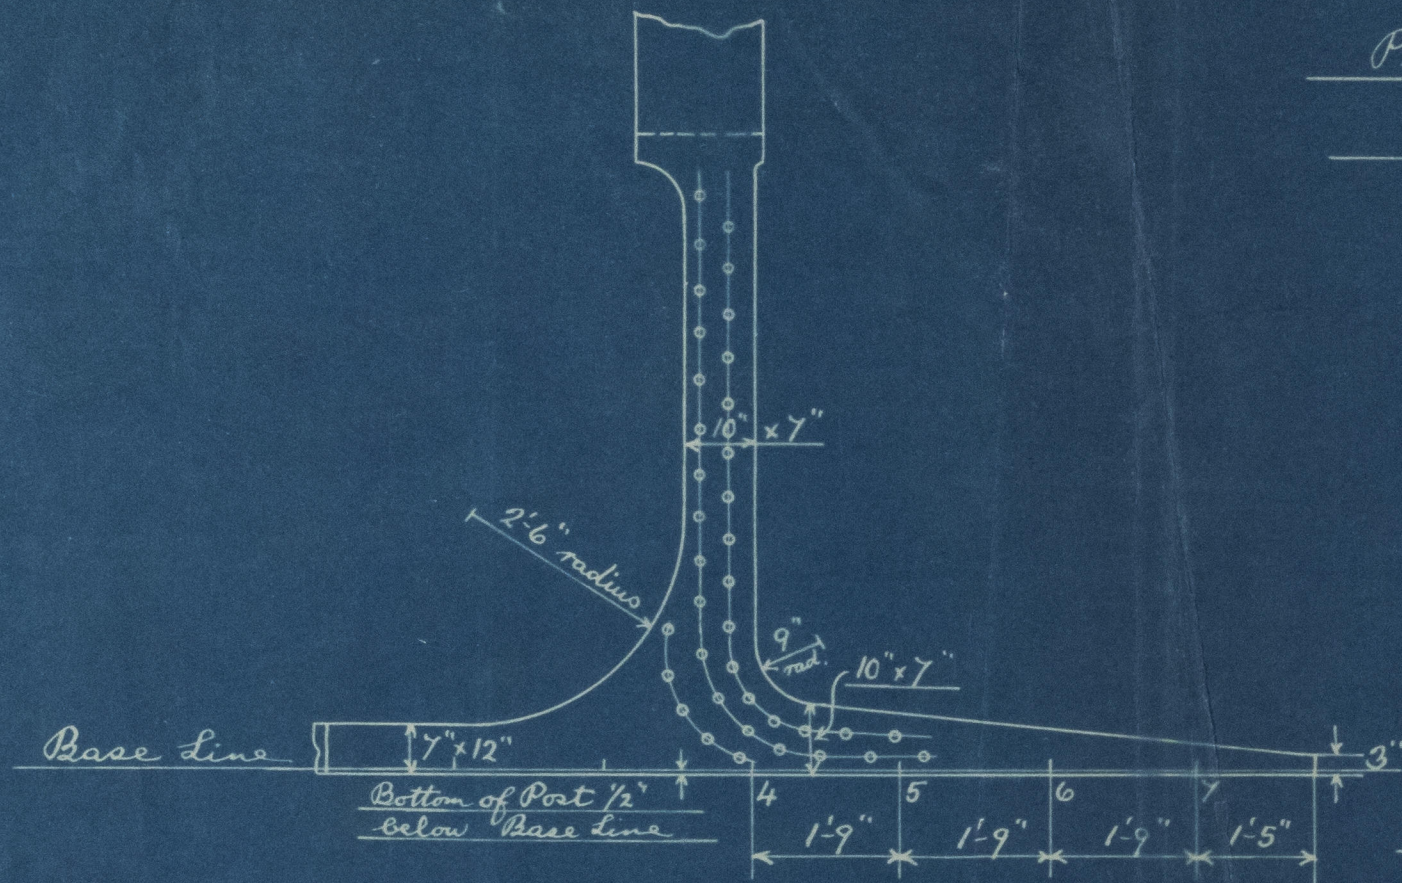

Elevation  
Scale 1/2" = 1 foot

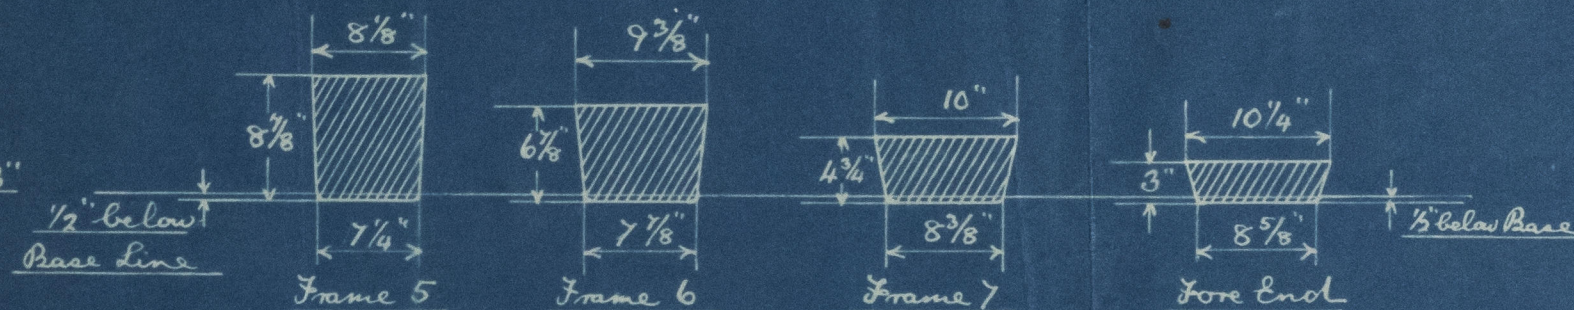

Sections thro' Bottom Part of Post  
Scale 1" = 1 foot



Lloyd's Register  
Foundation