


# HINTERSTEVEN.

— 1:20 —

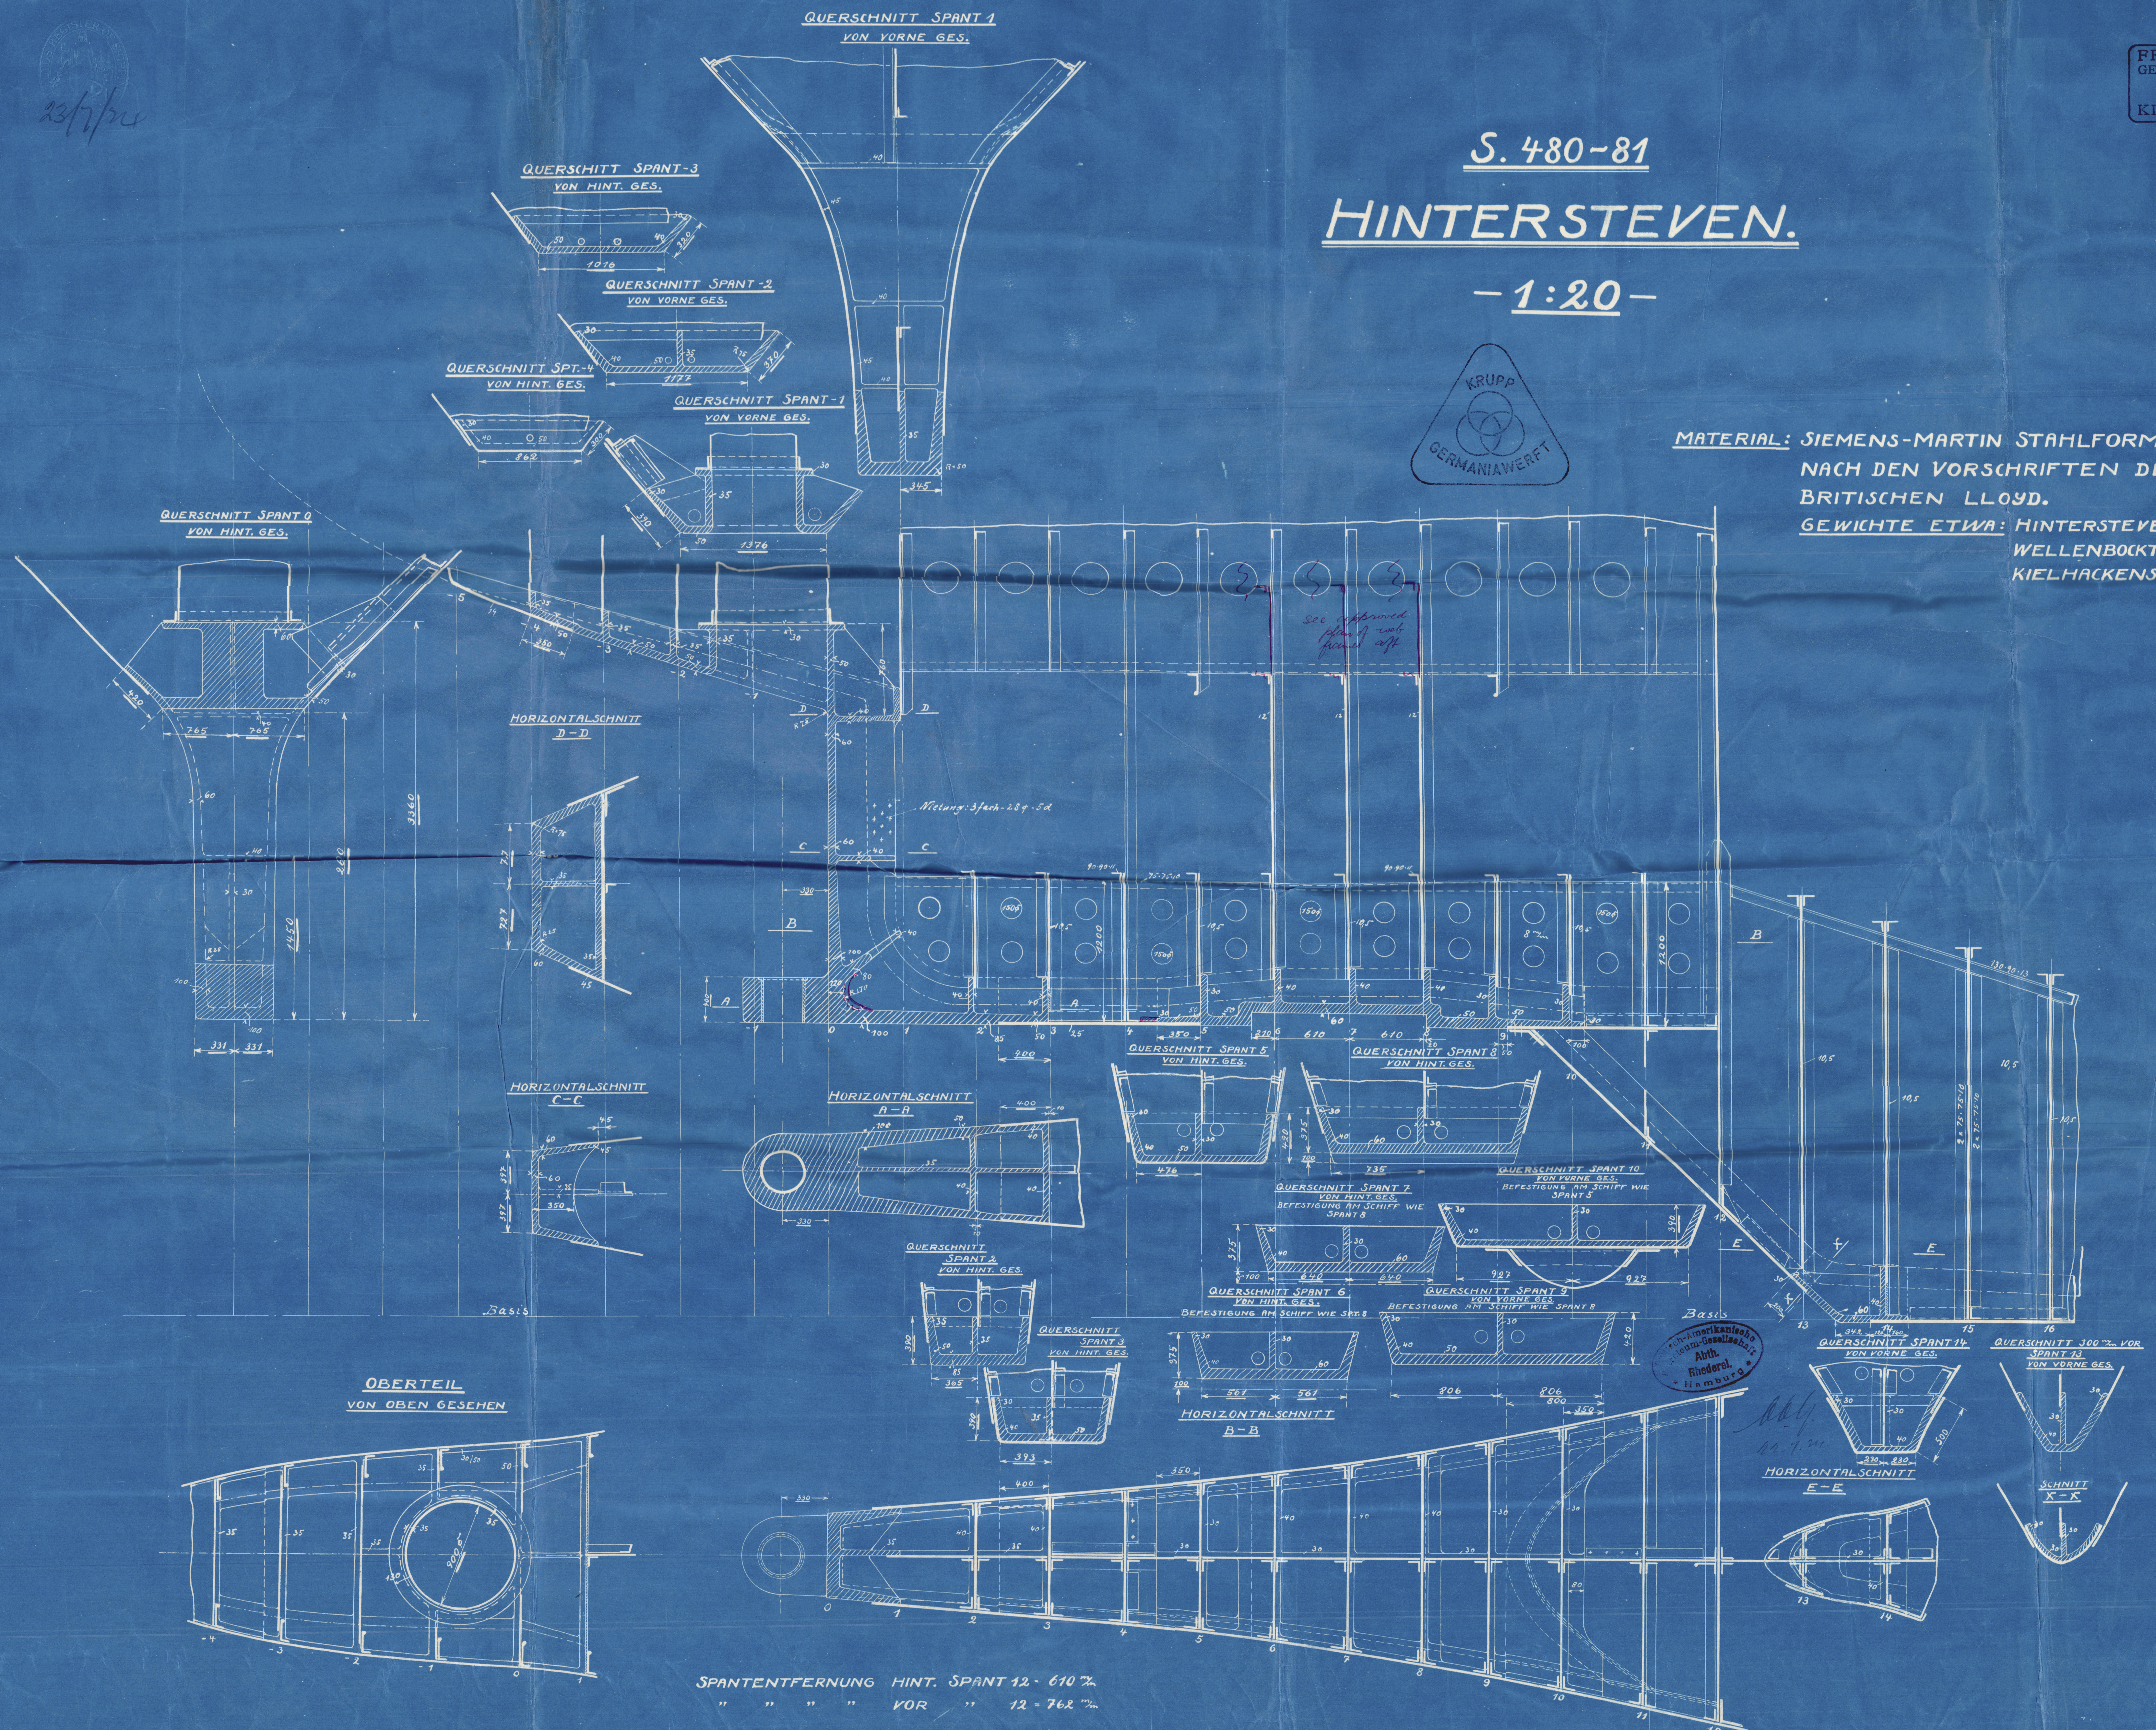

GEWICHTE ETWA: HINTERSTEVEN 8900 KG  
WELLENBOCKTRÄGER 3800 KG  
KIELHACKENSCHUH 400 "





1


Stern frame

Krupp's Nos. 480/481

Hamburg letter 14/24. 24

Hamburg Report Nr. 16800

H

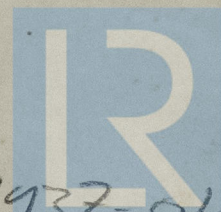

© 2020

Lloyd's Register  
Foundation

007430-007437-012