

19.7.28



PROFILE & DECK PLAN

N^o 125

DIMENS^s 139'-6" B.P. x 29'-6" M^{LD} x 12'-9" M^{LD}

SCALE 1/4" = ONE FOOT.

To CLASS LLOYDS 100 A.I. HOPPER DREDGER FOR SERVICE IN NORTHERN CHINA.
STRENGTHENED FOR NAVIGATION THROUGH ICE.

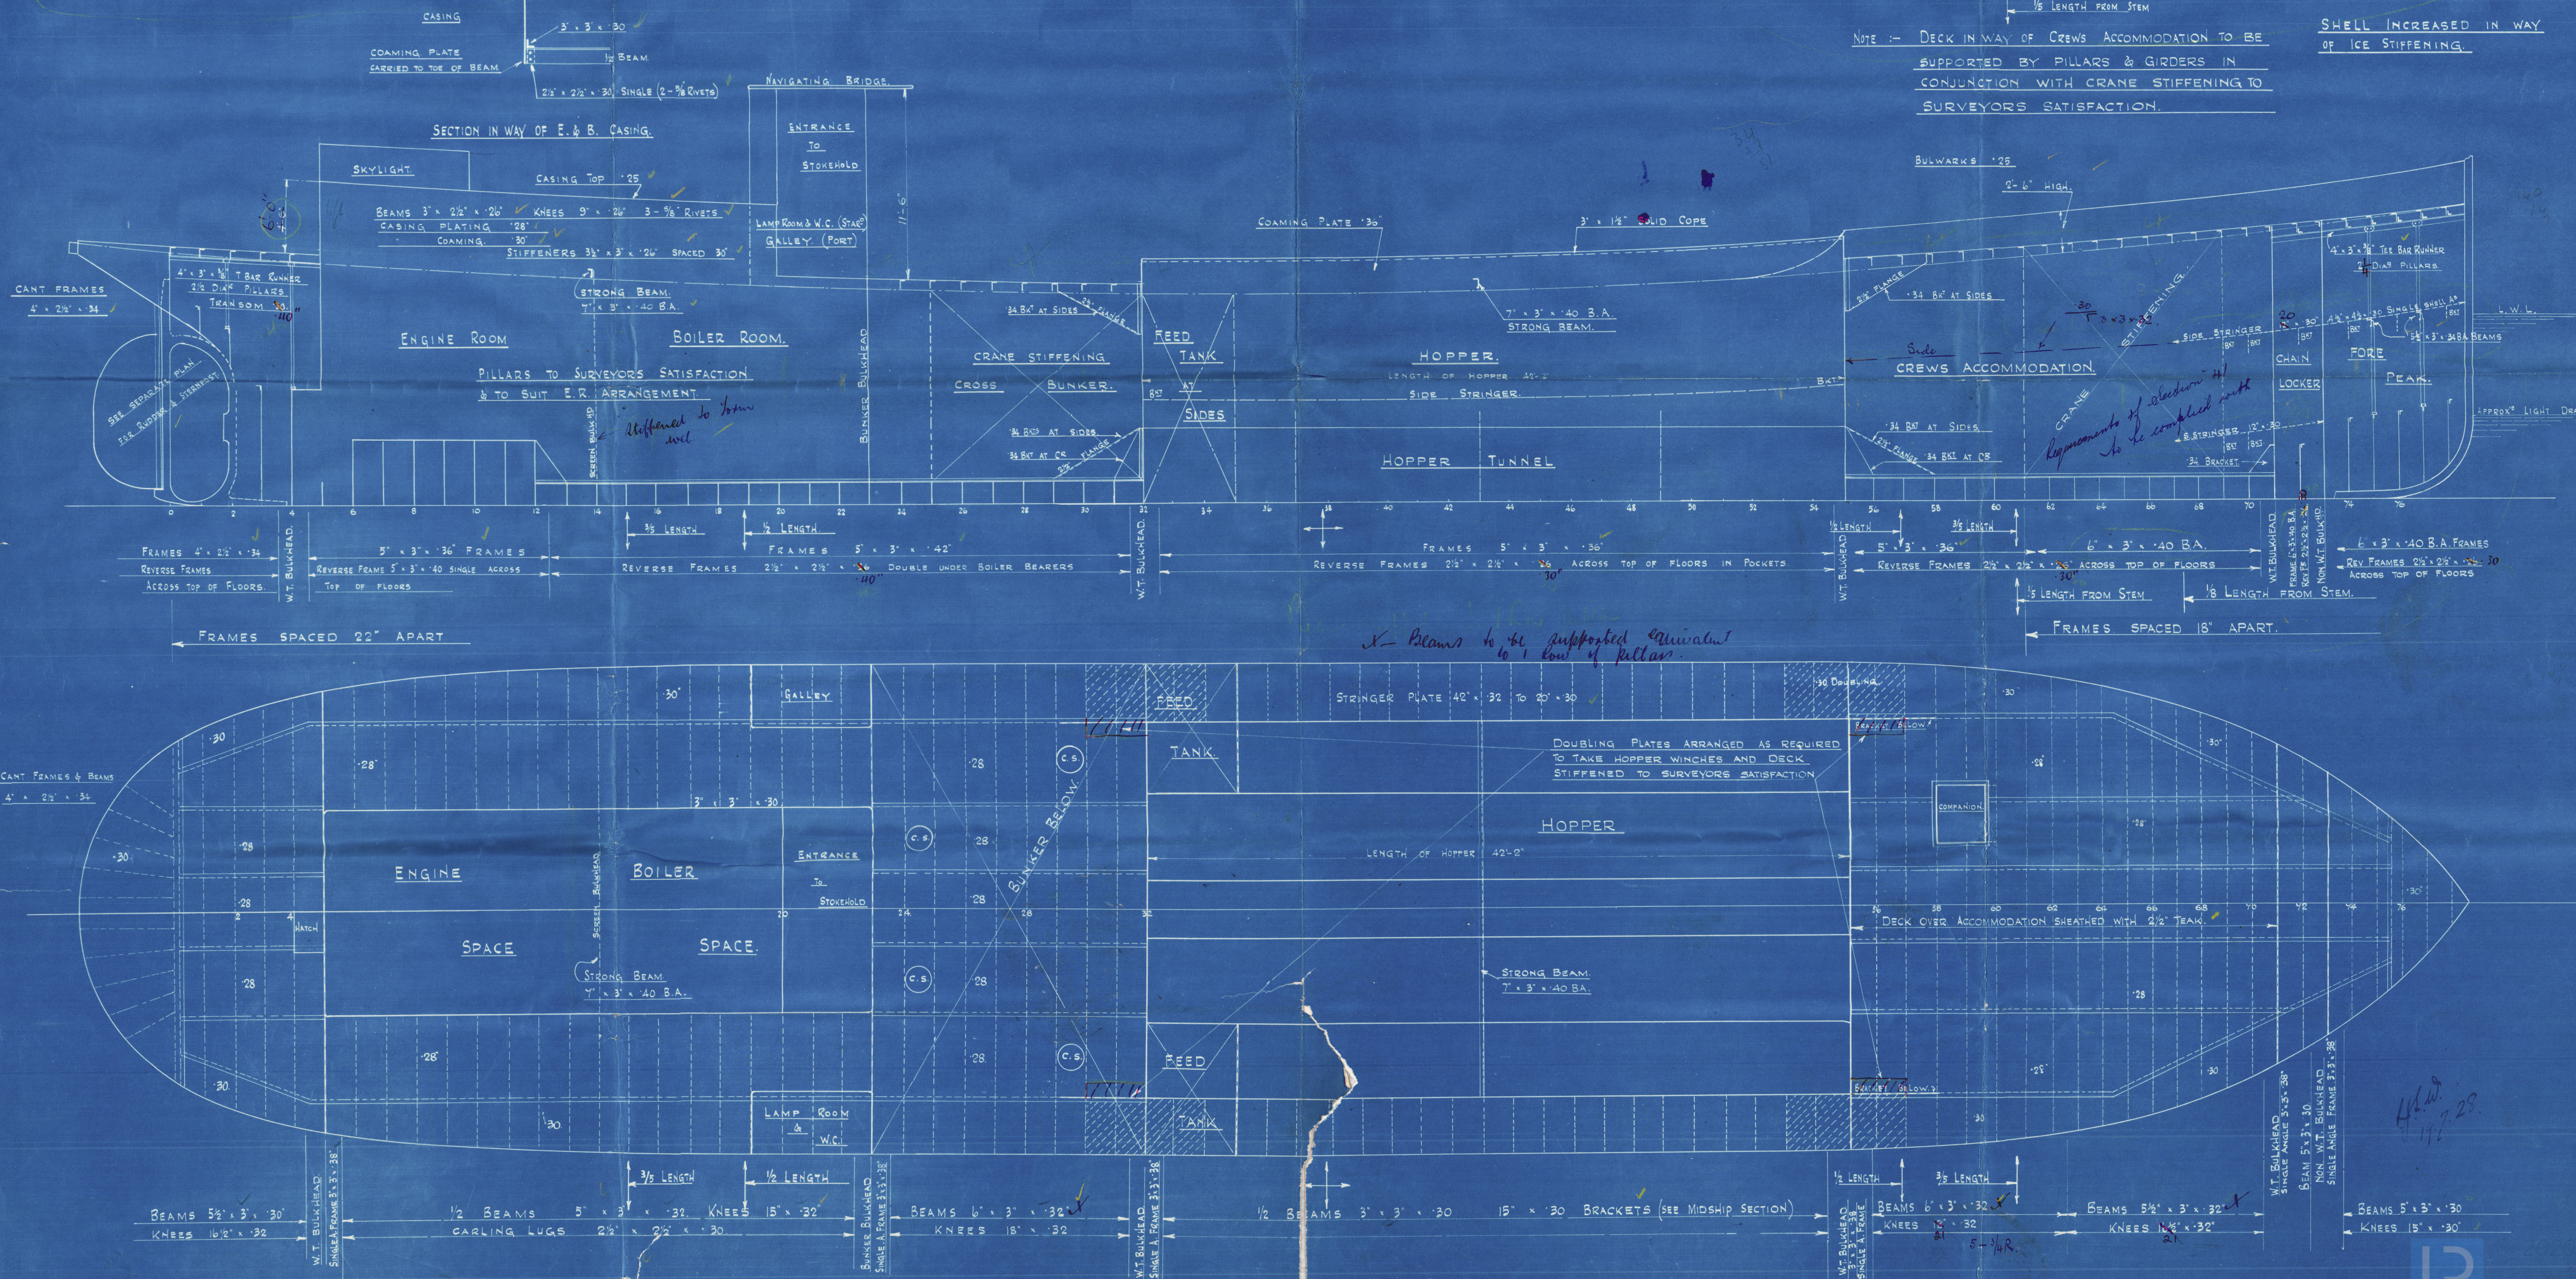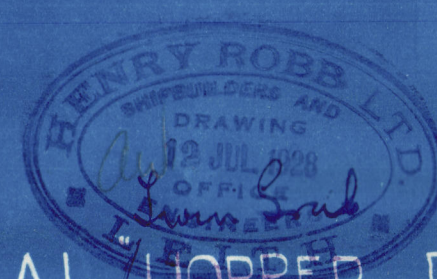

14.7.28


12020 00 1000 009032-02/5

miss Henry Robb h^d

BS N^o 125

Profile & Decks

Chen Ping

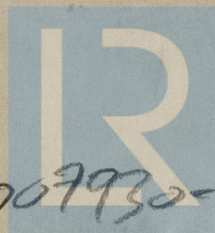

© 2020

Lloyd's Register
Foundation

007930-007937-0215