


EQUIPMENT
 2 STOCKLESS ANCHORS 28 CWTs.
 1 STRAIN ANCHOR STOCKLESS 8 1/2 CWTs.
 1 KEDGE ANCHOR 5 CWTs.
 CABLE 210 FATHOMS 1 3/4" STUD CHAIN
 STREAMLINE 175 FATHOMS 3 1/2" STEEL WIRE
 TOWLINE 1 1/2" 33' 1/2"
 MANILLA 6"
 WARP 1-30 " 5"

RIVETING
 KEEL BUTTS QUADRUPLE OVERLAPS TO TREBLE AT ENDS
 BOTTOM PLATING BUTTS TREBLE OVERLAPS IN OIL TO DOUBLE AT ENDS
 SIDE PLATING BUTTS TREBLE OVERLAPS IN OIL TO DOUBLE AT ENDS
 SHEER STRAKE BUTTS QUADRUPLE OVERLAPS TO DOUBLE AT ENDS CLEAR OF OIL COMPARTMENTS
 CENTER KEEL BUTTS TREBLE RIV OVERLAPS
 UPPER DECK STRINGER BUTTS TREBLE OVERLAPS TO DOUBLE AT ENDS
 UPPER DECK PLATING BUTTS DOUBLE IN WAY OF OIL TO SINGLE AT ENDS
 TRUNK TOP & SIDE BUTTS DOUBLE RIVETED

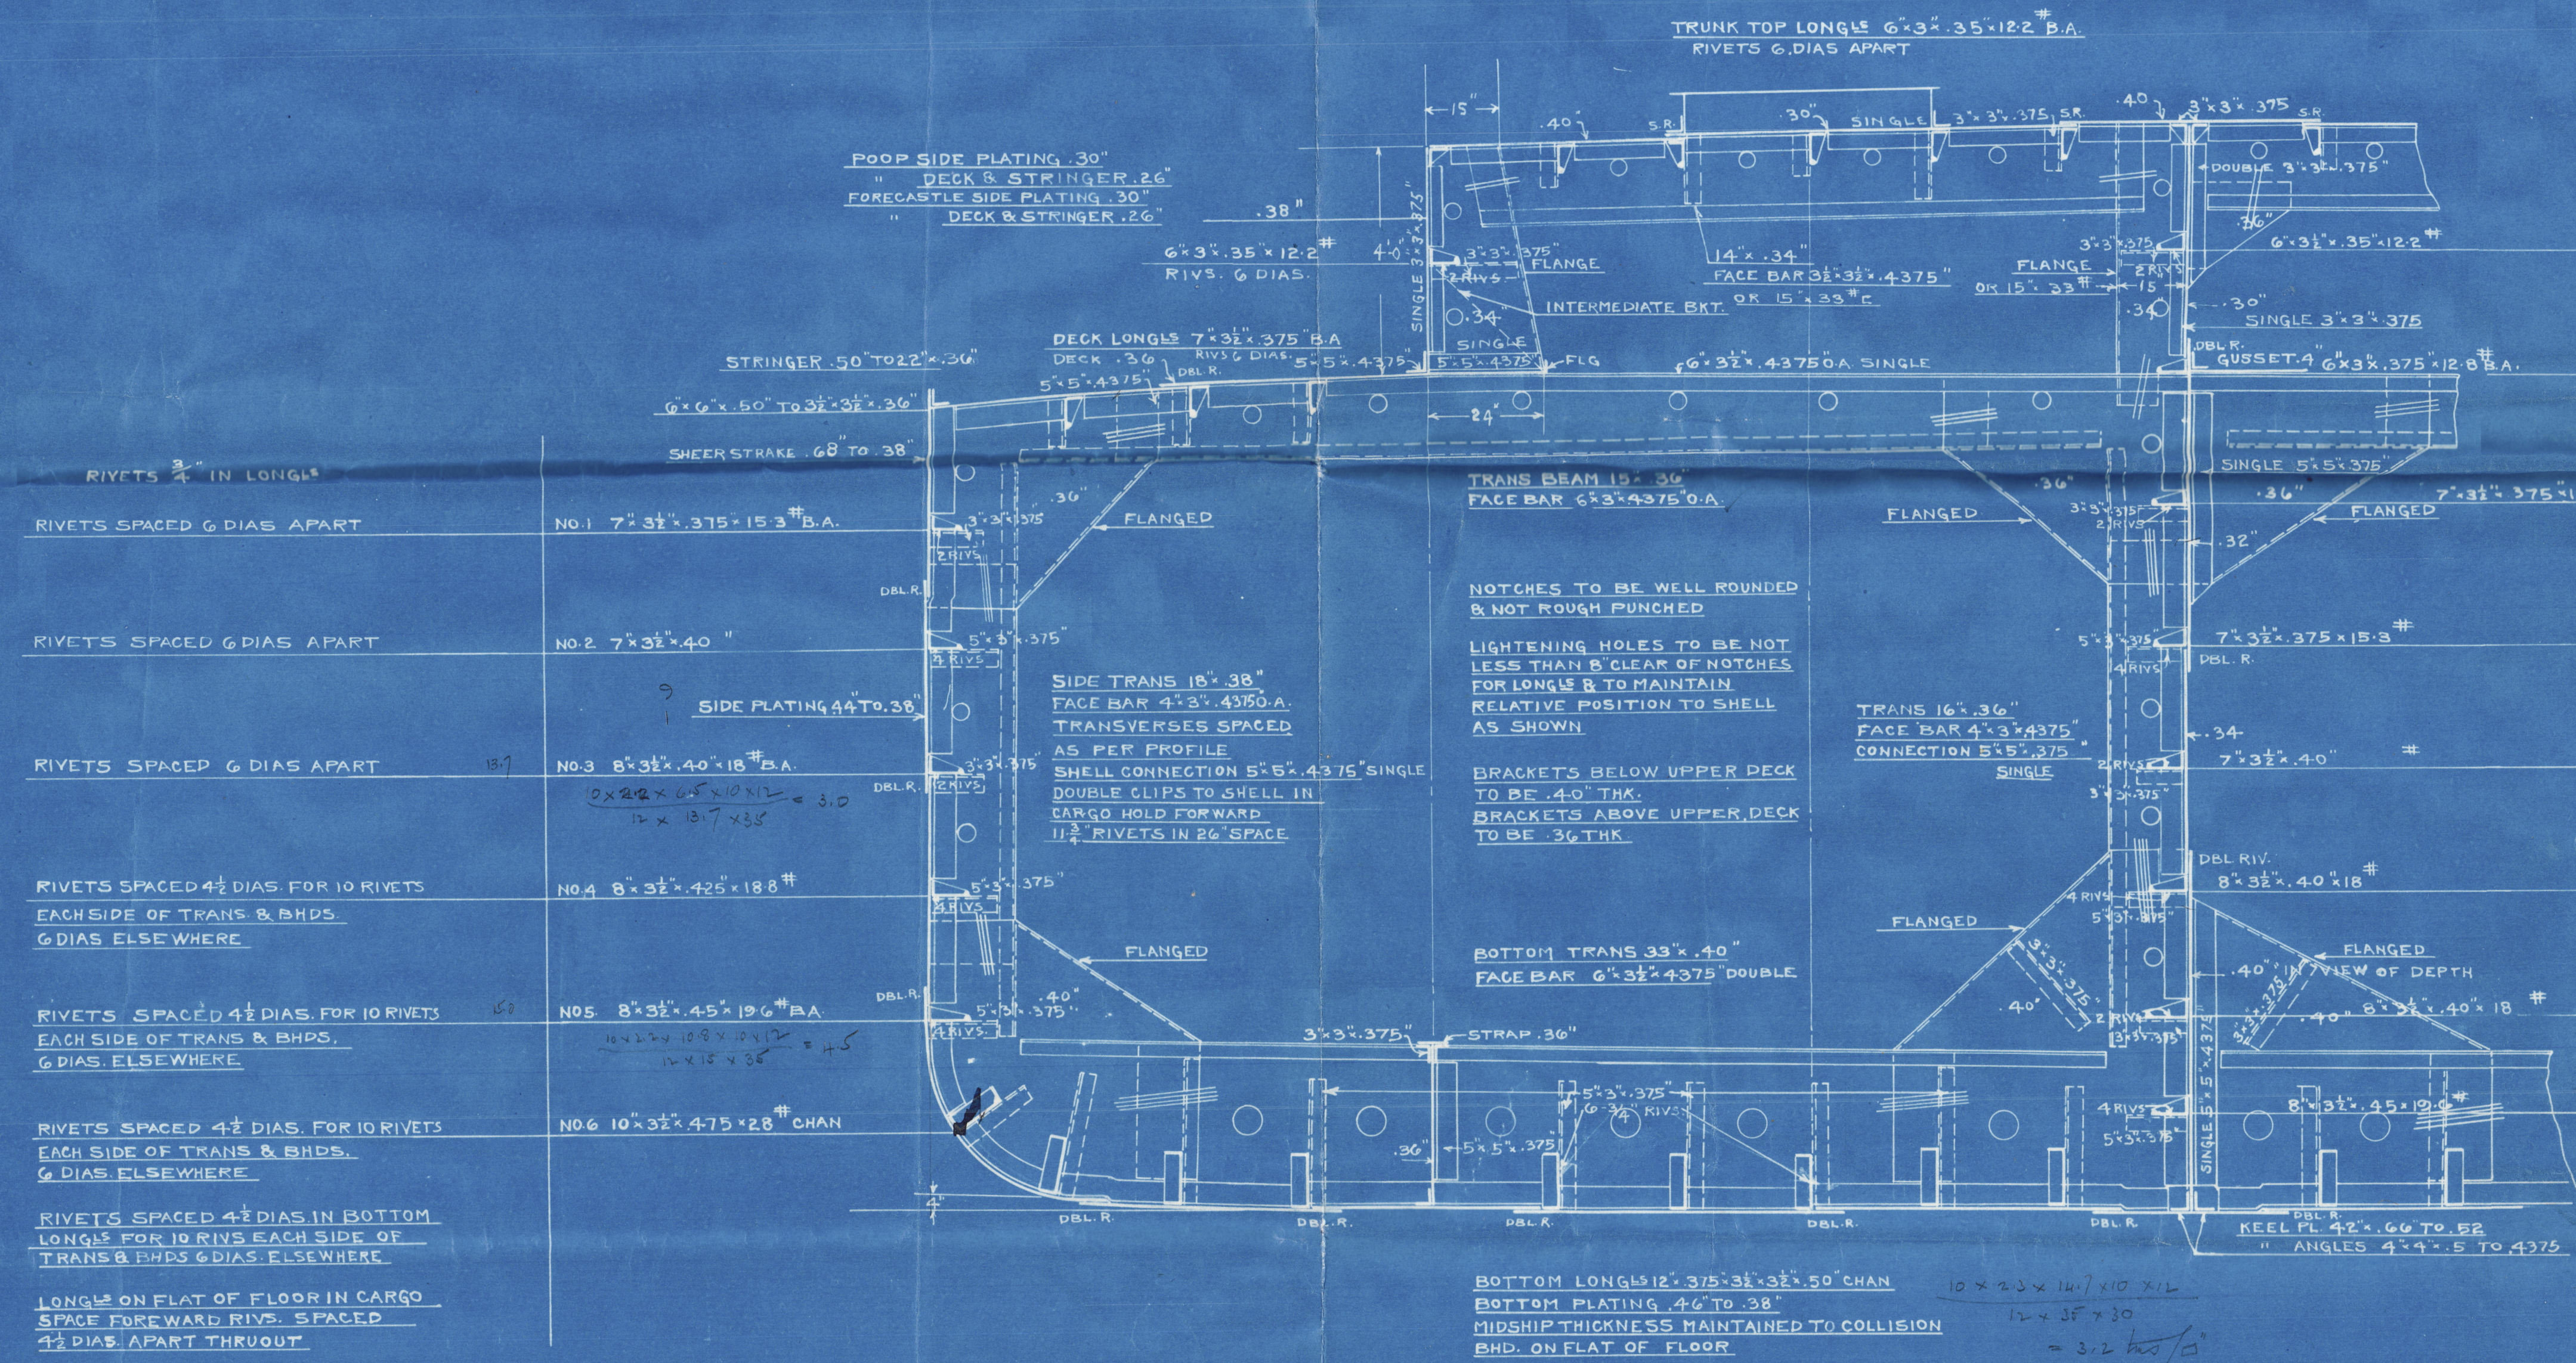

RIVETS 3/4\"/>

RIVETS 6 DIAS. APART

RIVETS 6 DIAS. APART

RIVETS 6 DIAS. APART

RIVETS 6 DIAS. APART

RIVETS 6 DIAS. APART


RIVETS SPACED 4 1/2 DIAS. APART FOR 10 RIVS EACH SIDE OF TRANS & BHD. 6 DIAS. ELSEWHERE

RIVETS SPACED 4 1/2 DIAS. APART FOR 10 RIVS EACH SIDE OF TRANS & BHD. 6 DIAS. ELSEWHERE

RIVETS SPACED 4 1/2 DIAS. APART FOR 10 RIVS EACH SIDE OF TRANS & BHD. 6 DIAS. ELSEWHERE

LLOYDS NUMERALS	
BREADTH MID	44.00
DEPTH MID	14.00
TRANS NO	58
LENGTH	210.00
LONGITUDINAL NO	12180
DEPTH TO LENGTH 15.00	UPPER DK.
" " " 11.66	TRUNK TOP
LETTER EQUIPMENT NO.	12315

TO CLASS 400 A1 LLOYDS SELF PROPELLED BARGE
 CARRYING PETROLEUM IN BULK

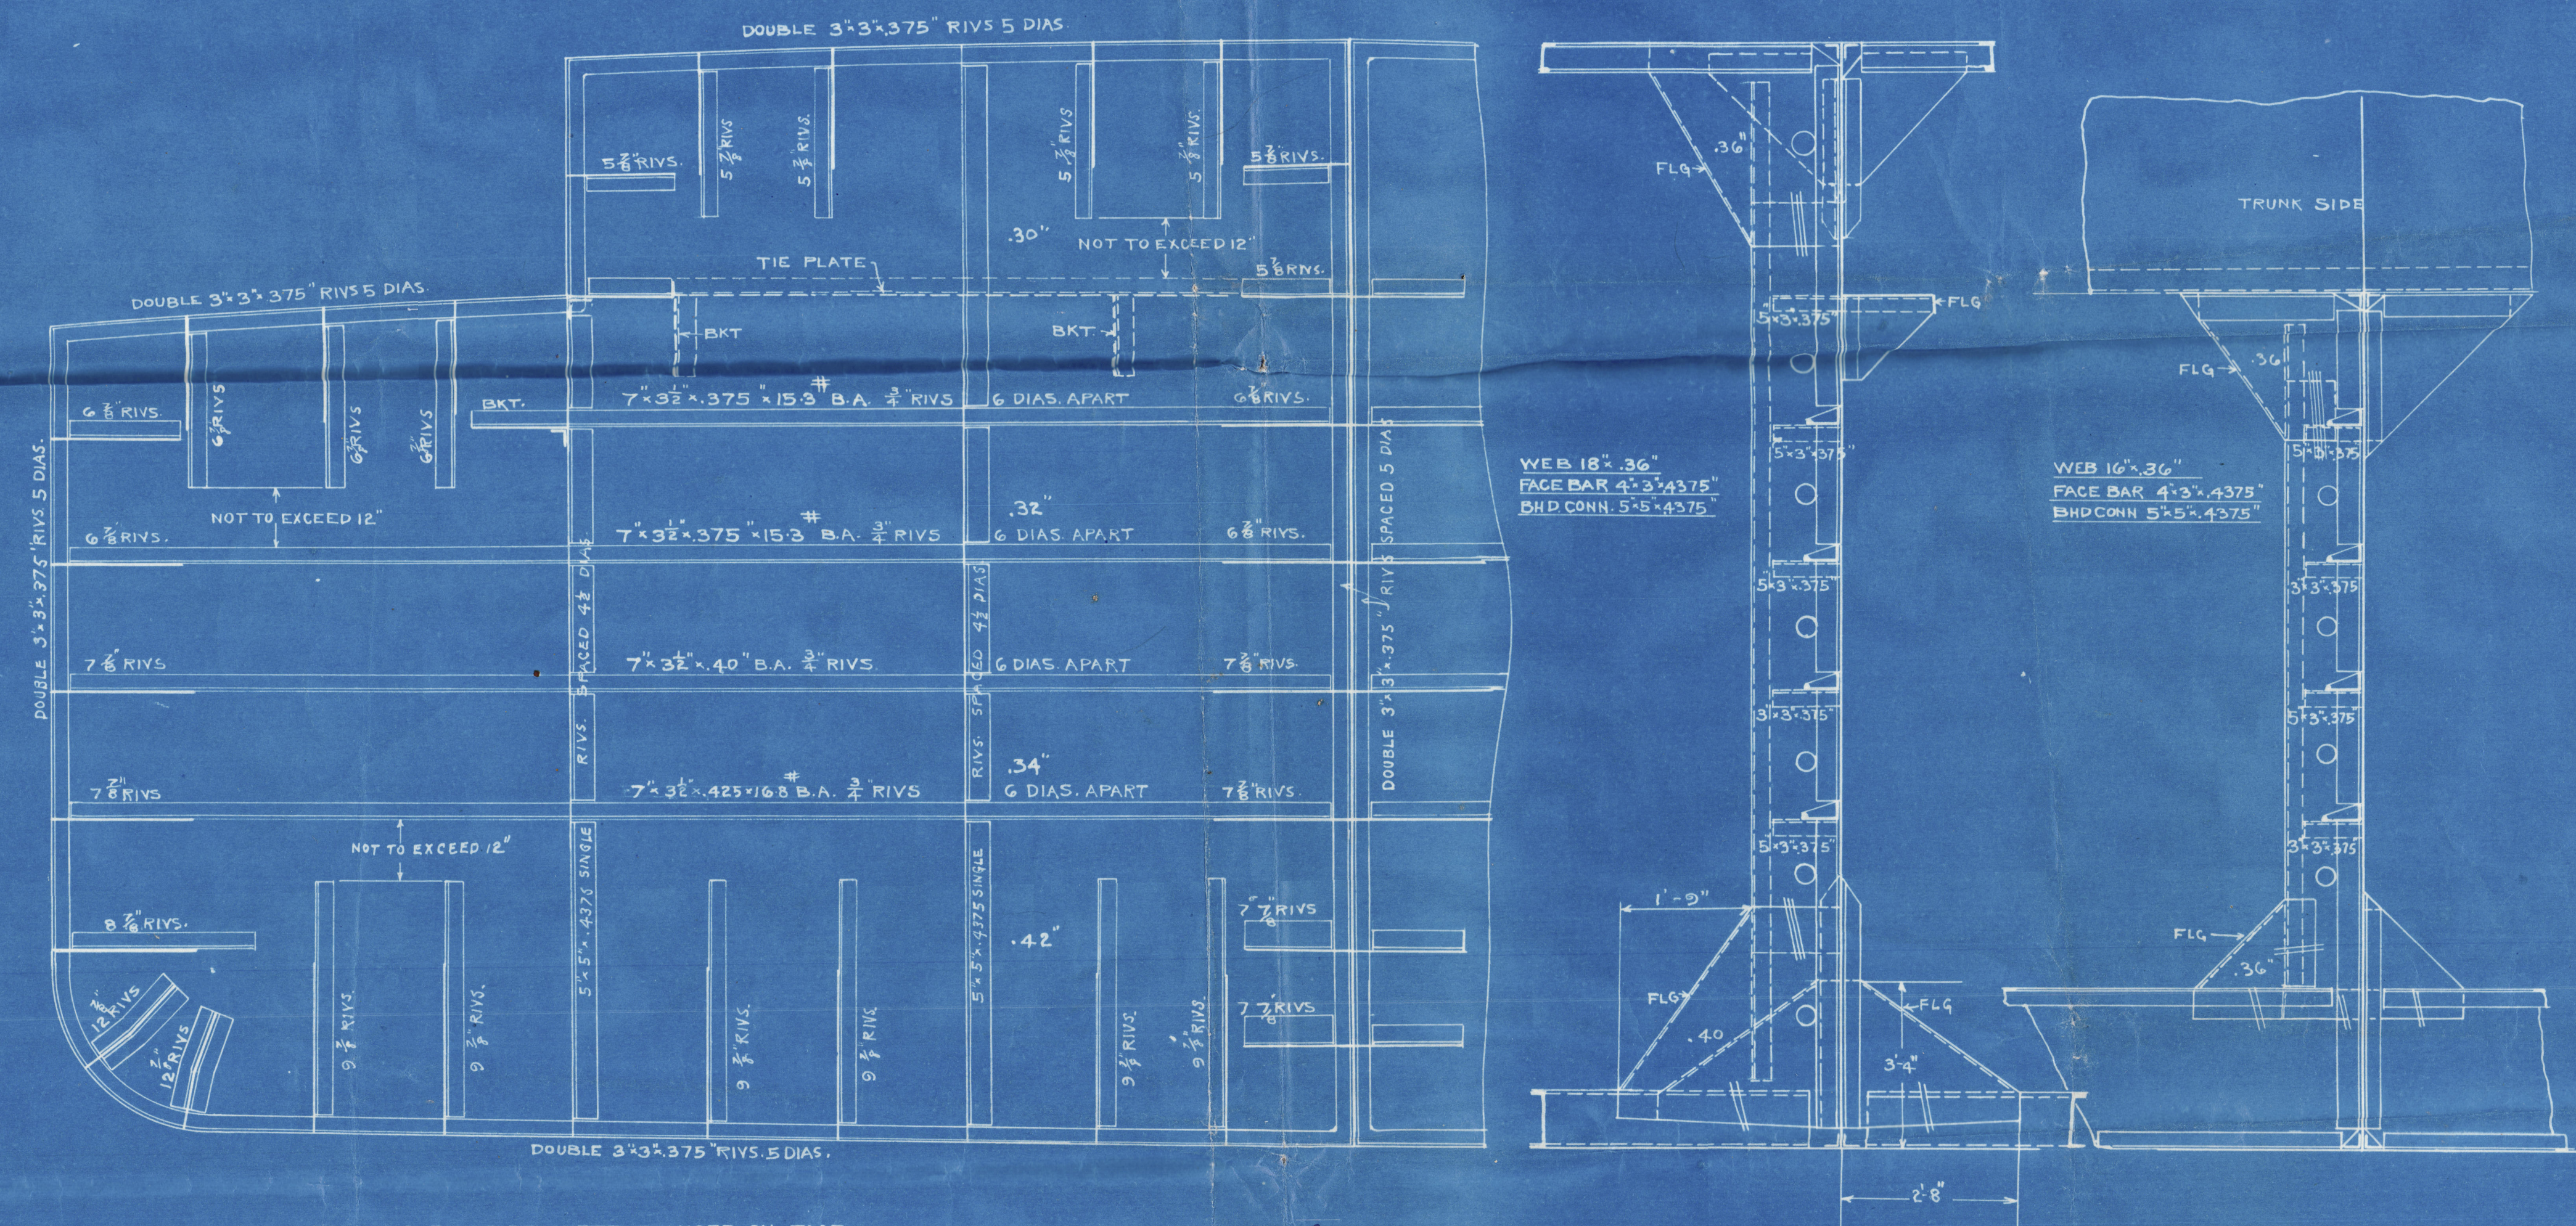

APPROVED
 LLOYDS REGISTER OF SHIPS
 NEW YORK

SELF PROPELLED BULK OIL BARGE
 DIMENSIONS-LENGTH B.P. 210'-0" BREADTH MID 44'-0" DEPTH MID 14'-0"
 MIDSHIP SECTION & OILTIGHT BULKHEAD
 SCALE 1" = 1 FOOT
 ISHERWOOD SYSTEM PATENT


Lodd Shipyard Corporation

Nº 14.

Midships Section

23-8-19.

~~Not worked~~

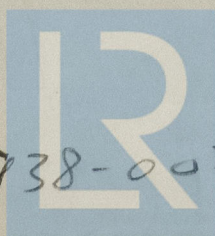

© 2021

007938-007446-0001

Lloyd's Register
Foundation



007938-007446-0001



© 2021
Lloyd's Register
Foundation