
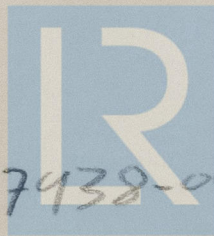
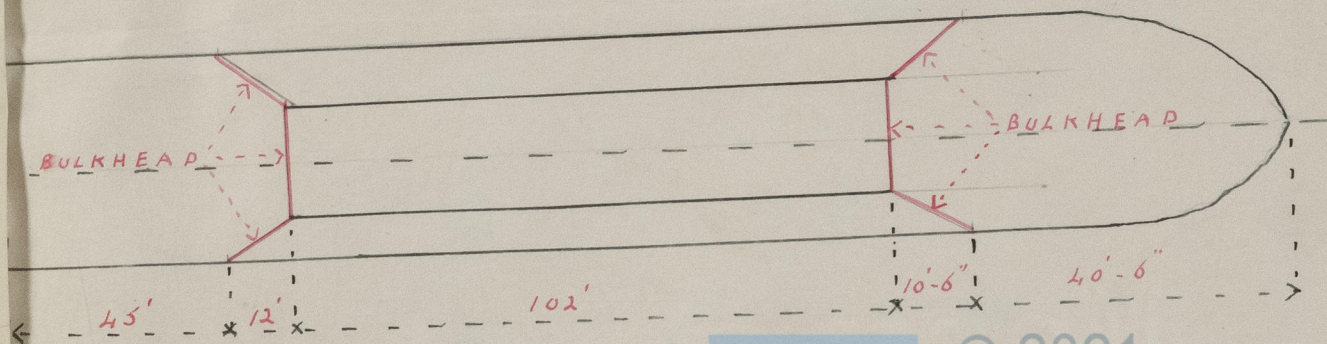


Manuel Rinda. and W. E. Gilbre.

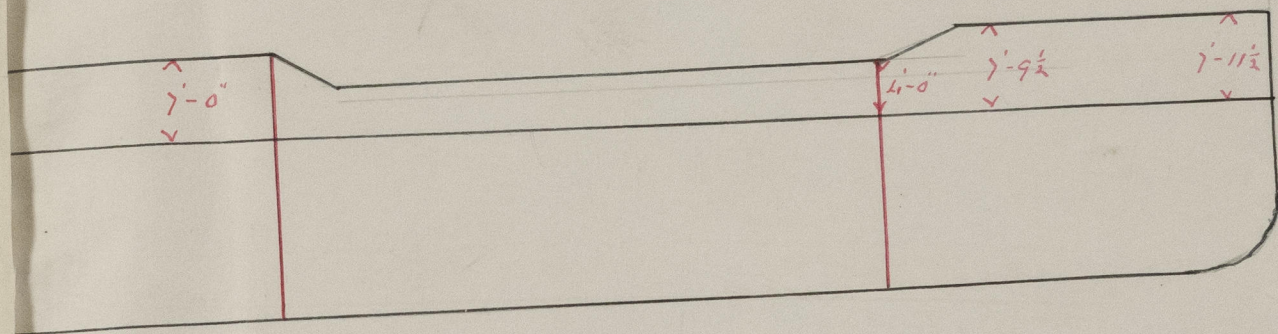

© 2021

Lloyd's Register
Foundation

007938-007946-0019