


9.11.14

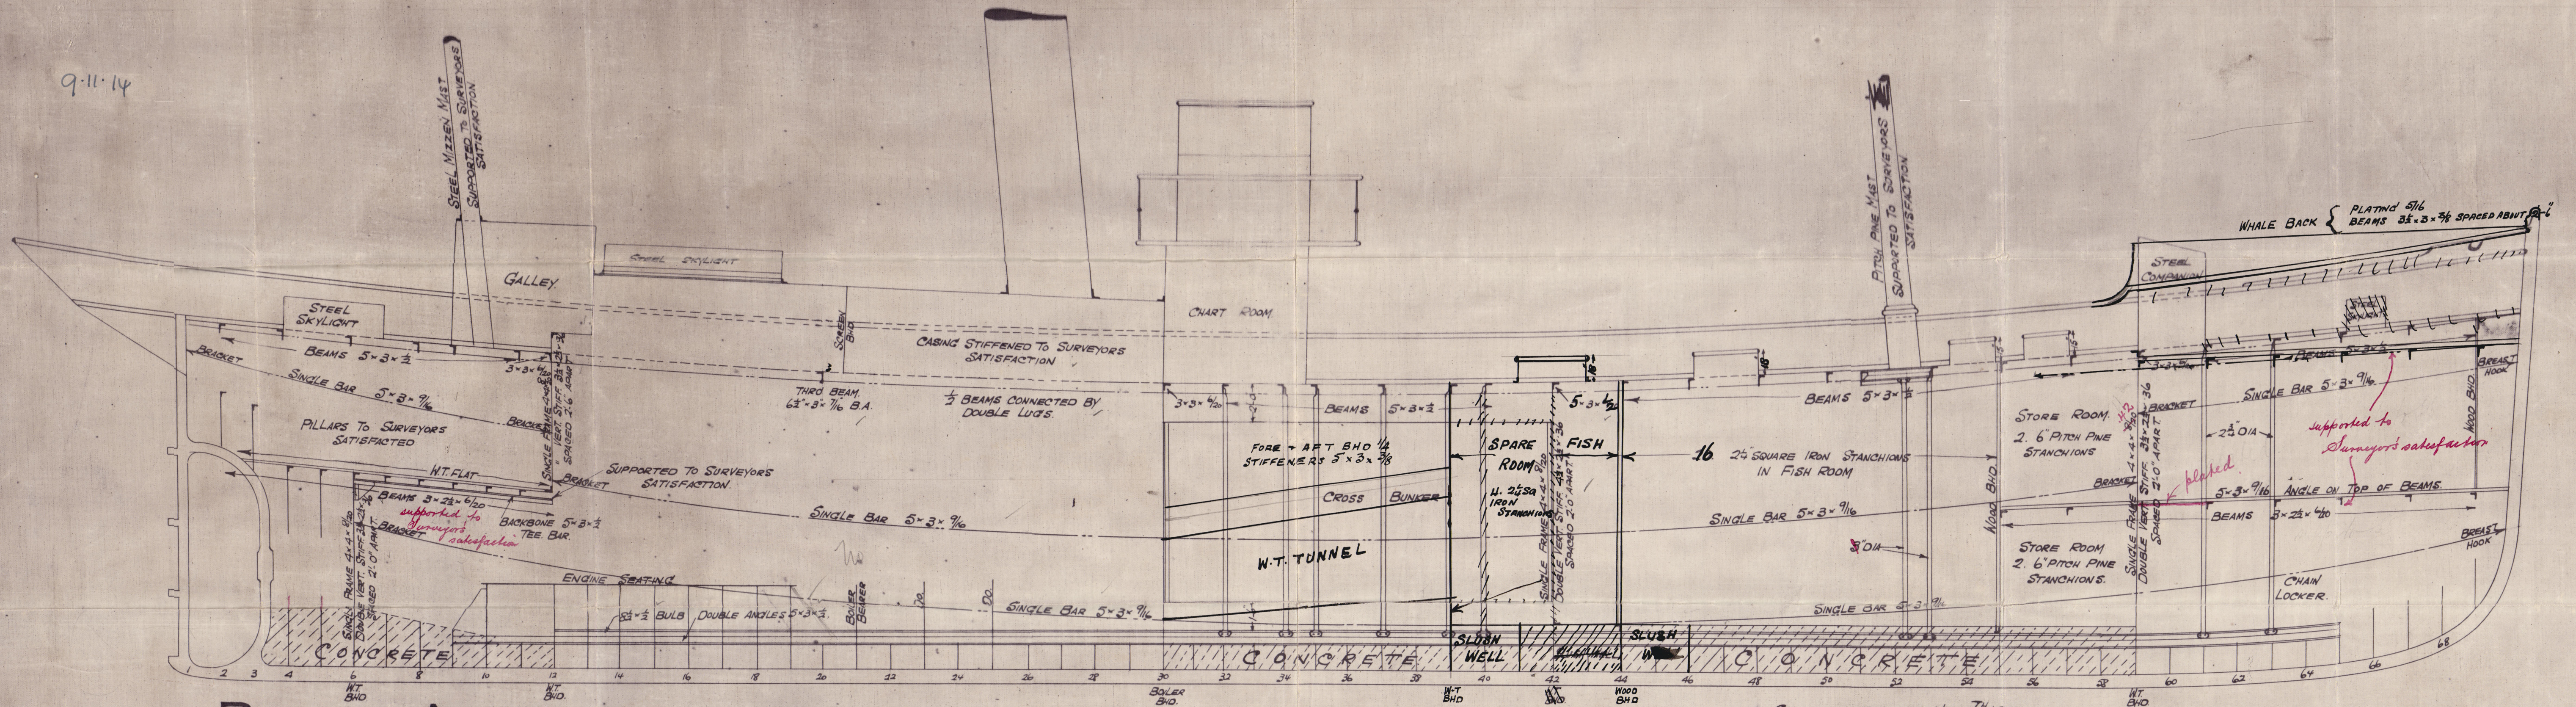


BEAM ARRANGEMENT.

SCALE 1/4" = 1 FOOT

SUBMITTED TO LLOYDS NOV 4TH 1914
APPROVED BY " NOV 9TH "

N^{OS} 316. & 316A.

COOK, WELTON & GEMMELL LTD
SHIPBUILDERS
BEVERLEY.

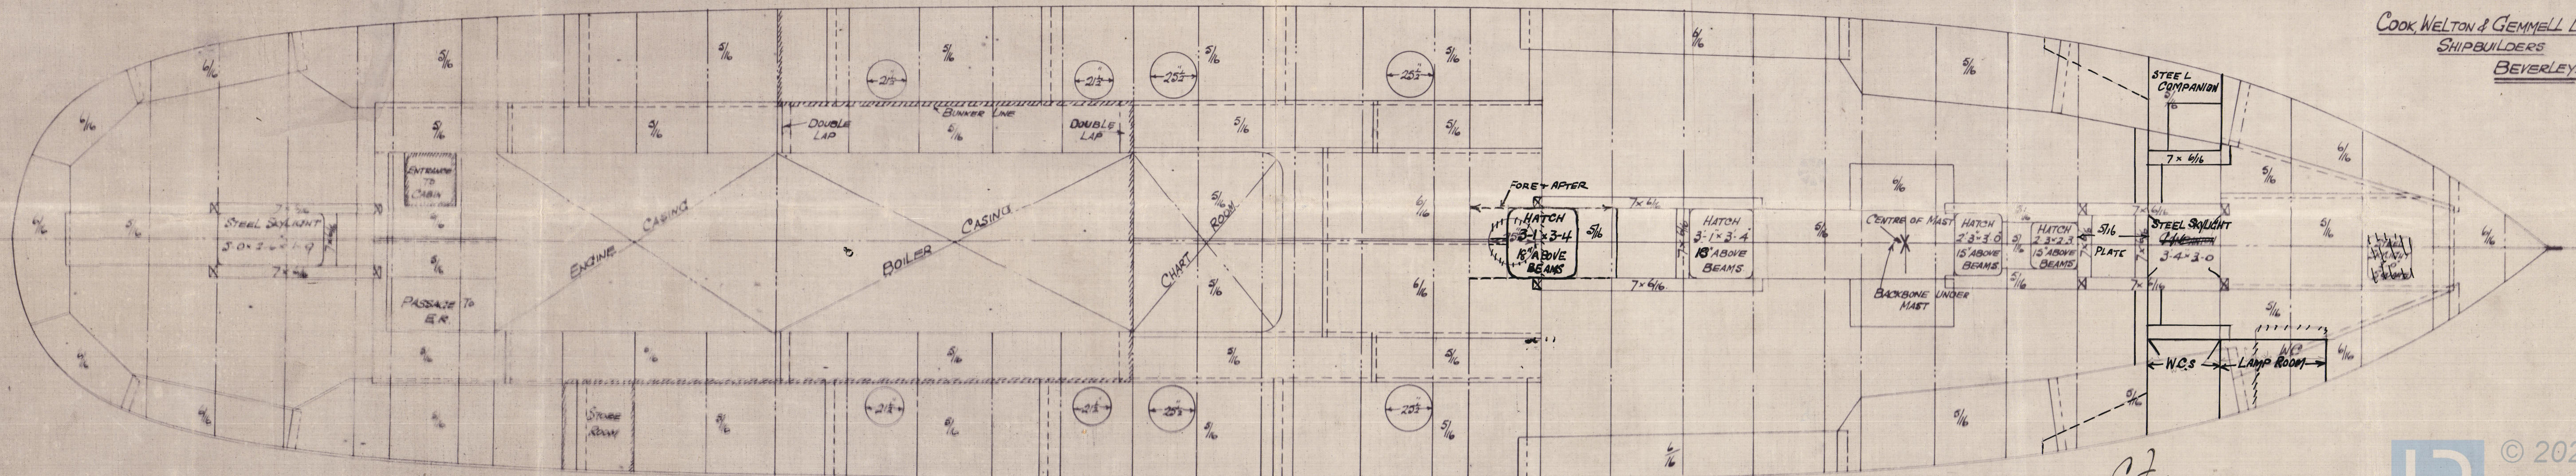


C.F.
9.11.14


No 5 316 & 316 A.

PROFILE + DECK.

COOK WELTON & GEMMELL

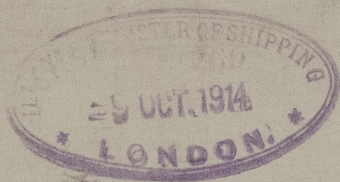

S.L. "Commander Boyle" Hull Rpts
No 28771

"Commander Naomith" Hull Report
No. 28796 



© 2020

Lloyd's Register
Foundation