

MIDSHIP SECTION.

N^{OS} 316. & 316 A

SCALE $\frac{1}{2}'' = 1 \text{ FOOT}$

DIMENSIONS: - 115' 4" BP x 22' 6" EX x 13' 8" MLD.

CLASSED 100A 1

STEEL

STEAM TRAWLER.

EQUIPMENT		
1 ANCHOR	5 1/2" CNT.	EX STOCK
1 "	4 1/2 "	" "
1 "	2 1/2 "	" "
90 FTH ³	1" SHORT LINK CHAIN	"
60 "	6" HANSER	"
60 "	4 1/2" WARP	"


$L = 115.33$

$B + D = 36.03$ TRANSVERSE NO

$d = 12.33$



$L \times (B + D) = 4155.34$ LONGIT[±] NO

$\frac{L}{D} = 8.44$

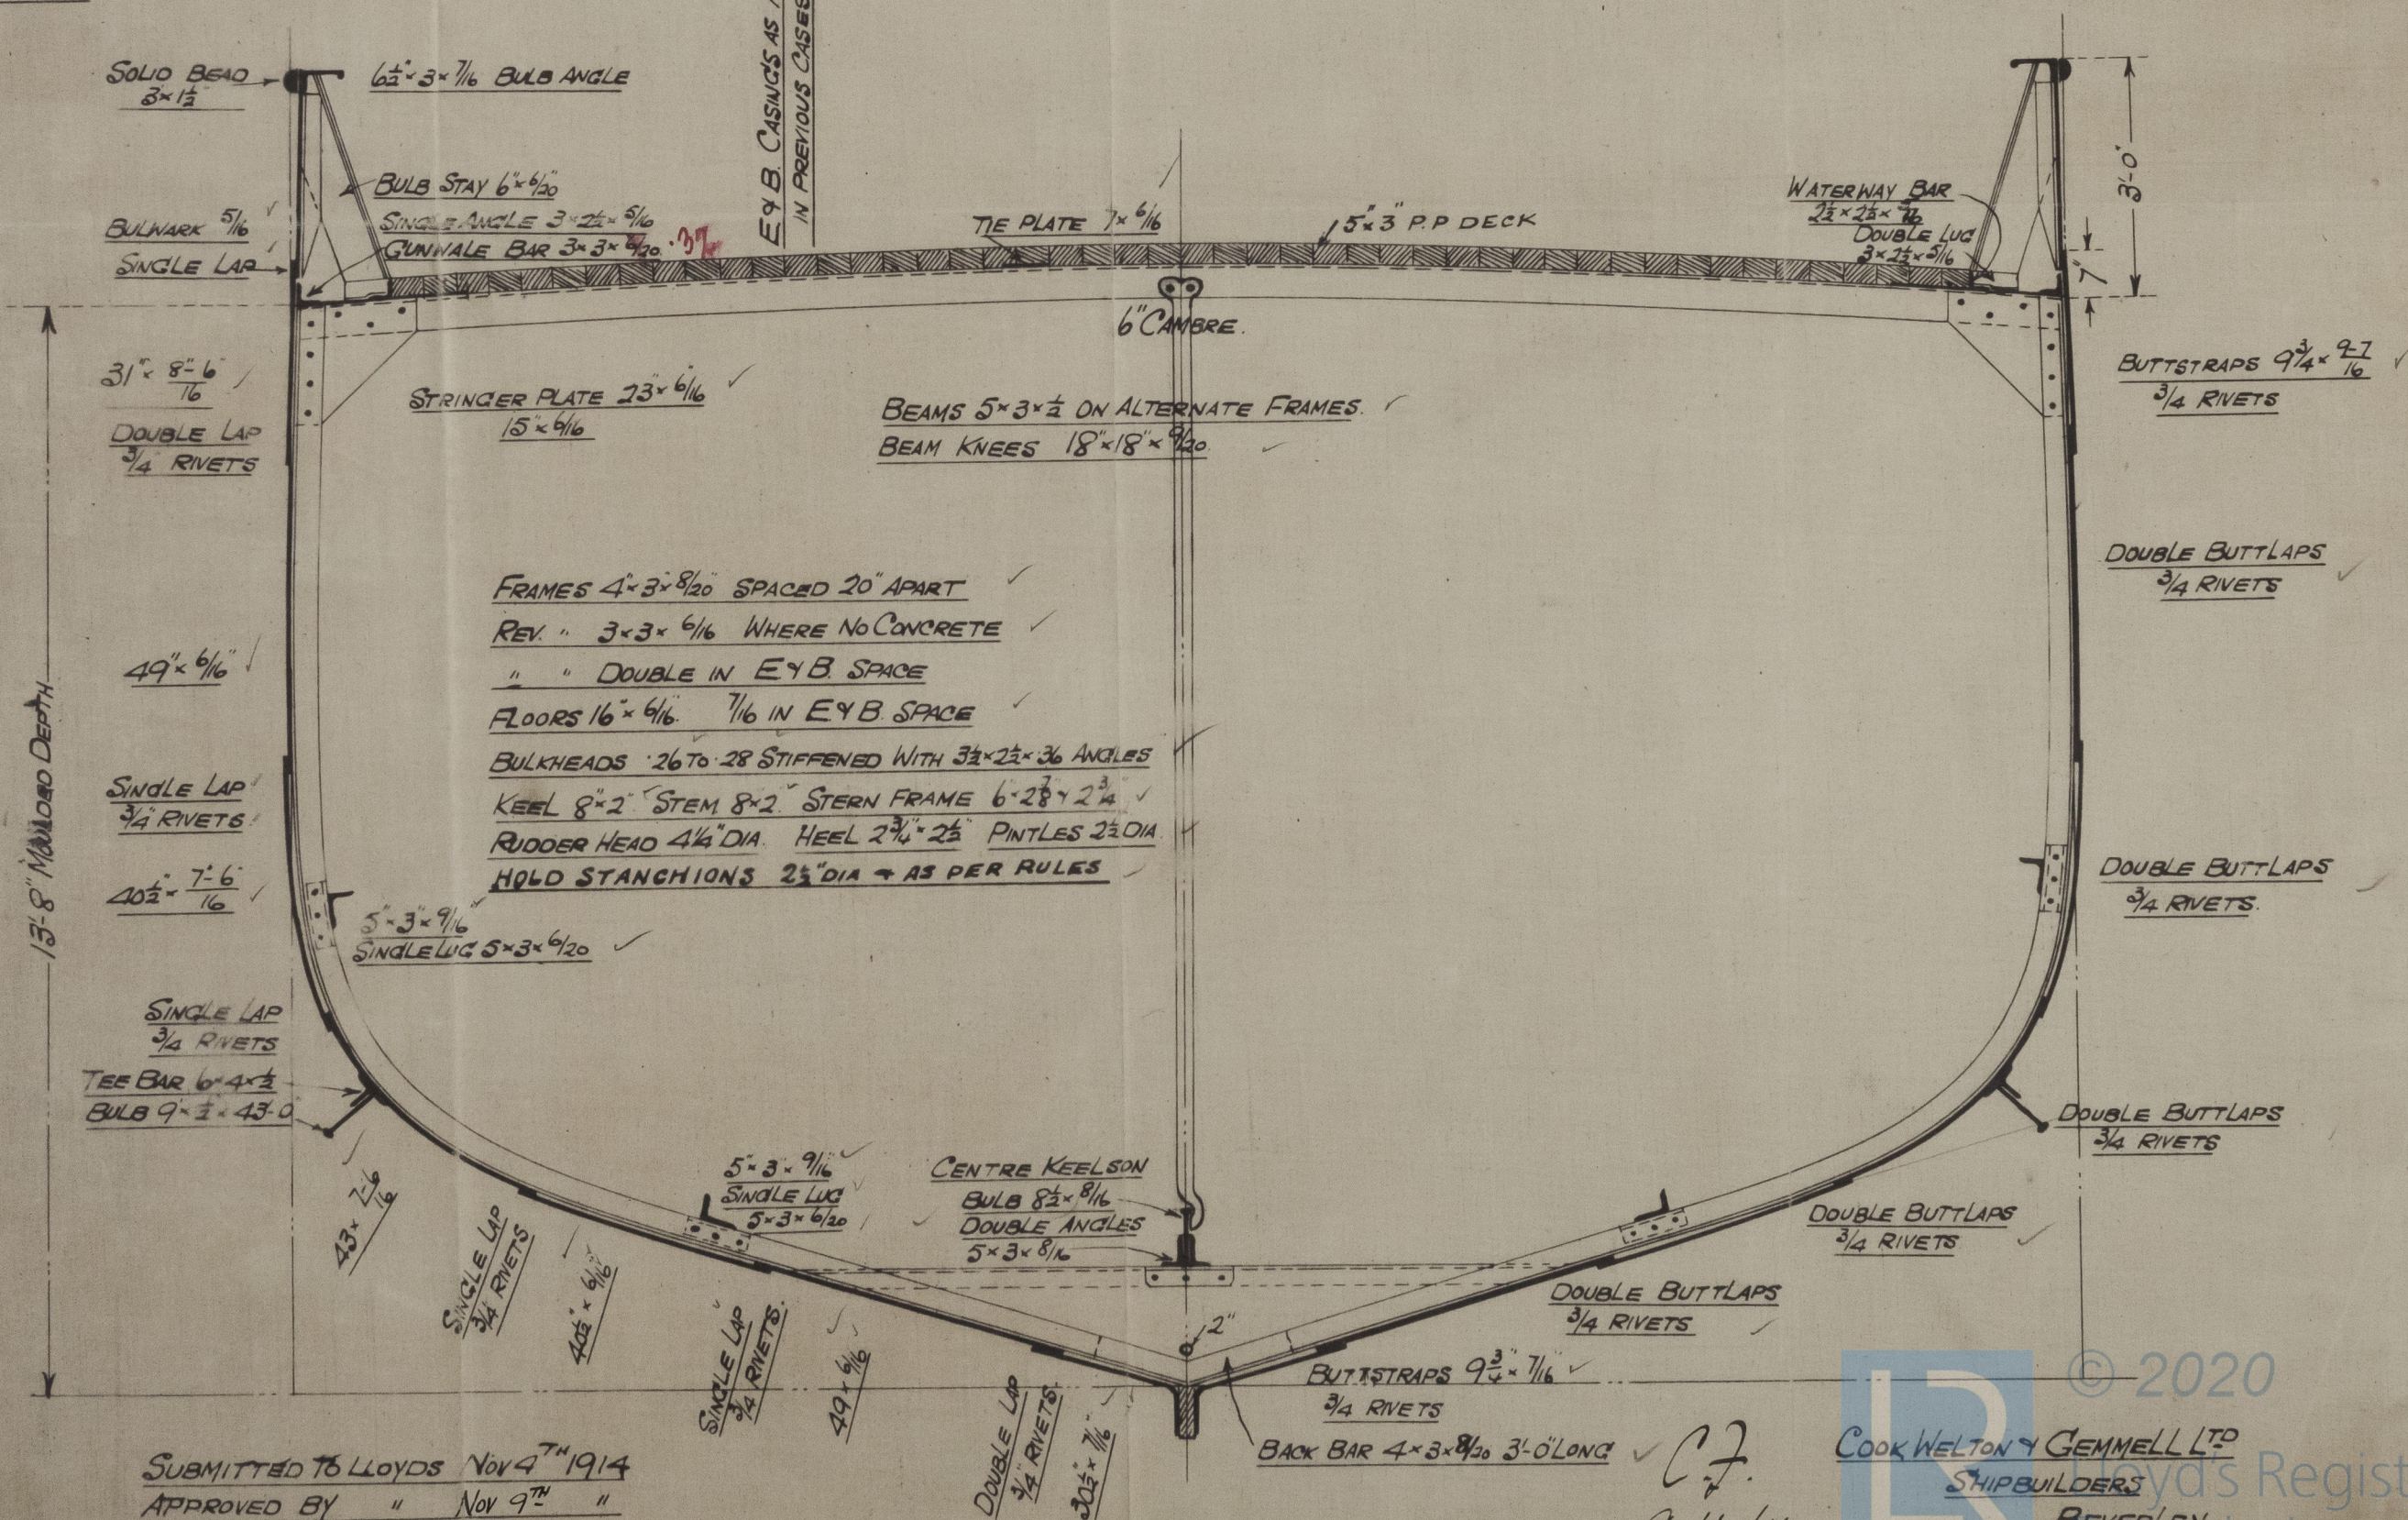

SUBMITTED TO LLOYDS NOV 4TH 1914
APPROVED BY " NOV 9TH "


© 2020
COOK WELTON & GEMMELL LTD
SHIPBUILDERS
BEVERLEY
Lloyd's Register
Foundation

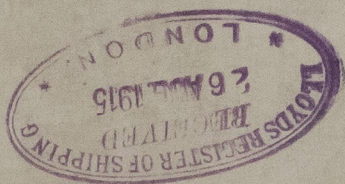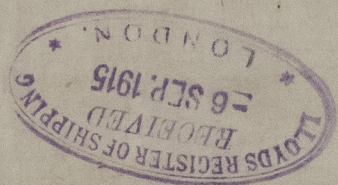


MIDSHIP SECTION

N^{os} 316 & 316 A.

COOK WELTON & GEMMELL

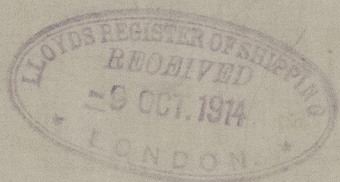

J. J. "Commander Boyle" Hull Rep^t.
No 28771
" " "Commander Cassell" Hull Rep^t 
No 28796



© 2020

Lloyd's Register
Foundation

007947-007957-0059