


N^{OS} 316.

SUBMITTED TO LLOYDS JUN 25th 1914
 APPROVED BY " "
 COOK, WELTON & GEMMELL LTD
 SHIPBUILDERS
 BEVERLEY

30.6.14.

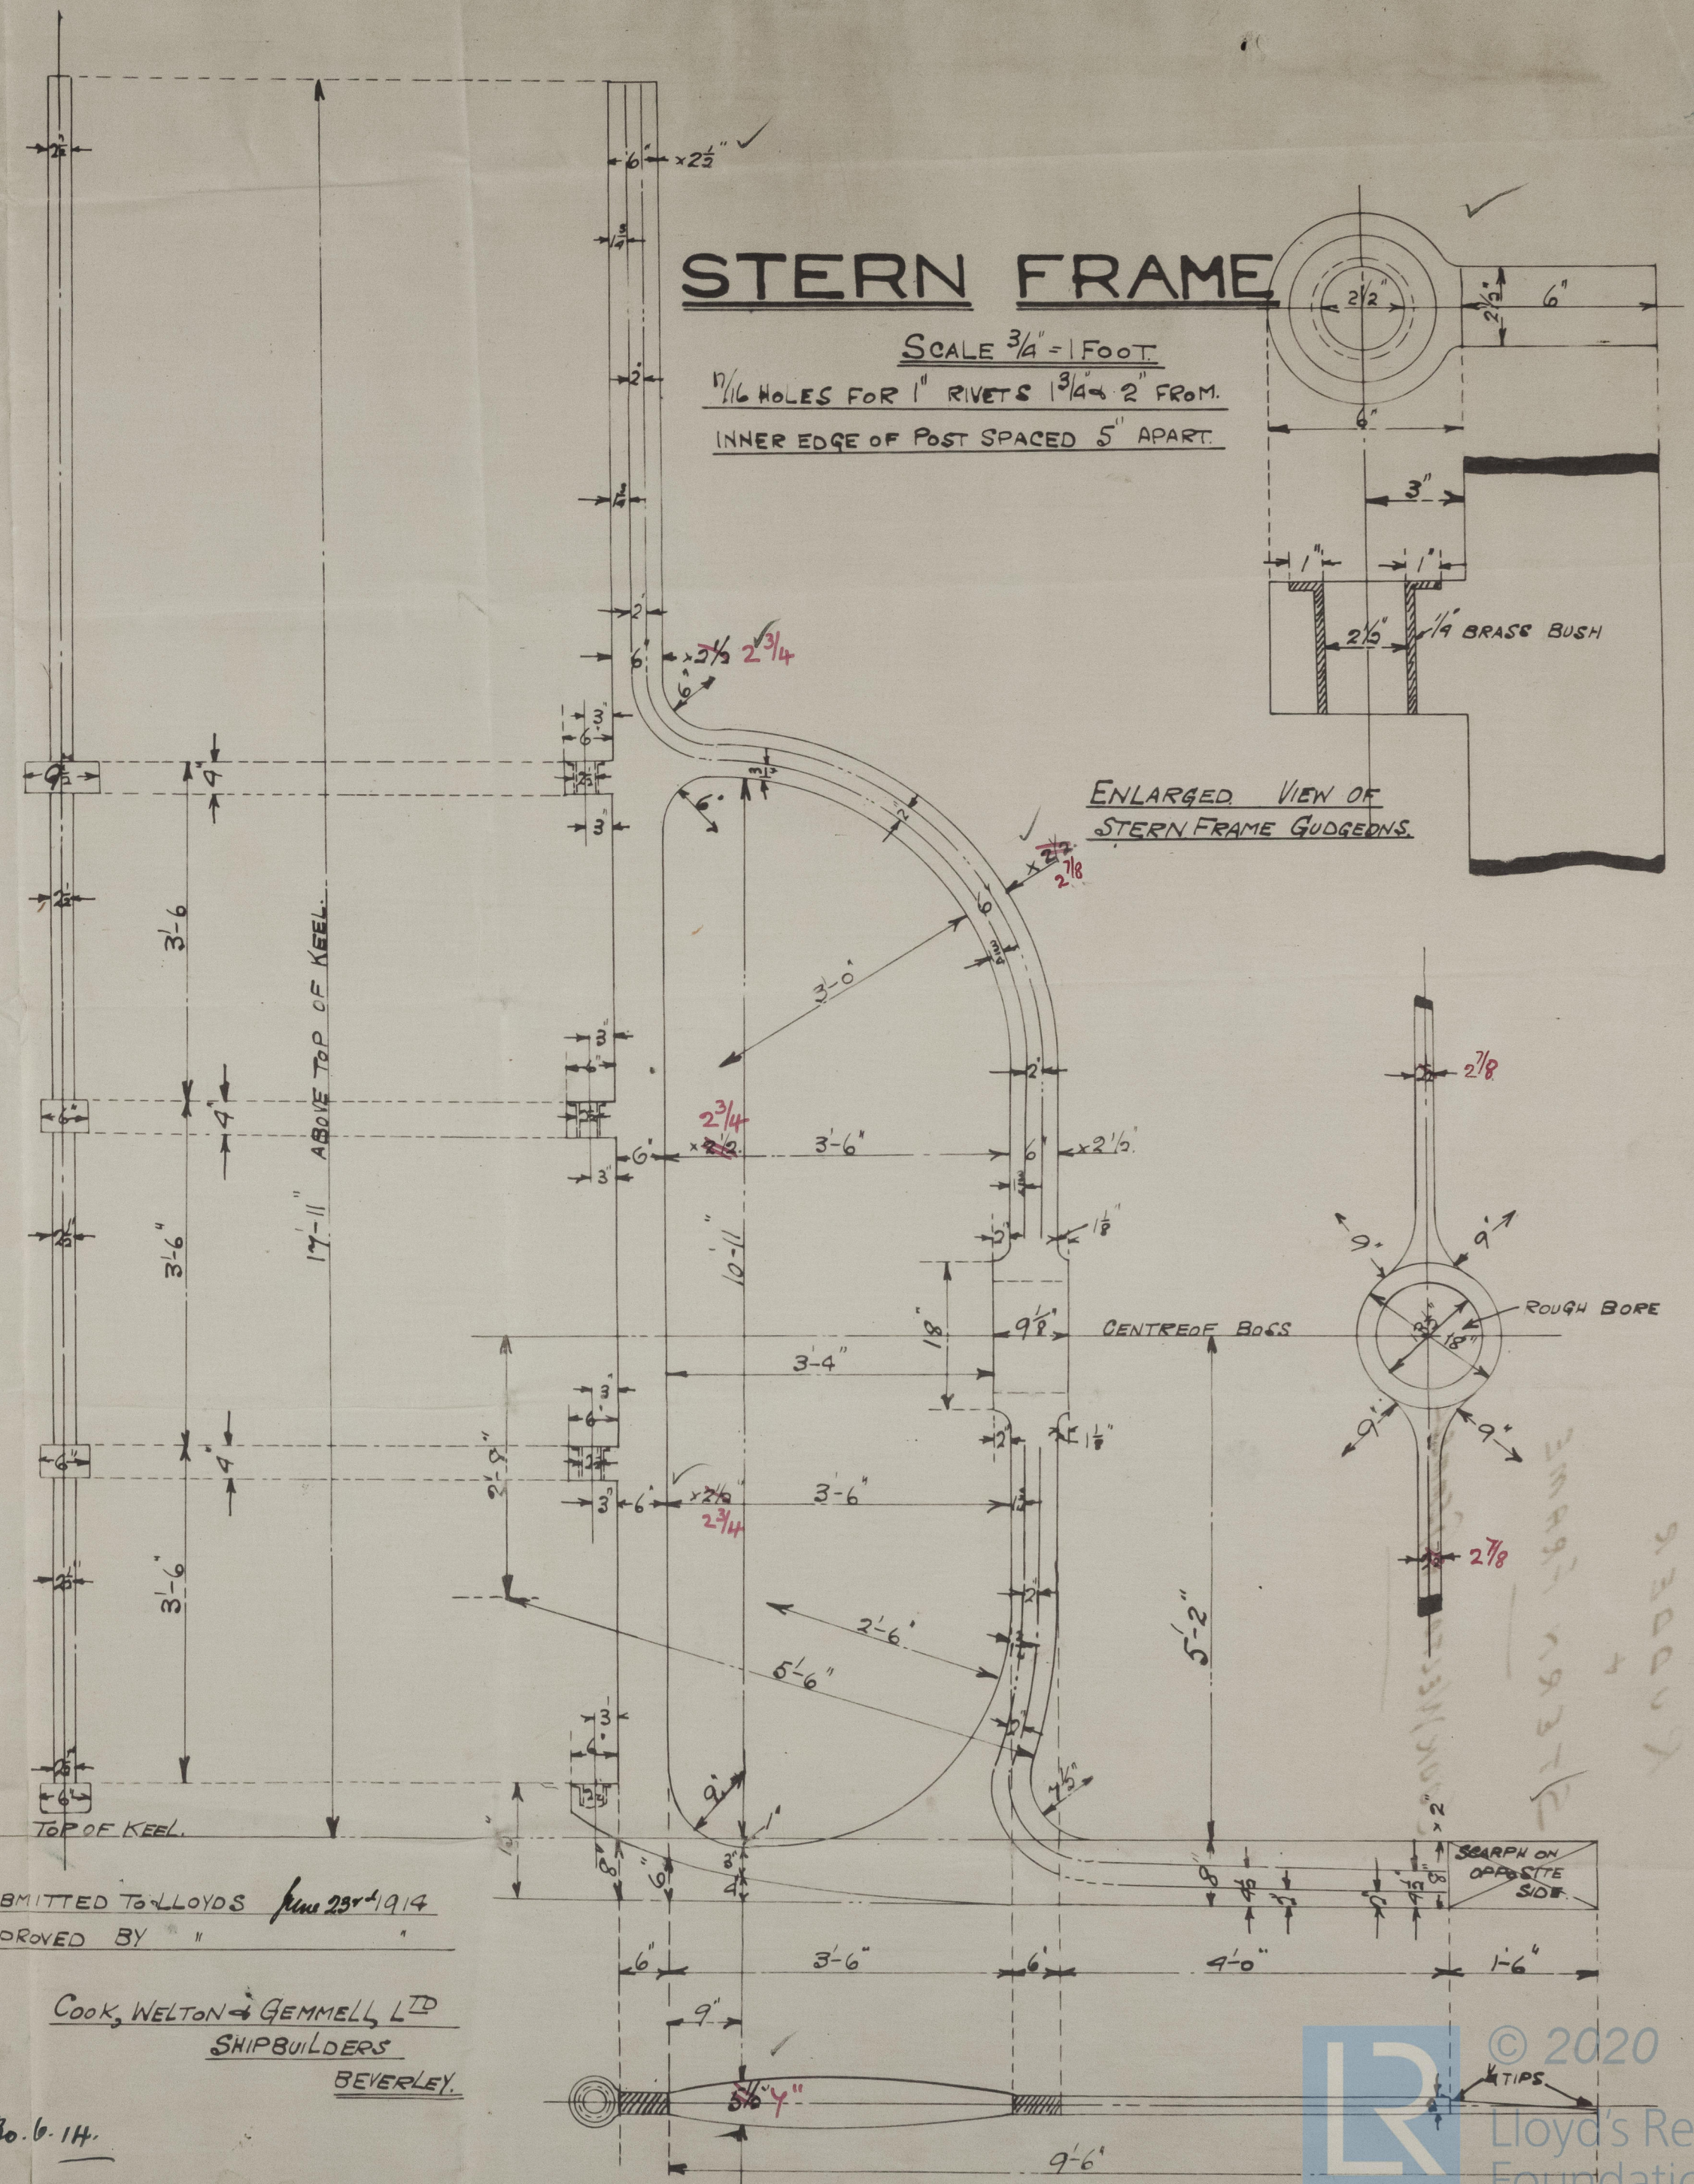

N^{os} 316-316A.

RUDDER



+

STERN FRAME

COOK WELTON + GEMMELL

H. Commander Boyle "Hull"
Report No 28771

" " Commander Woomuth
Hull Report No 28796

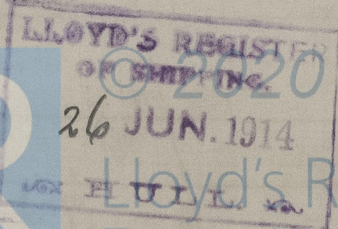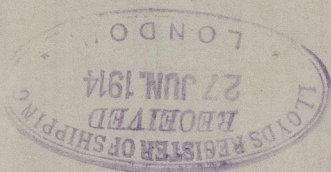

© 2020

26 JUN. 1914

Lloyd's Register
Foundation

007947-007957-0060