


# PLAN OF STERNPOST.

N<sup>OS</sup> 371 & 2, S.S.

SCALE  $\frac{1}{2}$ " = ONE FOOT

STERNPOST, STEEL CASTING.

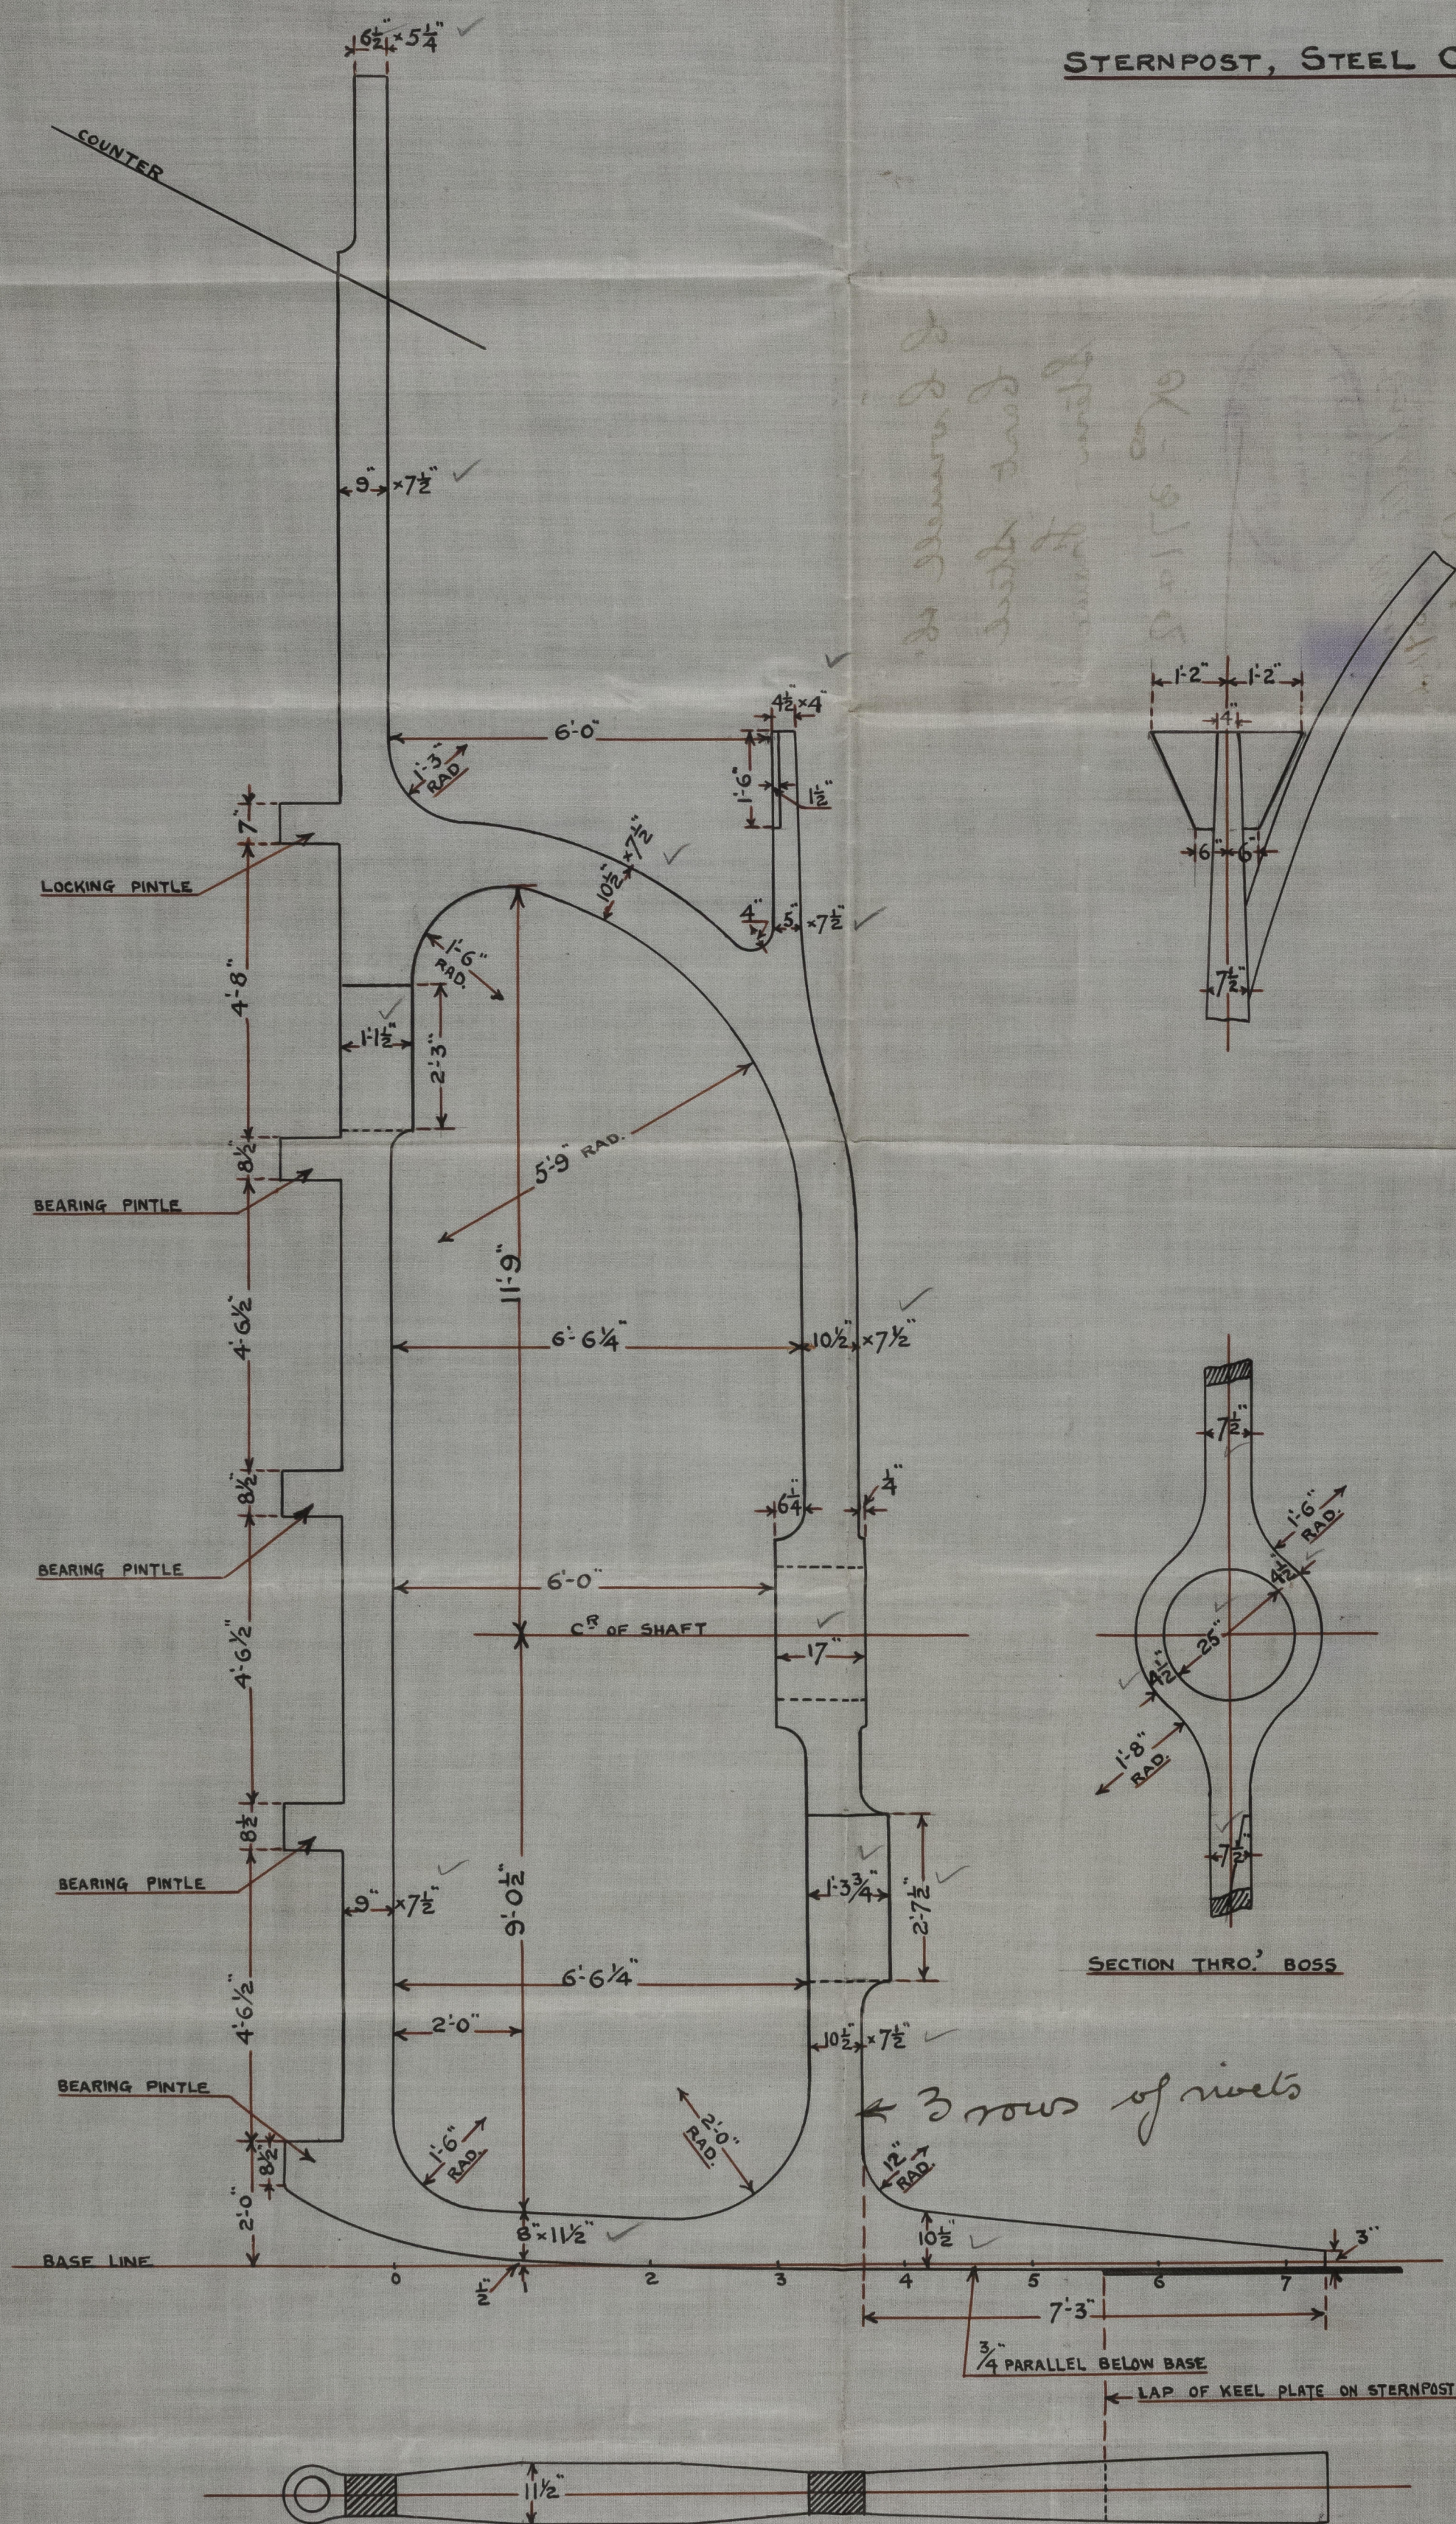

16-3-16

© 2020

Lloyd's Register Foundation

007947-007957-0069



b b orwell sb.  
Cast Steel  
Stem Frame

N<sup>o</sup> - 37142



W. Bakatu Warr  
GLASGOW REPORT No 37146

J. S. Glenhyon

GLASGOW REPORT No 37375

J. S. Glenlee

© 2020

Lloyd's Register  
Foundation

007947-007957-0069