
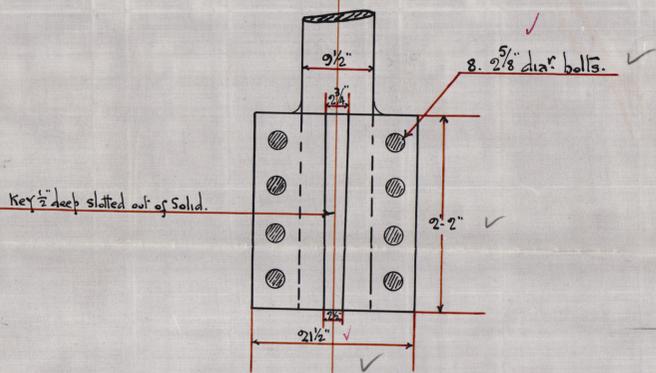



10.3.15

• COUPLING AT HEAD OF MAINPIECE •

Scale 1" = 1 Foot.
LOOKING FOR

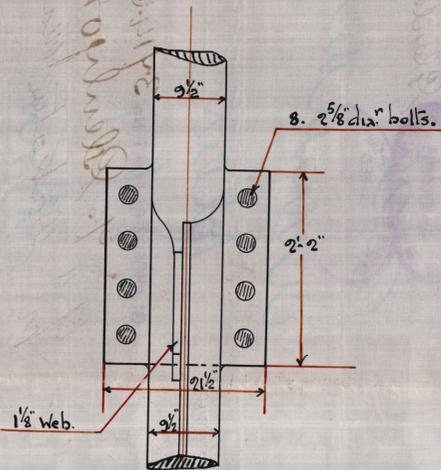

• FACE OF COUPLING ON RUDDER STOCK •
Scale 1" = 1 Foot.

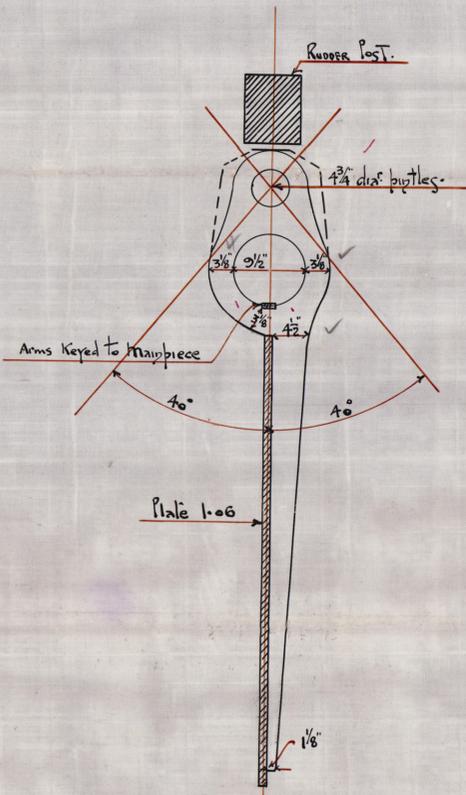

• SKETCH OF RUDDER ARMS •
Scale 1" = 1 Foot.

• STERNPOST & RUDDER •

— Nos 371 & 2.S.S. —


Scale 1/2" = one foot.

Rule Dimensions: 399.2' x 52.9 1/2' x 29.7 1/2'

Sternpost of Forged Iron: —

Speed - 10 1/4 knots. Plating No 32900.

430

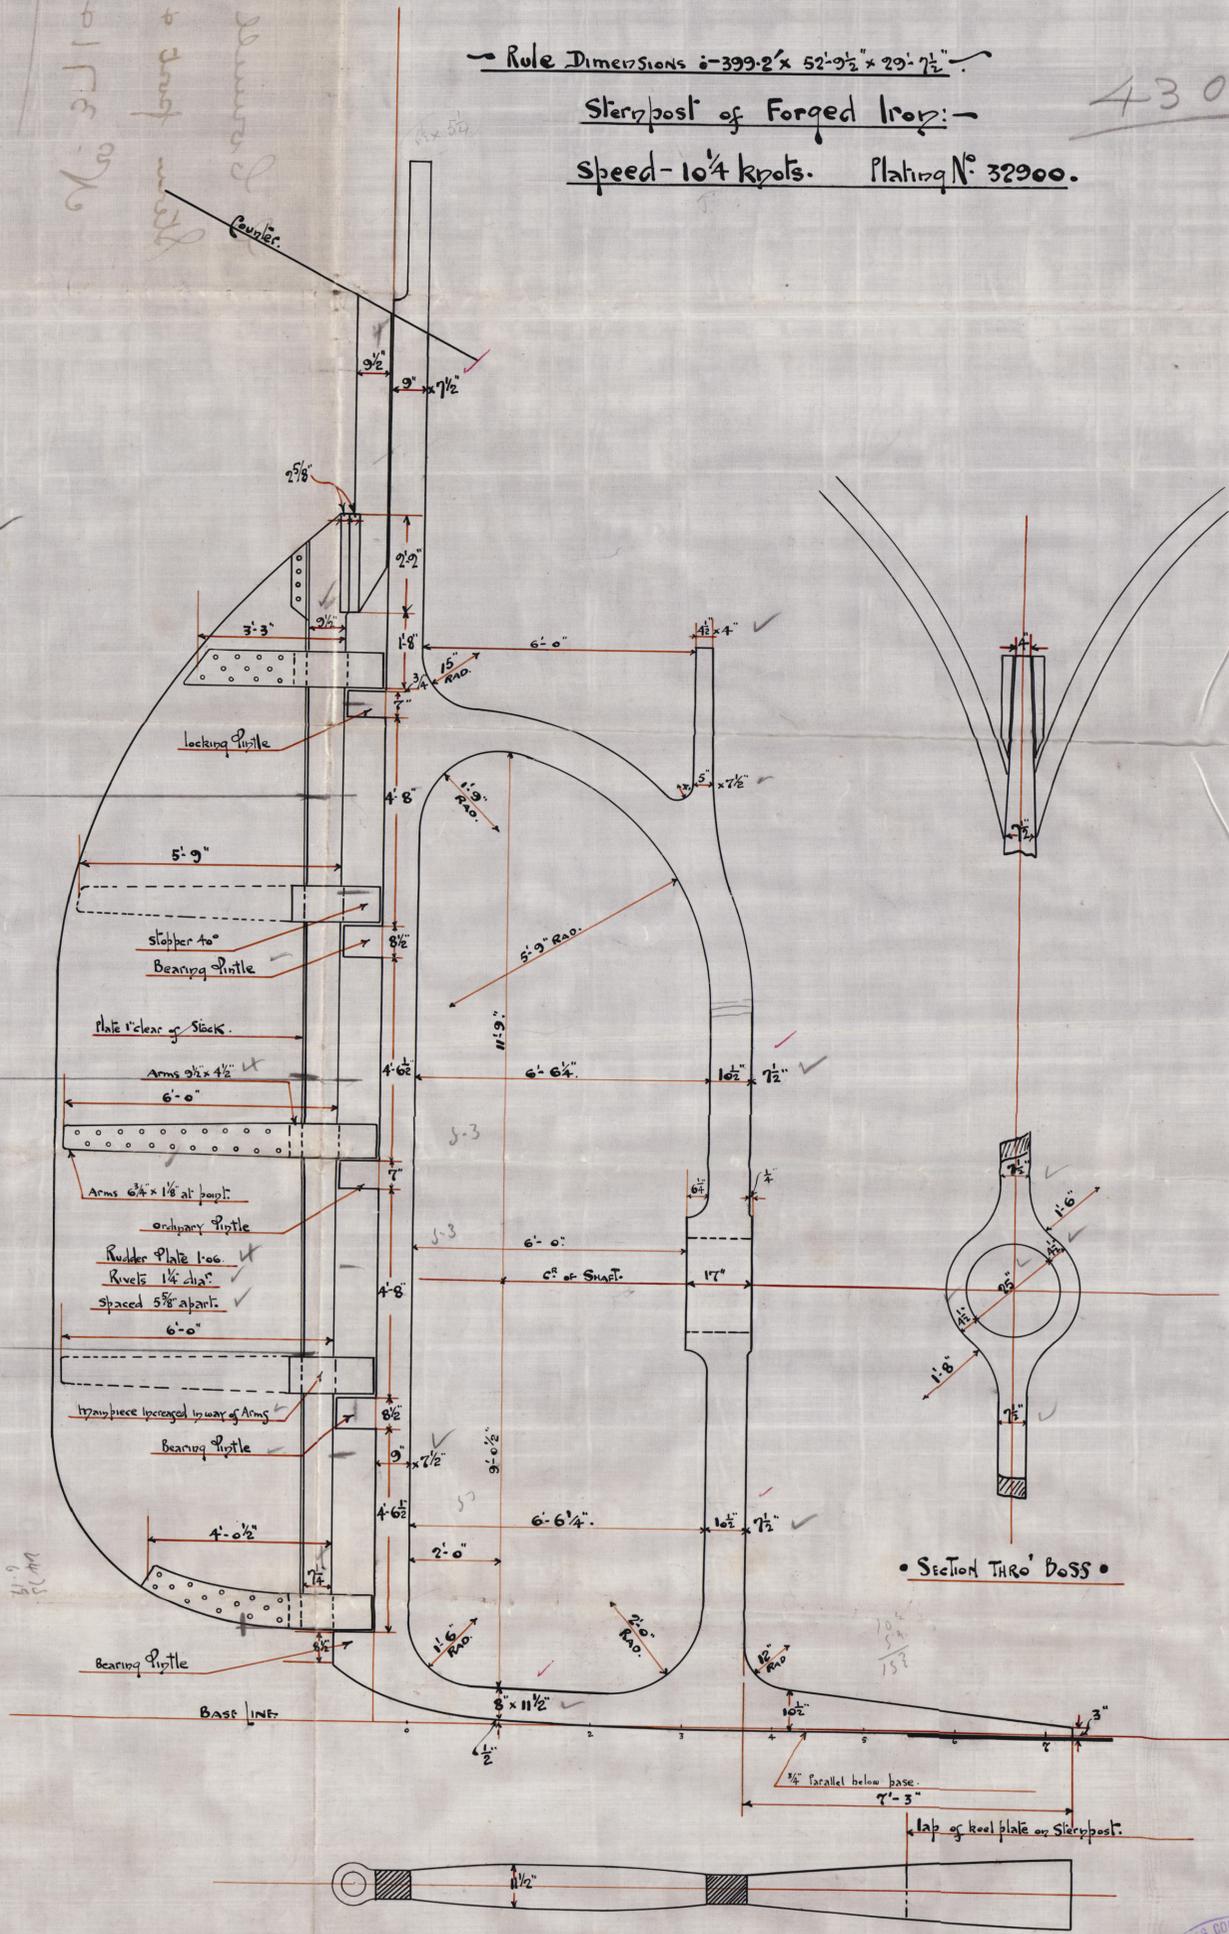


• SECTION THRO' BOSS •

for 10.3.15


C Coumell & Co
Stem post & Rudder
No. 37142

37375

Glenlee.

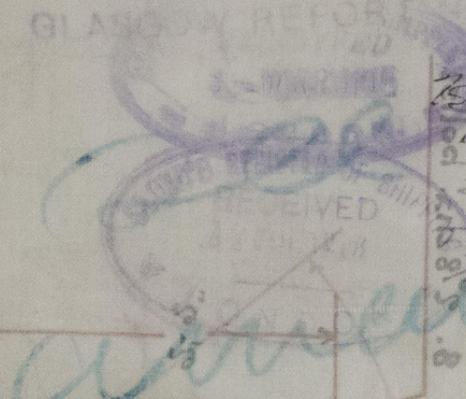

Handwritten blue ink scribbles and lines.

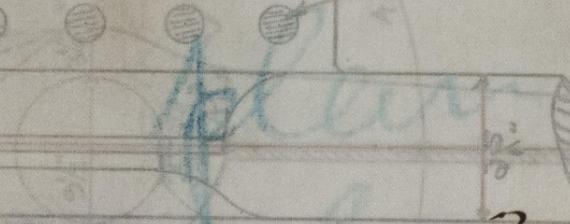

GLASGOW REPORT No. 37146

Glenlyon


M A
M

Handwritten blue ink scribbles and lines.



© 2020

Lloyd's Register
Foundation

007947-007957-0079