


Hwa Loong
s/s Mirani

Disclass 426

(Grange & Co 10415)

Ship Section as built

GLASGOW REPORT No. 47865

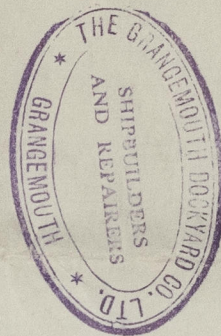

007958-007966-0035



© 2020

Lloyd's Register
Foundation



007958-007966-0035



© 2020

Lloyd's Register
Foundation