



PUMPING PLAN

SHIP N°
1316

SCALE: 3/8 IN = 1 FT



6 NOV 1945

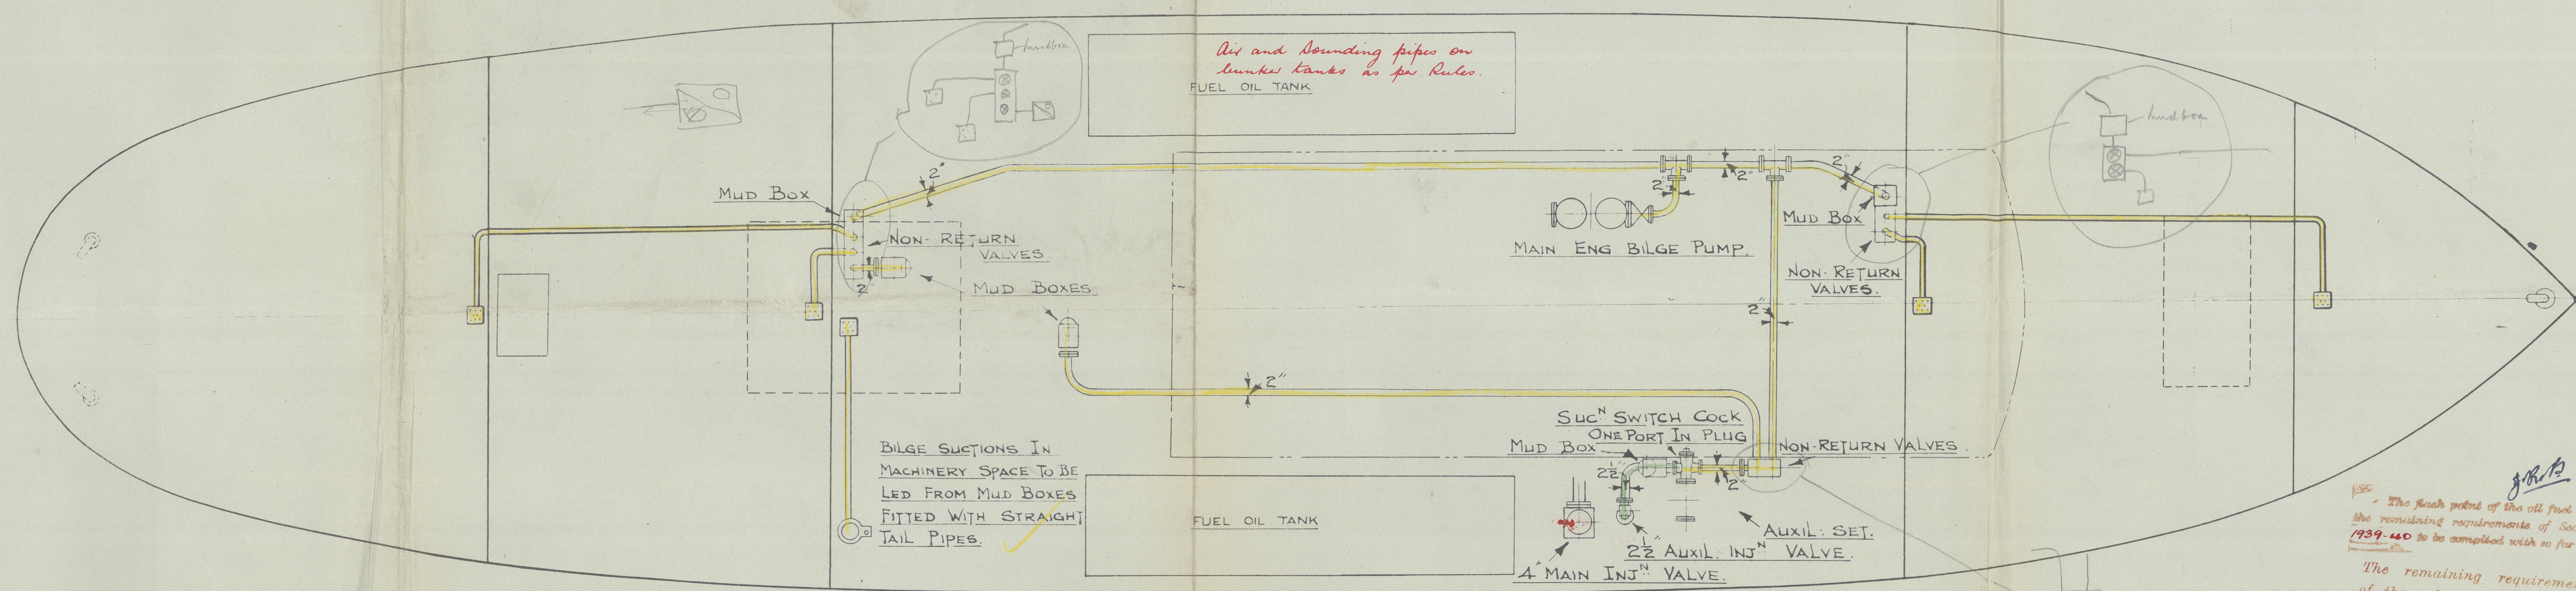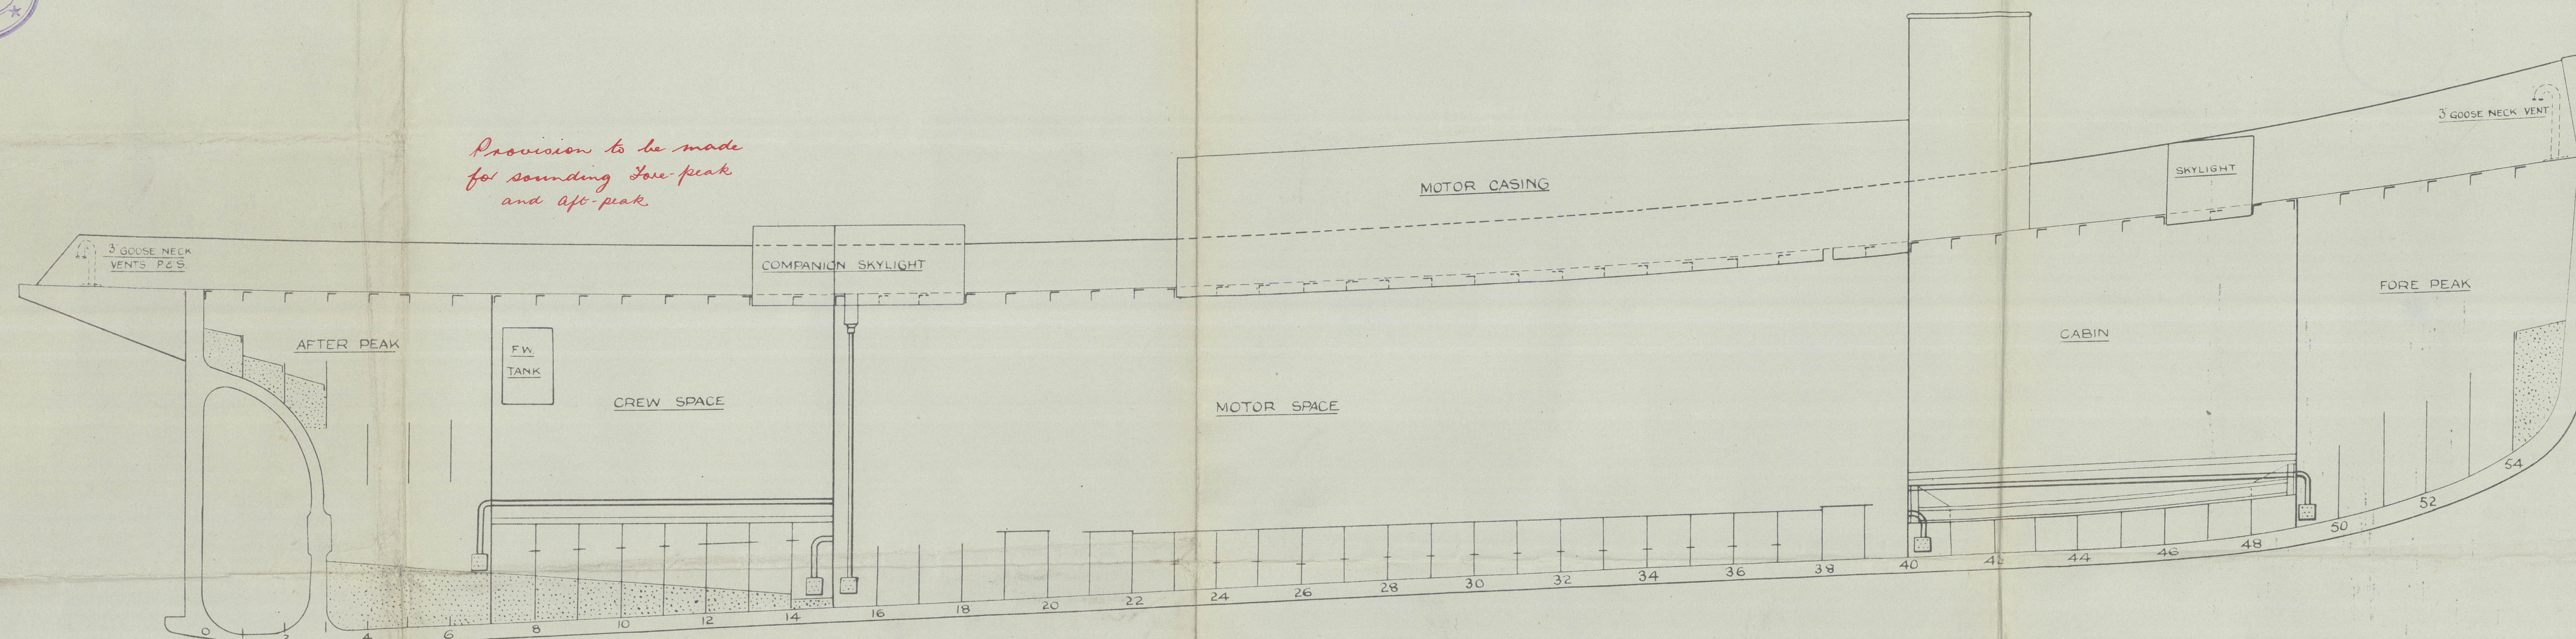

Pumps on bilge service to be of self priming type, & capacity as per section 34, cl 4(b)

The final point of the oil fuel to be above 150°F, and the remaining requirements of Section 20 of the Rules 1939-40 to be complied with so far as they are applicable.

The remaining requirements of section 34 of the rules 1939-40 to be complied with so far as they are applicable.


2. 11. 45

"FOSSA" *

Pumping

Hul rept-No. 53633.

Cochrane Yd. No. 1316

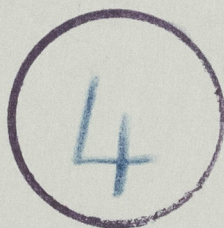

© 2020

Lloyd's Register
Foundation

007958-007966-0229