

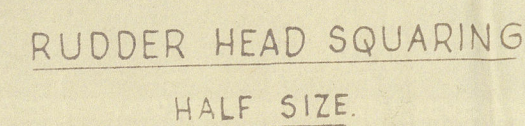


SPEED NOT EXCEEDING 10 KNOTS

SCALE - 1 IN. = 1 FT.

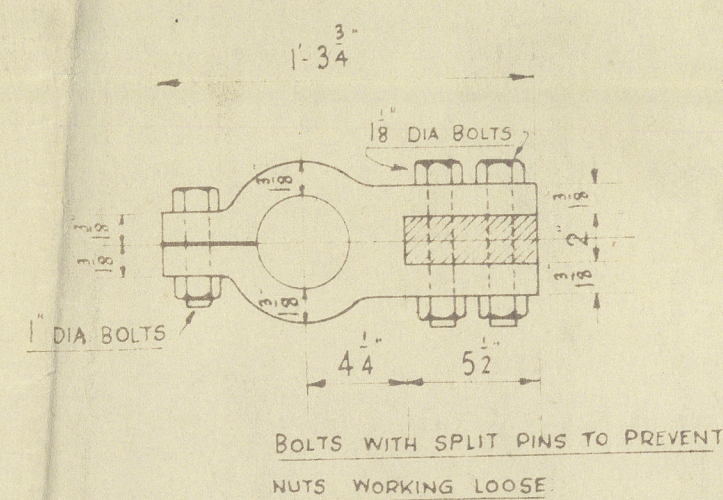

RUDDER STOPPERS FITTED ON DECK ONLY.

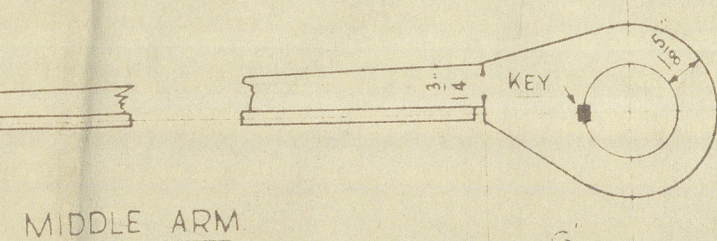


RUDDER CLAMPS

SHIP № 1316.
STERN - FRAME.

FORGED IRON
TO LLOYDS TESTS

SCALE - 1 IN. = 1 FT

HAND TILLER

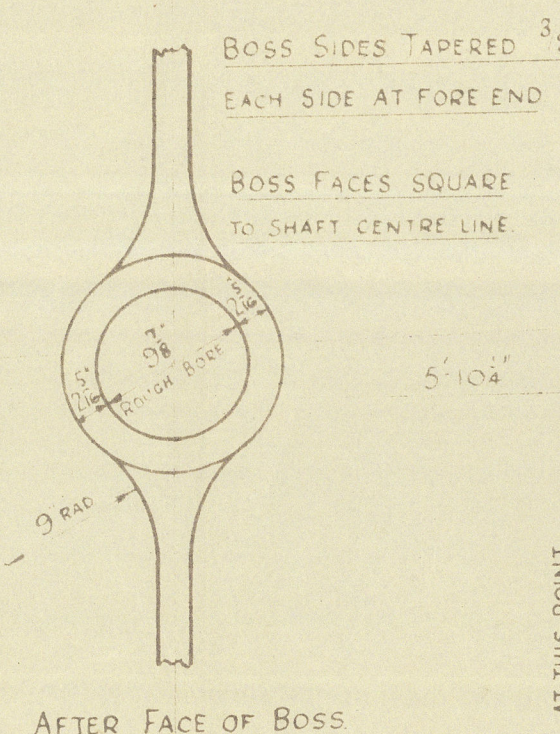STEERING GEAR TILLER

SHAFT RISES FROM
STERN FRAME BOSS TO
FORD 2.135 INCHES IN 5'10 1/4"

Ad
26.7.45

D. 426

"FOSSA" * Hul rept No. 53633

Rudder & Stemframe

Cochran Yd. No. 1316

3



© 2020

Lloyd's Register
Foundation

007958-007966-0230