



PROFILE & DECK PLAN

STEEL SCREW MOTOR TUG


70'-0" B.P. - 17'-0" MLD - 8'-6" MLD.

TO CLASS 100A "FOR TOWING SERVICES ON THE RIVER THAMES"

SCALE: $\frac{3}{8}'' = 1'-0''$

SHIP No 1316.

PILLARING THROUGHOUT TO SURVEYOR'S SATISFACTION
BULKHEADS STIFFENED TO SURVEYOR'S SATISFACTION

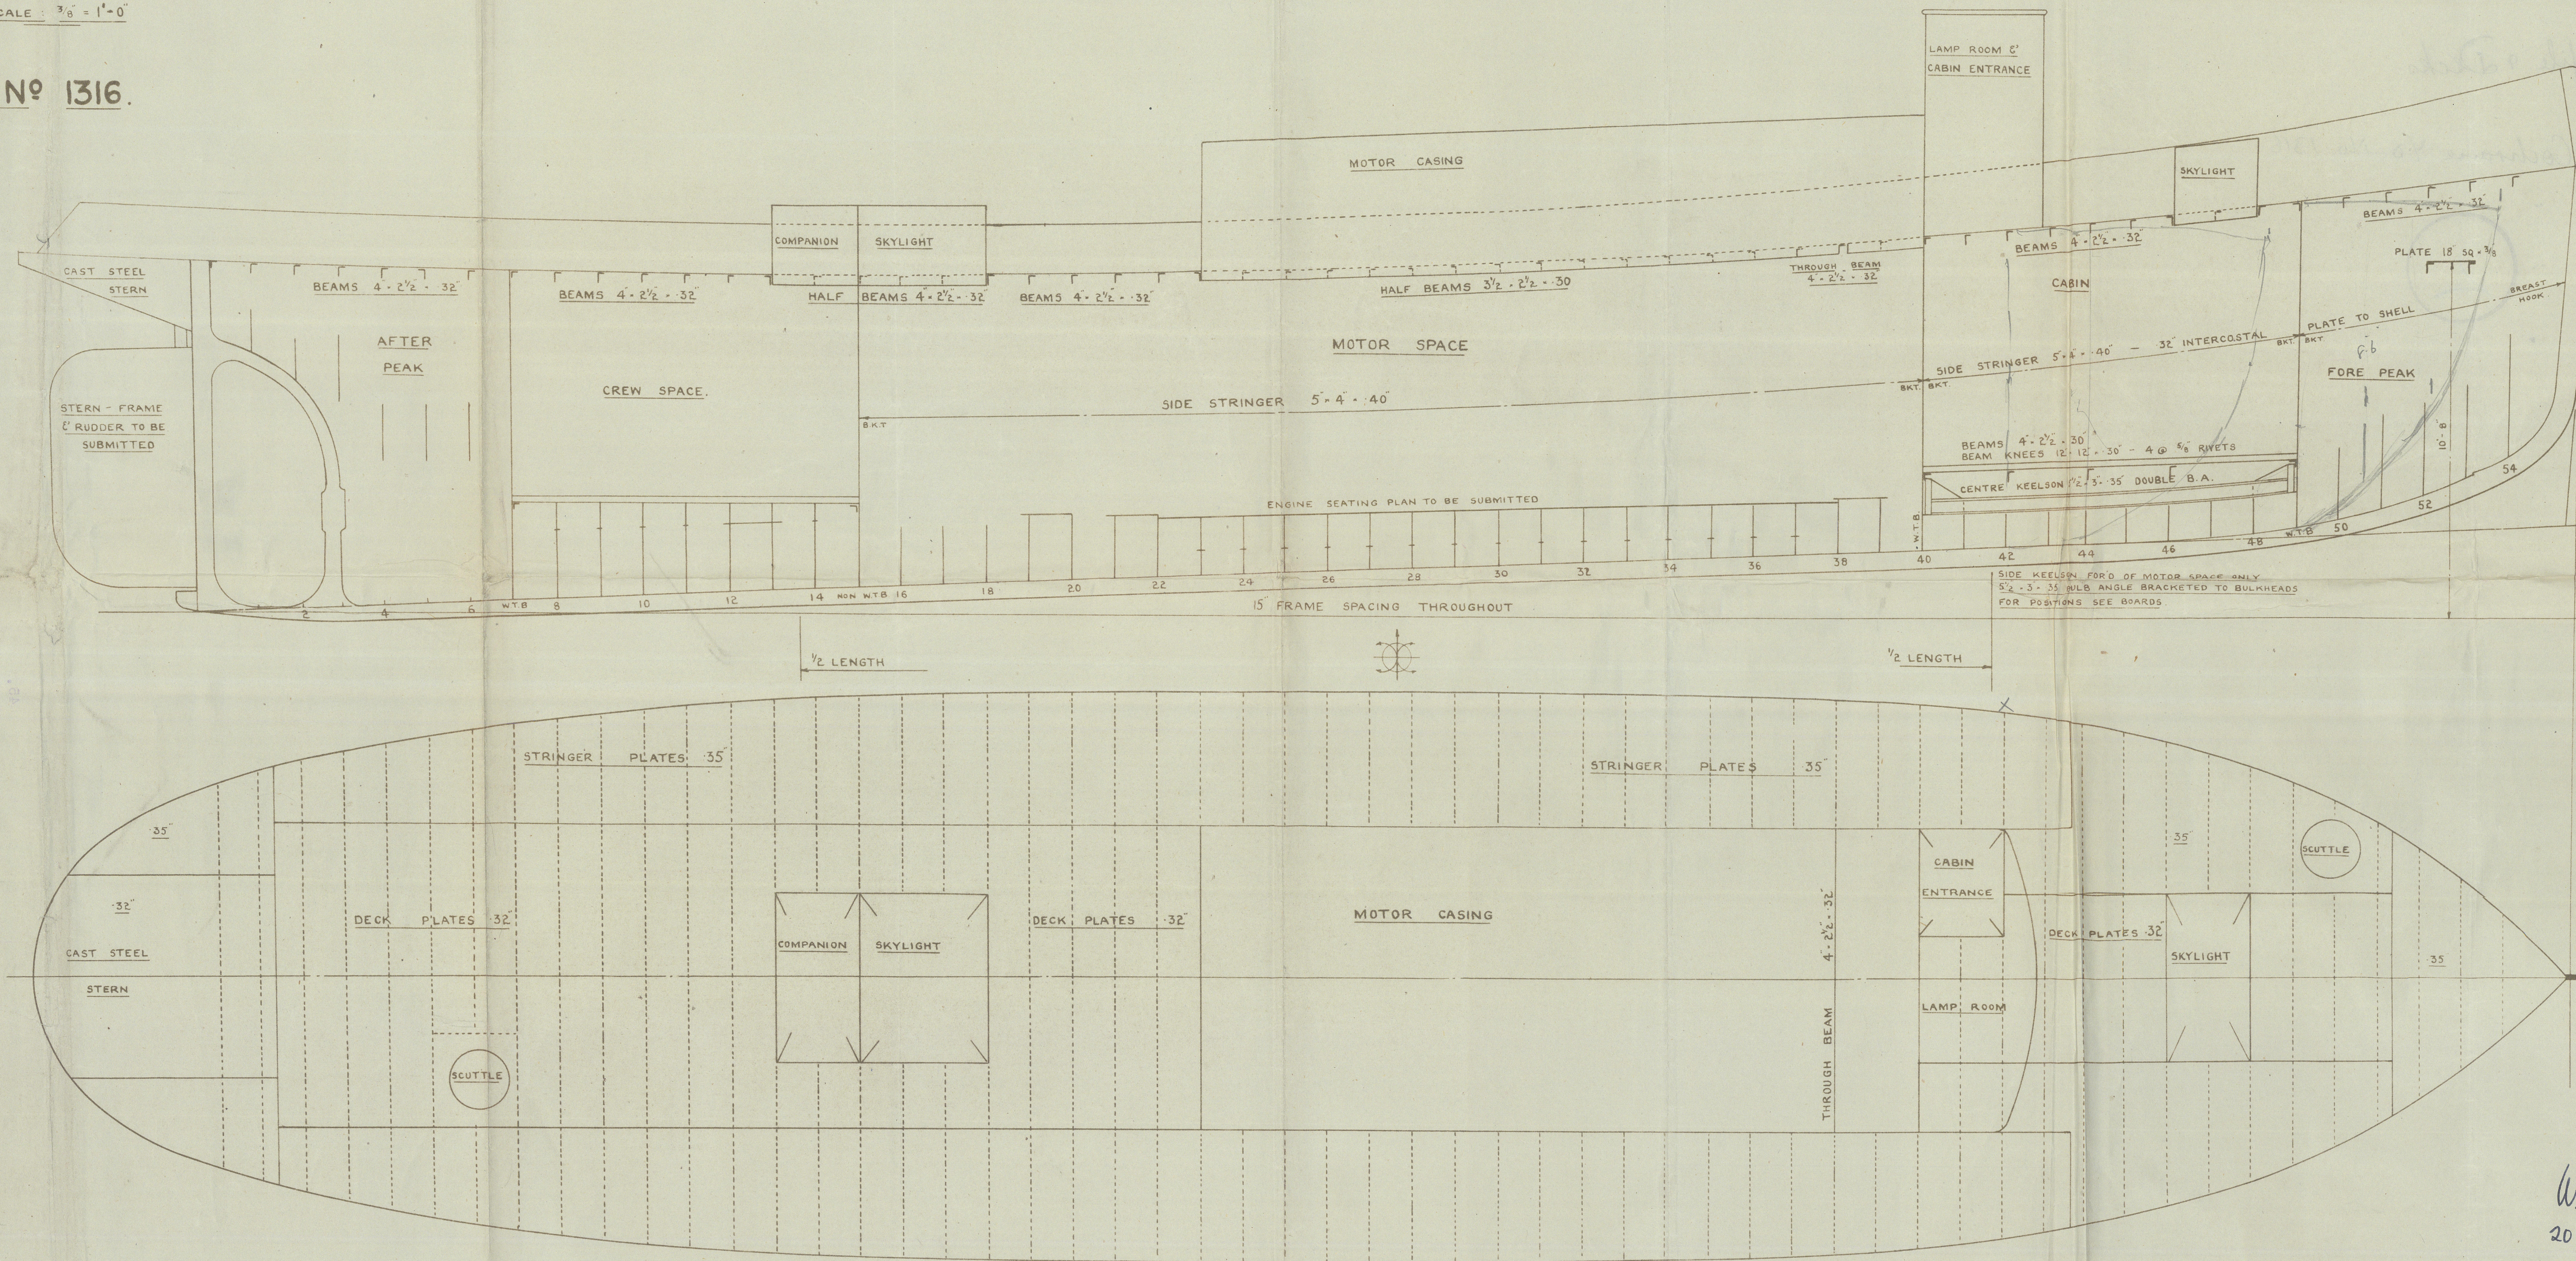

GUNWALE BAR FITTED ON UNDERSIDE OF DECK
FRAMES & BEAMS CUT SHORT SEE MIDSHIP SECTION

W.J.
20.8.45

"FOSSA" * Hurl rept No. 53633.

Profile & Decks.

Cochrane Y.D. No. 1316

2



© 2020

Lloyd's Register
Foundation

007958-007966-0232