


Verijdel copie of approved plans.
See letter 26/7/46.

ROER EN ACHTERSTEVEN

1/2 ZEELICHTER „VAN GELDER“

SCHAAL 1:10

SCHAAL 1:4.

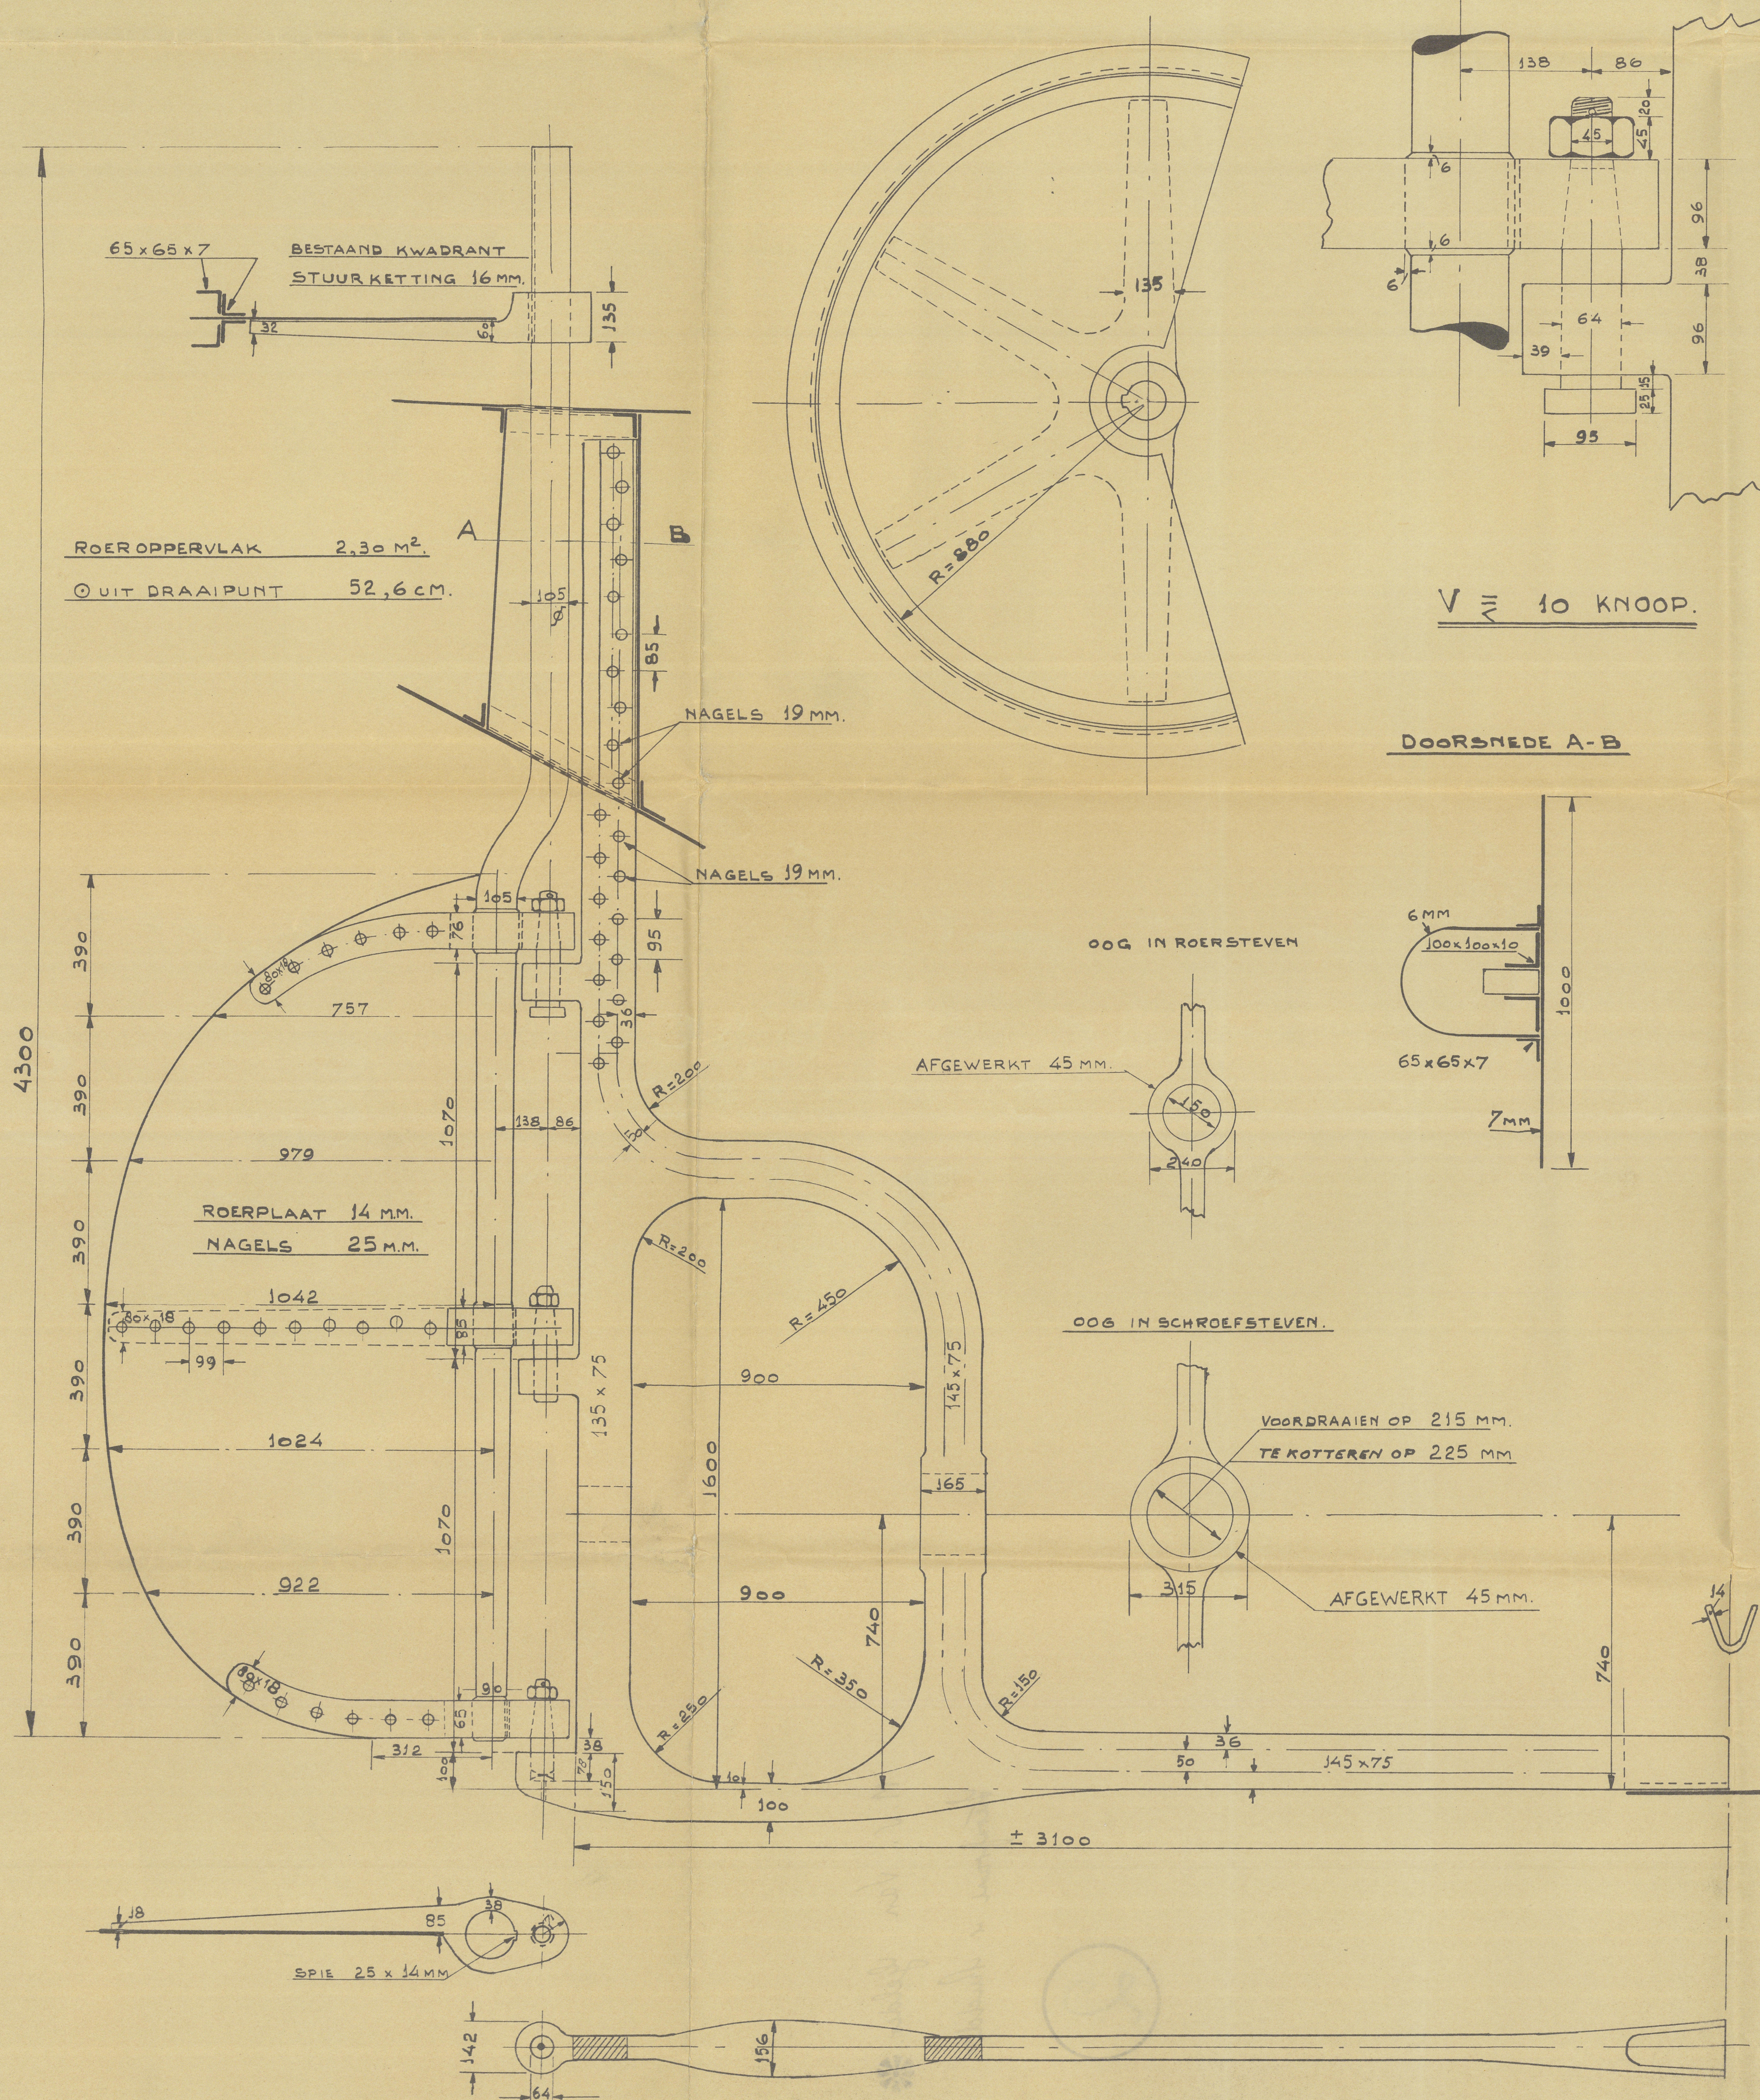

M. V. Van Gelder. *

Stonfram & Snidder.

2



© 2020

Lloyd's Register
Foundation

007958-007966-0287